


STA. 52+50.00 TO STA. 54+00.00

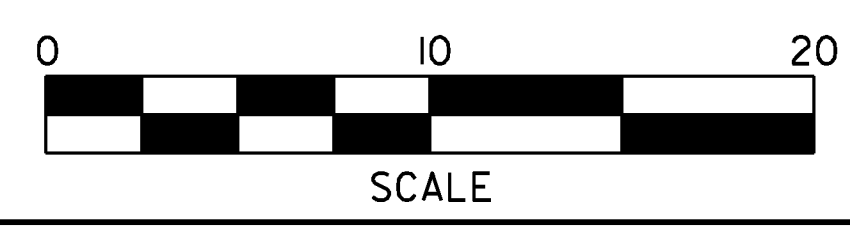

**FLETCHER
CROSS
SECTIONS
SHEET #20**

PROJECT NAME: CAMBRIDGE-BAKERSFIELD	PLOT DATE: 11/15/2012
PROJECT NUMBER: STP 2926(I)	DRAWN BY: STANTEC
FILE NAME: p10b258.dgn	CHECKED BY: STANTEC
DESIGNED BY: STANTEC	SHEET 242 OF 387
IPARM FILE: p10b258xs20.i	