


STA. 61+00.00 TO STA. 62+50.00

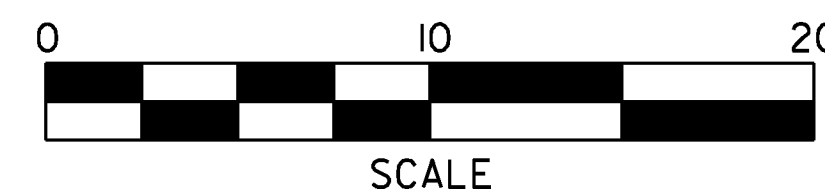

**FLETCHER  
CROSS  
SECTIONS  
SHEET #24**

PROJECT NAME: CAMBRIDGE-BAKERSFIELD  
PROJECT NUMBER: STP 2926(I)

FILE NAME: p10b258.dgn  
PROJECT LEADER: JLL  
DESIGNED BY: STANTEC  
IPARM FILE: p10b258xs24.i

PLOT DATE: 11/15/2012  
DRAWN BY: STANTEC  
CHECKED BY: STANTEC  
SHEET 246 OF 387