


STA. 63+00.00 TO STA. 64+50.00

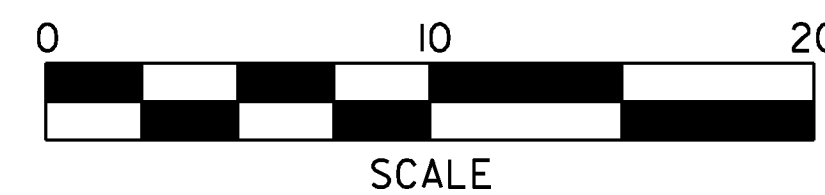

**FLETCHER
CROSS
SECTIONS
SHEET #25**

PROJECT NAME: CAMBRIDGE-BAKERSFIELD
PROJECT NUMBER: STP 2926(I)

FILE NAME: p10b258.dgn
PROJECT LEADER: JLL
DESIGNED BY: STANTEC
IPARM FILE: p10b258xs25.i

PLOT DATE: 11/15/2012
DRAWN BY: STANTEC
CHECKED BY: STANTEC
SHEET 247 OF 387