


FLETCHER STA. 80+89.33
 STOP FLETCHER STP 027-1 (22)
 RESUME STP 2926 (1)

STA. 81+00.00 TO STA. 82+00.00

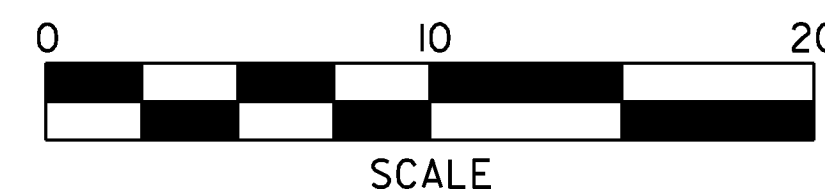

**FLETCHER
 CROSS
 SECTIONS
 SHEET #32**

PROJECT NAME: CAMBRIDGE-BAKERSFIELD
 PROJECT NUMBER: STP 2926(1)

FILE NAME: p10b258.dgn
 PROJECT LEADER: JLL
 DESIGNED BY: STANTEC
 IPARM FILE: p10b258xs32.i

PLOT DATE: 11/15/2012
 DRAWN BY: STANTEC
 CHECKED BY: STANTEC
 SHEET 254 OF 387