


STA. 84+50.00 TO STA. 86+00.00

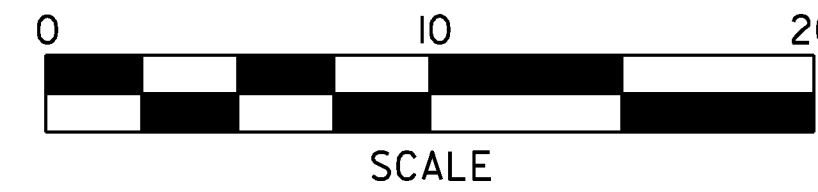

**FLETCHER  
CROSS  
SECTIONS  
SHEET #34**

PROJECT NAME: CAMBRIDGE-BAKERSFIELD	PLOT DATE: 11/15/2012
PROJECT NUMBER: STP 2926(1)	DRAWN BY: STANTEC
FILE NAME: p10b258.dgn	CHECKED BY: STANTEC
PROJECT LEADER: JLL	SHEET 256 OF 387
DESIGNED BY: STANTEC	
IPARM FILE: p10b258xs34.i	