


STA. 121+00.00 TO STA. 123+00.00

FLETCHER 120+82.33
 END FLETCHER STP 027-1 (22)
 RESUME STP 2926 (1)

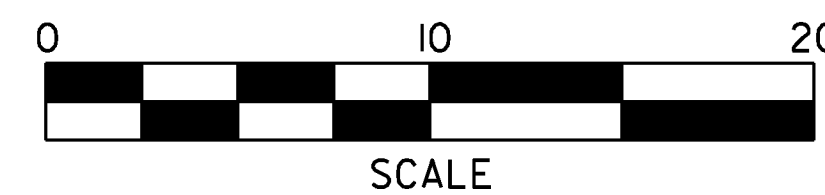

**FLETCHER
 CROSS
 SECTIONS
 SHEET #48**

PROJECT NAME: CAMBRIDGE-BAKERSFIELD
 PROJECT NUMBER: STP 2926(I)

FILE NAME: p10b258.dgn
 PROJECT LEADER: JLL
 DESIGNED BY: STANTEC
 IPARM FILE: p10b258xs48.i

PLOT DATE: 11/15/2012
 DRAWN BY: STANTEC
 CHECKED BY: STANTEC
 SHEET 270 OF 387