


STA. 3+00.00 TO STA. 5+50.00

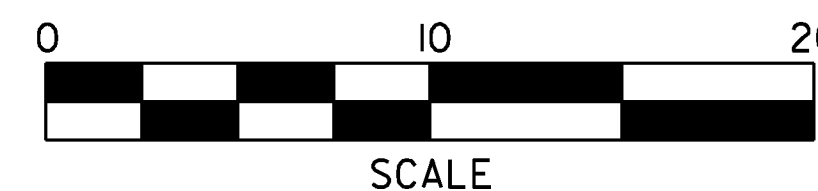

BAKERSFIELD CROSS SECTIONS SHEET #2	PROJECT NAME: CAMBRIDGE-BAKERSFIELD	PLOT DATE: 11/15/2012
	PROJECT NUMBER: STP 2926(1)	DRAWN BY: STANTEC
	FILE NAME: p10b258.dgn	CHECKED BY: STANTEC
	DESIGNED BY: STANTEC	SHEET 272 OF 387
IPARM FILE: p10b258xs02.i		