


STA. 18+00.00 TO STA. 20+00.00

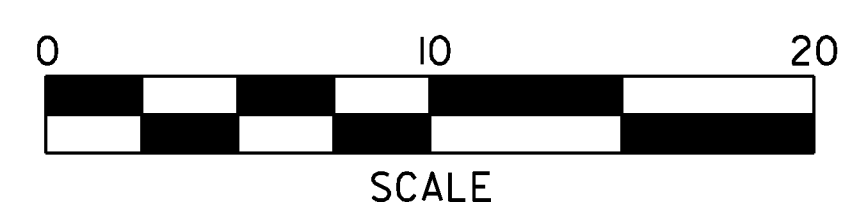

**BAKERSFIELD
CROSS
SECTIONS
SHEET #8**

PROJECT NAME: CAMBRIDGE-BAKERSFIELD	PLOT DATE: 11/15/2012
PROJECT NUMBER: STP 2926(I)	DRAWN BY: STANTEC
FILE NAME: p10b258.dgn	CHECKED BY: STANTEC
PROJECT LEADER: JLL	SHEET 278 OF 387
DESIGNED BY: STANTEC	
IPARM FILE: p10b258xs08.i	