


STA. 20+50.00 TO STA. 23+00.00

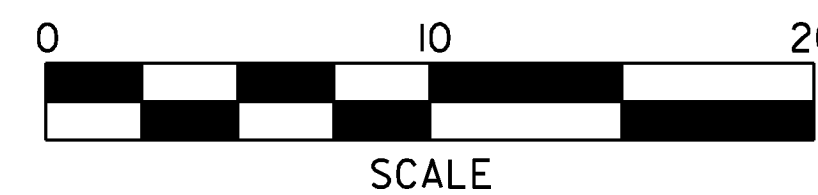

**BAKERSFIELD  
CROSS  
SECTIONS  
SHEET #9**

PROJECT NAME:	CAMBRIDGE-BAKERSFIELD
PROJECT NUMBER:	STP 2926(I)
FILE NAME:	p10b258.dgn
PROJECT LEADER:	JLL
DESIGNED BY:	STANTEC
IPARM FILE:	p10b258xs09.i
PLOT DATE:	11/15/2012
DRAWN BY:	STANTEC
CHECKED BY:	STANTEC
SHEET	279 OF 387