


STA. 37+00.00 TO STA. 38+50.00

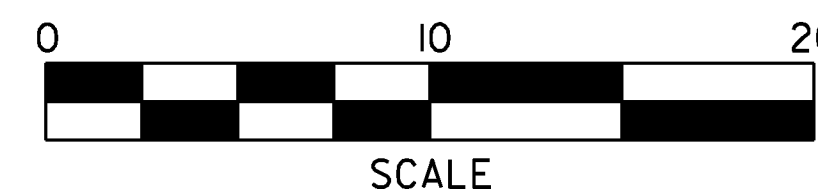

**BAKERSFIELD
CROSS
SECTIONS
SHEET #16**

PROJECT NAME: CAMBRIDGE-BAKERSFIELD	PLOT DATE: 11/15/2012
PROJECT NUMBER: STP 2926(I)	DRAWN BY: STANTEC
FILE NAME: p10b258.dgn	CHECKED BY: STANTEC
DESIGNED BY: STANTEC	SHEET 286 OF 387
IPARM FILE: p10b258xs16.i	