


STA. 60+50.00 TO STA. 62+50.00

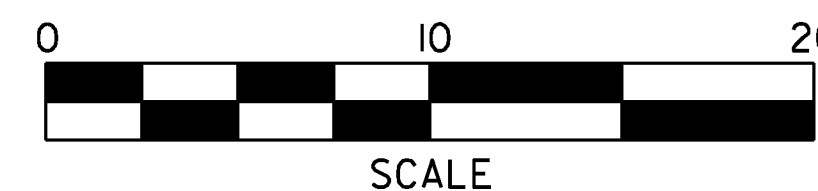

**BAKERSFIELD
CROSS
SECTIONS
SHEET #25**

PROJECT NAME: CAMBRIDGE-BAKERSFIELD	PLOT DATE: 11/15/2012
PROJECT NUMBER: STP 2926(1)	DRAWN BY: STANTEC
FILE NAME: p10b258.dgn	CHECKED BY: STANTEC
PROJECT LEADER: JLL	SHEET 295 OF 387
DESIGNED BY: STANTEC	
IPARM FILE: p10b258xs25.i	