


STA. 83+50.00 TO STA. 85+50.00

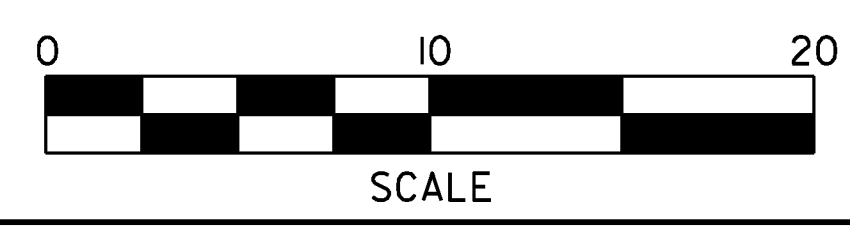

BAKERSFIELD CROSS SECTIONS SHEET #35		PROJECT NAME: CAMBRIDGE-BAKERSFIELD	PLOT DATE: 11/15/2012
		PROJECT NUMBER: STP 2926(I)	DRAWN BY: STANTEC
FILE NAME: p10b258.dgn	DESIGNED BY: STANTEC	CHECKED BY: STANTEC	SHEET 305 OF 387
IPARM FILE: p10b258xs35.i			