


STA. 102+00.00 TO STA. 104+00.00

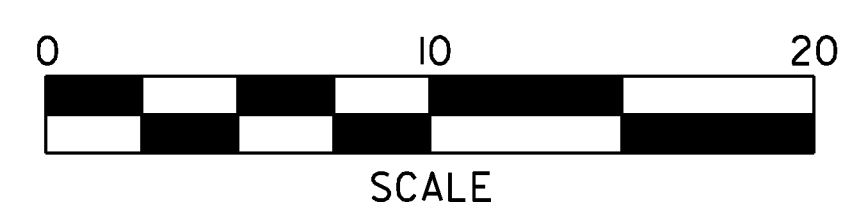

**BAKERSFIELD
CROSS
SECTIONS
SHEET #43**

PROJECT NAME:	CAMBRIDGE-BAKERSFIELD
PROJECT NUMBER:	STP 2926(I)
FILE NAME:	p10b258.dgn
PROJECT LEADER:	JLL
DESIGNED BY:	STANTEC
IPARM FILE:	p10b258xs43.i
PLOT DATE:	11/15/2012
DRAWN BY:	STANTEC
CHECKED BY:	STANTEC
SHEET	313 OF 387