


STA. 116+00.00 TO STA. 118+50.00

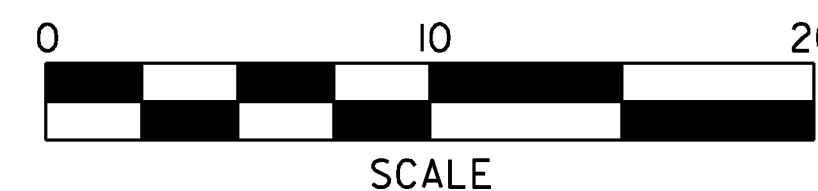

**BAKERSFIELD
CROSS
SECTIONS
SHEET #49**

PROJECT NAME: CAMBRIDGE-BAKERSFIELD	PLOT DATE: 11/15/2012
PROJECT NUMBER: STP 2926(I)	DRAWN BY: STANTEC
FILE NAME: p10b258.dgn	CHECKED BY: STANTEC
PROJECT LEADER: JLL	SHEET 319 OF 387
DESIGNED BY: STANTEC	
IPARM FILE: p10b258xs49.i	