


STA. 130+00.00 TO STA. 131+50.00

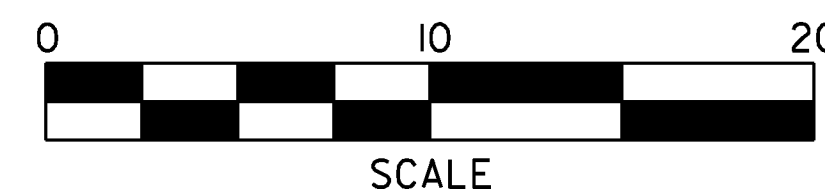

<b>BAKERSFIELD CROSS SECTIONS SHEET #55</b>	PROJECT NAME: CAMBRIDGE-BAKERSFIELD	PLOT DATE: 11/15/2012
	PROJECT NUMBER: STP 2926(1)	DRAWN BY: STANTEC
	FILE NAME: p10b258.dgn	CHECKED BY: STANTEC
	DESIGNED BY: STANTEC	SHEET 325 OF 387
	IPARM FILE: p10b258xs55.i	