


STA. 168+50.00 TO STA. 171+00.00

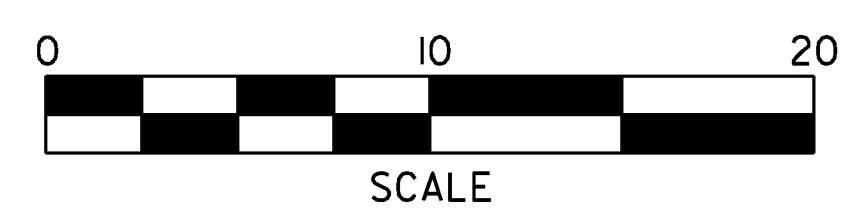

**BAKERSFIELD  
CROSS  
SECTIONS  
SHEET #72**

PROJECT NAME: CAMBRIDGE-BAKERSFIELD	PLOT DATE: 11/15/2012
PROJECT NUMBER: STP 2926(I)	DRAWN BY: STANTEC
FILE NAME: p10b258.dgn	CHECKED BY: STANTEC
DESIGNED BY: STANTEC	SHEET 342 OF 387
IPARM FILE: p10b258xs72.i	