

STONE FILL, TYPE J
 STA. 114+29 TO 114+35, LT
 STA. 114+52 TO 114+85, LT
 STA. 115+33 TO 116+17, LT

STEEL BEAM GUARDRAIL, GALVANIZED
 STA. 112+82 TO 116+50, RT
 STA. 113+54 TO 116+50, LT

ANCHOR FOR STEEL BEAM RAIL
 STA. 112+82, RT
 STA. 113+54, LT

REMOVAL AND DISPOSAL OF GUARDRAIL
 STA. 112+82 TO 116+50, RT
 STA. 113+54 TO 116+50, LT

DURABLE 4 INCH WHITE LINE
 (ALL LINES WILL INCLUDE EDGE LINE BREAKS AND
 RADII FOR SIDE ROADS)
 STA. 112+50 TO 116+50, SOLID LT & RT

DURABLE 4 INCH YELLOW LINE
 (ALL LINES WILL INCLUDE C BREAKS FOR SIDE ROADS)
 STA. 112+50 TO 116+50, SOLID LT & RT


TEMPORARY 4 INCH WHITE LINE, PAINT
 (ALL LINES WILL INCLUDE EDGE LINE BREAKS AND
 RADII FOR SIDE ROADS)
 STA. 112+50 TO 116+50, SOLID LT & RT

TEMPORARY 4 INCH YELLOW LINE, PAINT
 (ALL LINES WILL INCLUDE C BREAKS FOR SIDE ROADS)
 STA. 112+50 TO 116+50, SOLID LT & RT

GEOTEXTILE UNDER STONE FILL
 STA. 114+29 TO 114+35, LT
 STA. 114+52 TO 114+85, LT
 STA. 115+33 TO 116+17, LT

REMOVING SIGNS
 AS SHOWN - 3

GRUBBING MATERIAL
 STA. 114+29 TO 114+35, LT
 STA. 114+52 TO 114+85, LT
 STA. 115+33 TO 116+17, LT

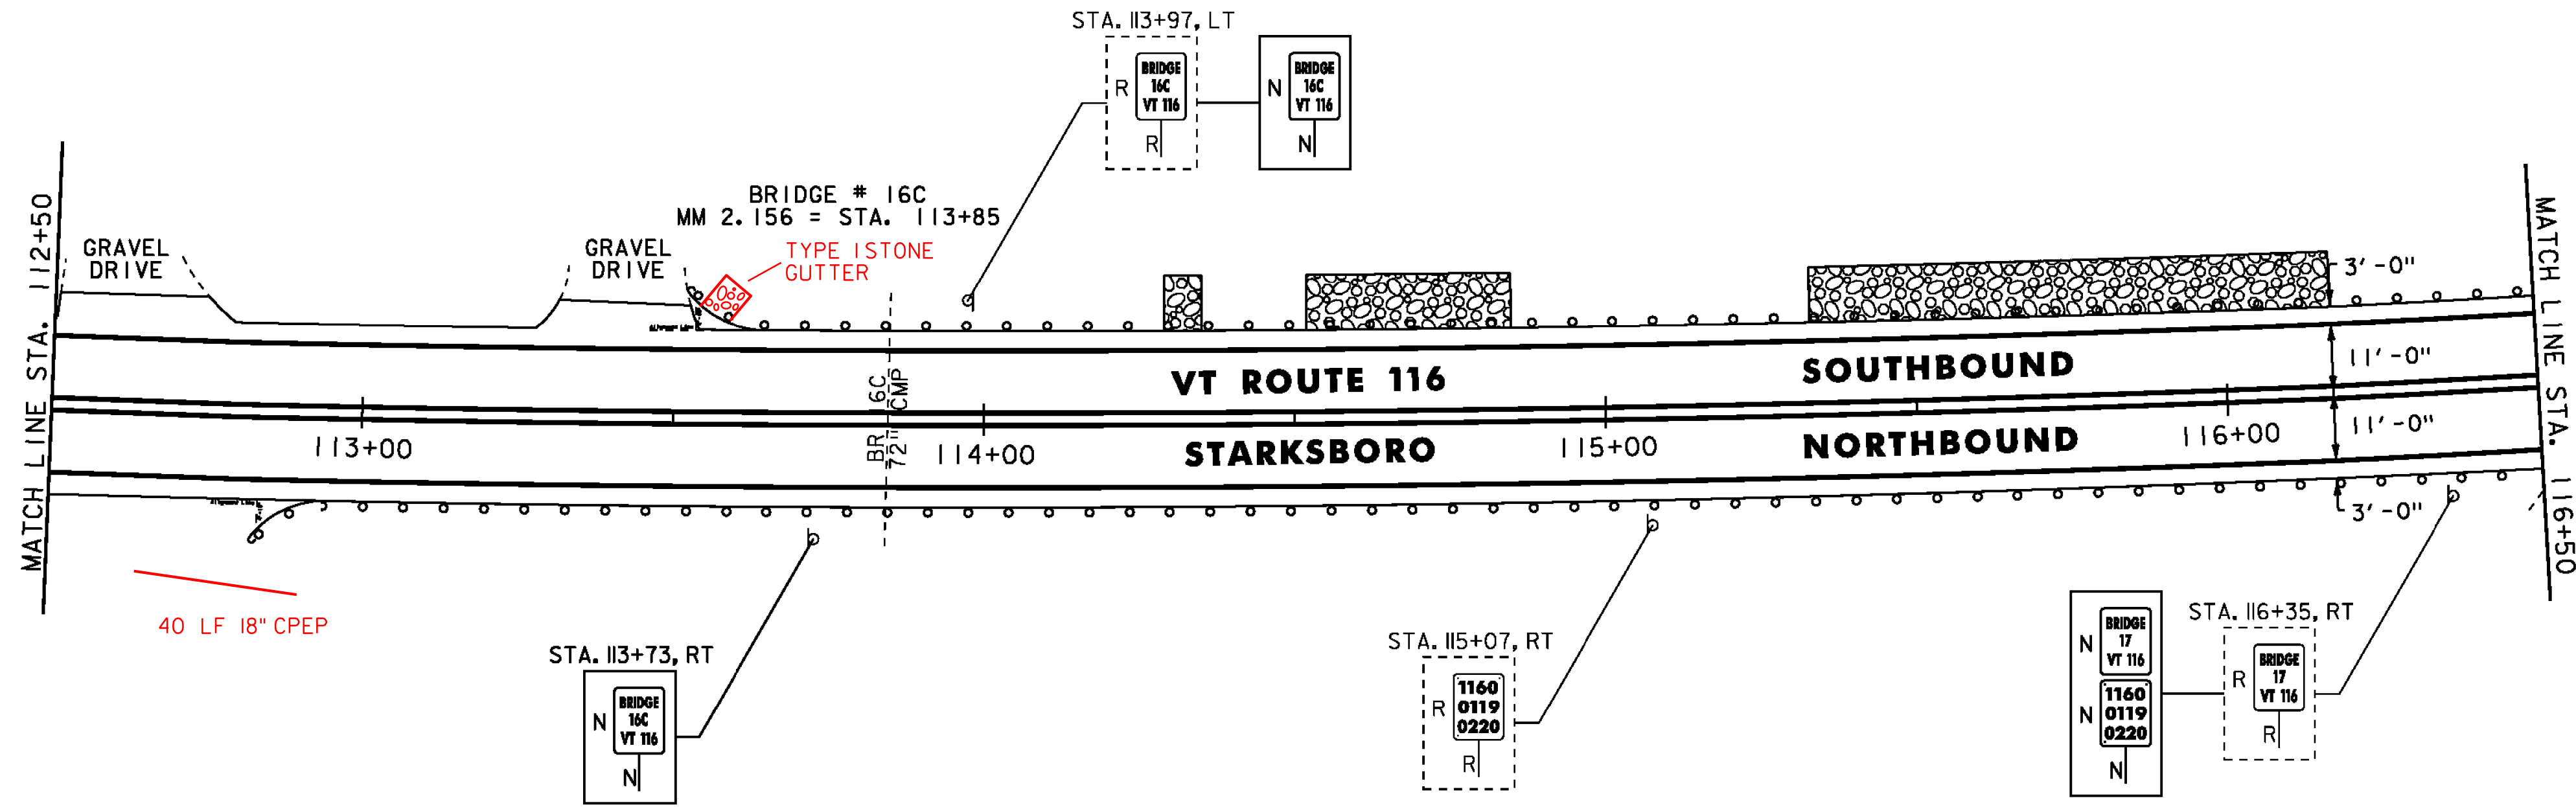

STEEL BEAM GUARDRAIL, GALVANIZED
 STA. 116+50 TO 118+44.5, RT
 STA. 116+50 TO 117+91.5, LT

ANCHOR FOR STEEL BEAM RAIL
 STA. 117+91.5, LT
 STA. 118+44.5, RT

REMOVAL AND DISPOSAL OF GUARDRAIL
 STA. 116+50 TO 118+45, RT
 STA. 116+50 TO 117+94, LT


DURABLE 4 INCH WHITE LINE
 (ALL LINES WILL INCLUDE EDGE LINE BREAKS AND
 RADII FOR SIDE ROADS)
 STA. 116+50 TO 121+50, SOLID LT & RT

DURABLE 4 INCH YELLOW LINE
 (ALL LINES WILL INCLUDE C BREAKS FOR SIDE ROADS)
 STA. 116+50 TO 121+50, SOLID LT & RT

TEMPORARY 4 INCH WHITE LINE, PAINT
 (ALL LINES WILL INCLUDE EDGE LINE BREAKS AND
 RADII FOR SIDE ROADS)
 STA. 116+50 TO 121+50, SOLID LT & RT

TEMPORARY 4 INCH YELLOW LINE, PAINT
 (ALL LINES WILL INCLUDE C BREAKS FOR SIDE ROADS)
 STA. 116+50 TO 121+50, SOLID LT & RT

REMOVING SIGNS
 AS SHOWN - 2

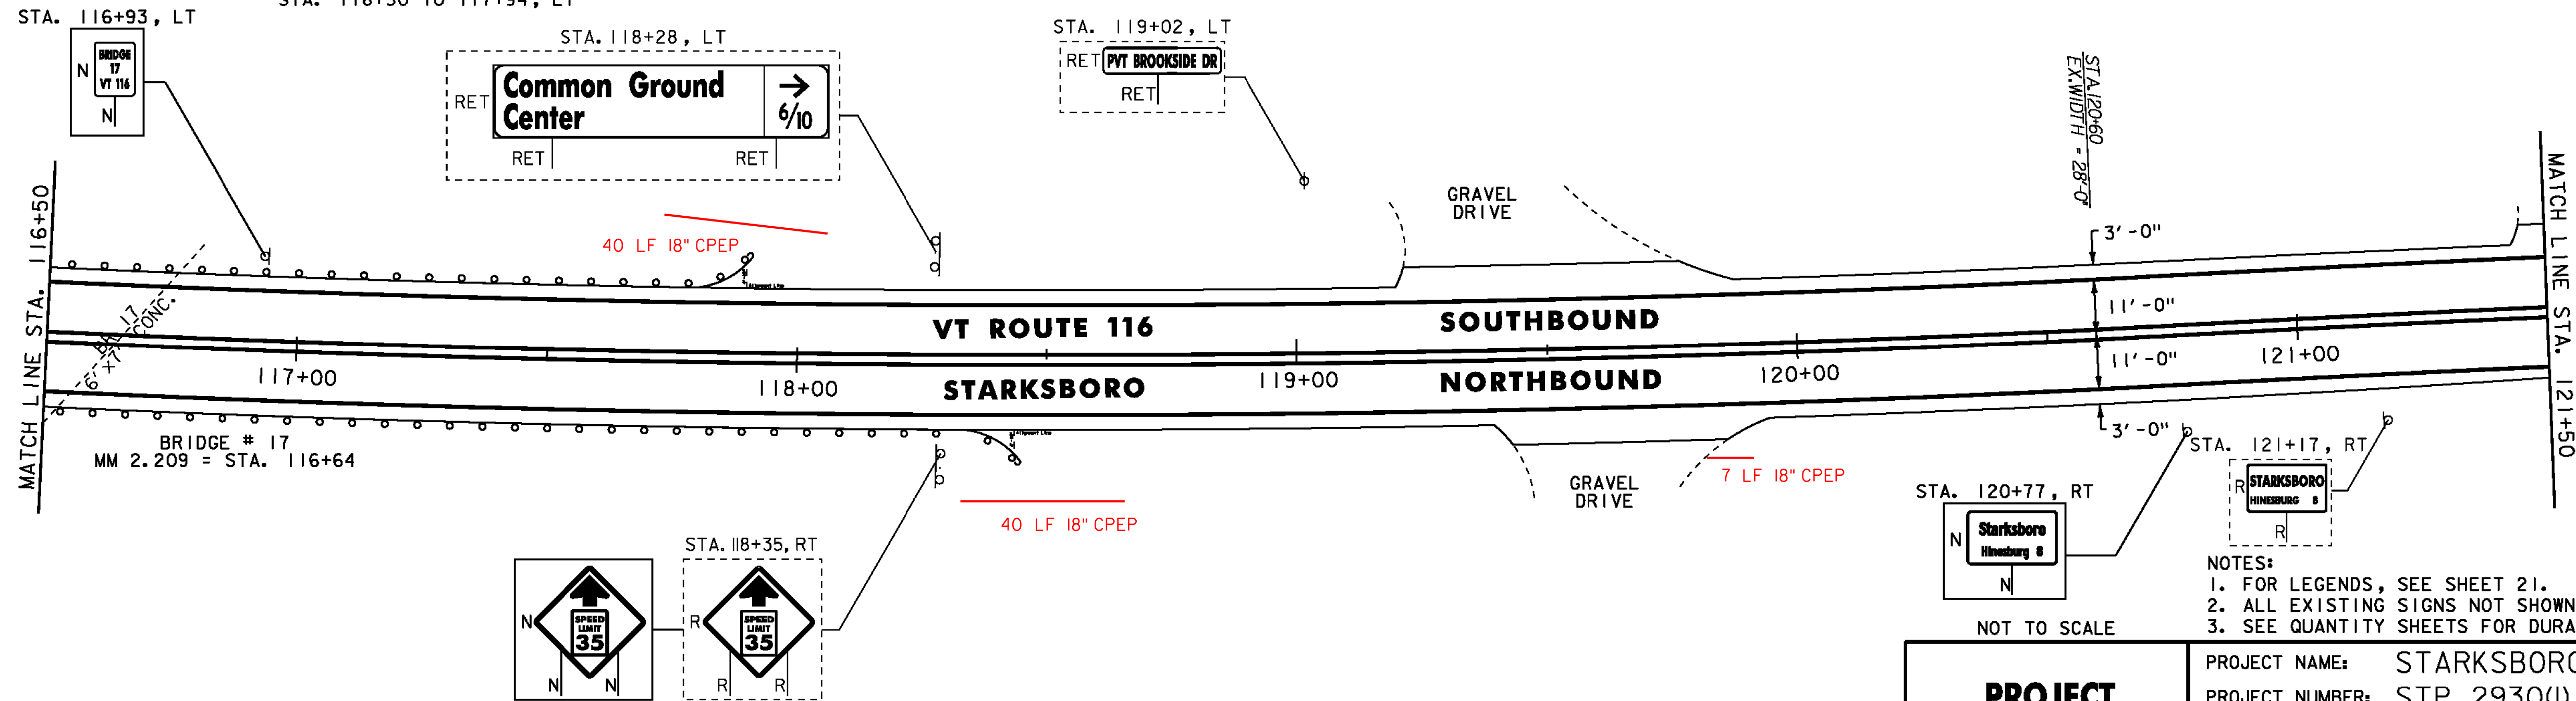

- NOTES:
1. FOR LEGENDS, SEE SHEET 21.
 2. ALL EXISTING SIGNS NOT SHOWN SHALL BE RETAINED.
 3. SEE QUANTITY SHEETS FOR DURABLE PAVEMENT MARKING OPTIONS.

NOT TO SCALE

PROJECT LAYOUT SHEET #4

PROJECT NAME: STARKSBORO-HINESBURG
 PROJECT NUMBER: STP 2930(I)

FILE NAME: p10b266.dgn
 PROJECT LEADER: JLL
 DESIGNED BY: STANTEC
 IPARM FILE: p10b266i04.i

PLOT DATE: 28-NOV-2012
 DRAWN BY: STANTEC
 CHECKED BY: MCF
 SHEET 24 OF 119

