

DURABLE 4 INCH WHITE LINE
 (ALL LINES WILL INCLUDE EDGE LINE BREAKS AND RADIi FOR SIDE ROADS)
 STA. 121+50 TO 126+50, SOLID LT & RT


DURABLE 4 INCH YELLOW LINE
 (ALL LINES WILL INCLUDE C BREAKS FOR SIDE ROADS)
 STA. 121+50 TO 126+50, SOLID LT & RT

BITUMINOUS CONCRETE GUTTERS AND TRAFFIC ISLANDS
 STA. 123+12 TO 123+85, LT
 FOR DETAIL, SEE SHEET 19.

TEMPORARY 4 INCH WHITE LINE, PAINT
 (ALL LINES WILL INCLUDE EDGE LINE BREAKS AND RADIi FOR SIDE ROADS)
 STA. 121+50 TO 126+50, SOLID LT & RT

TEMPORARY 4 INCH YELLOW LINE, PAINT
 (ALL LINES WILL INCLUDE C BREAKS FOR SIDE ROADS)
 STA. 121+50 TO 126+50, SOLID LT & RT

REMOVING SIGNS
 AS SHOWN - 3

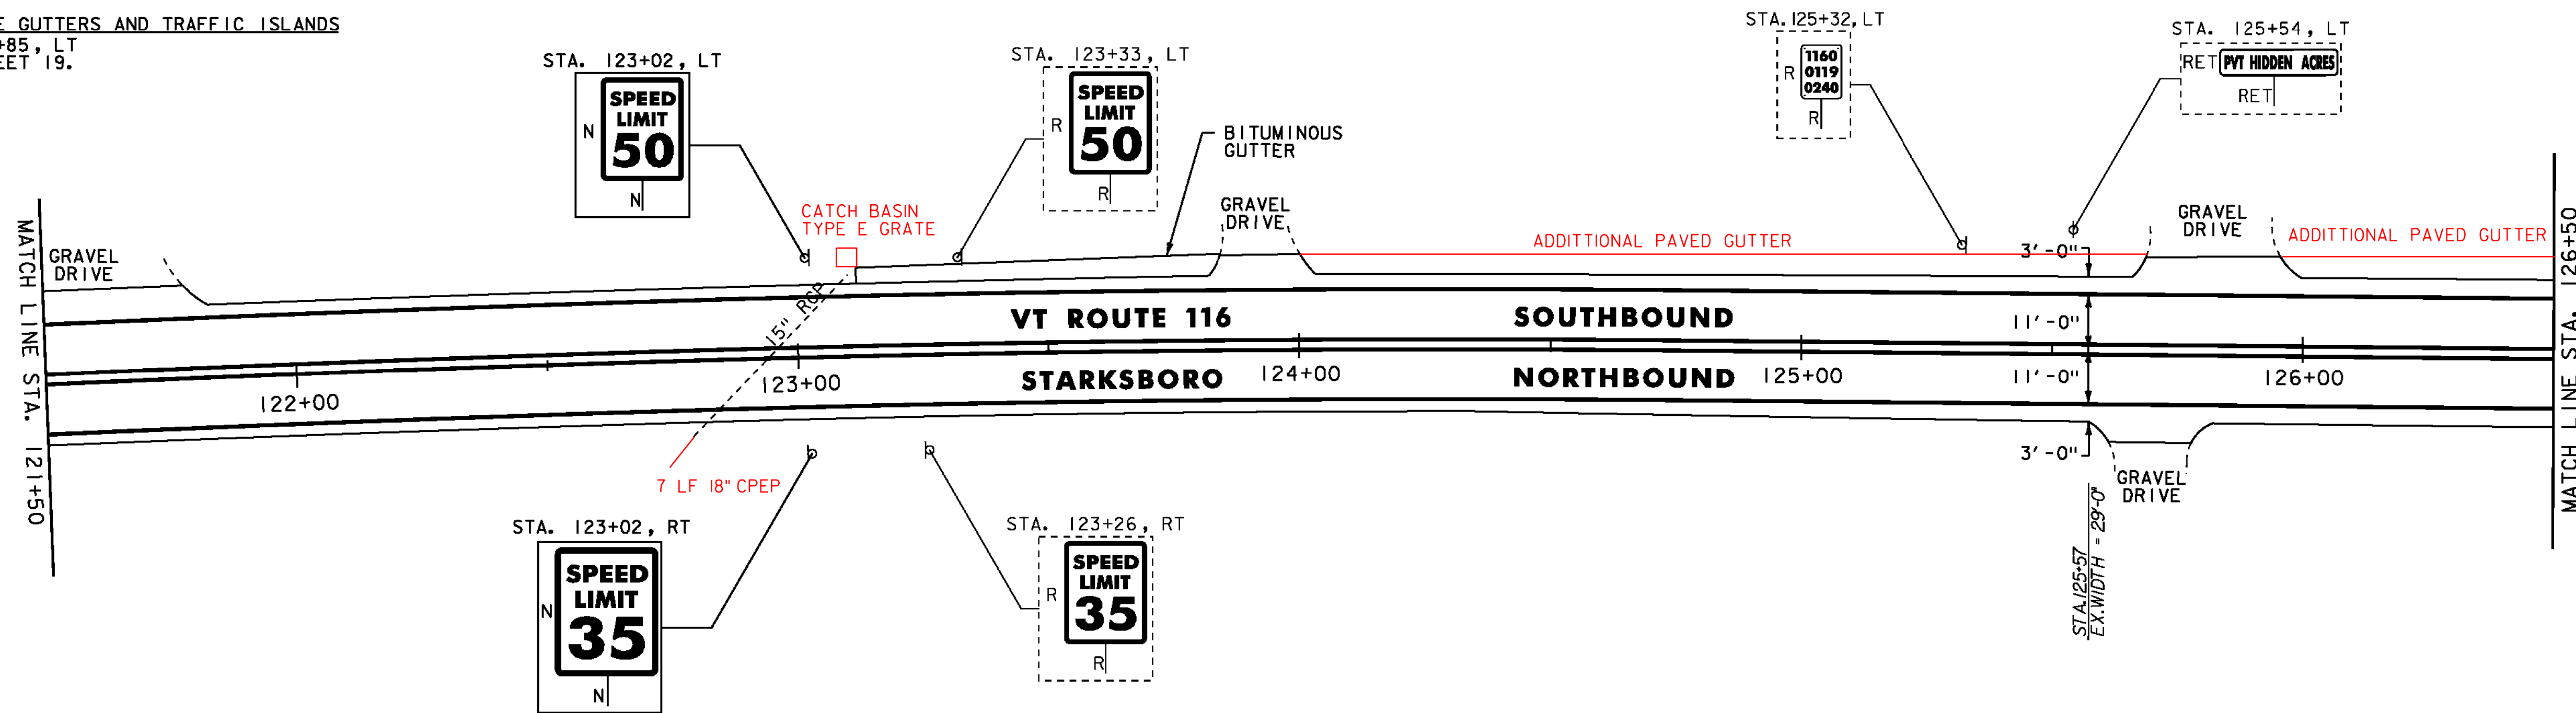


DURABLE 4 INCH WHITE LINE
 (ALL LINES WILL INCLUDE EDGE LINE BREAKS AND RADIi FOR SIDE ROADS)
 STA. 126+50 TO 131+50, SOLID LT & RT

DURABLE 4 INCH YELLOW LINE
 (ALL LINES WILL INCLUDE C BREAKS FOR SIDE ROADS)
 STA. 126+50 TO 131+50, SOLID LT & RT

TEMPORARY 4 INCH WHITE LINE, PAINT
 (ALL LINES WILL INCLUDE EDGE LINE BREAKS AND RADIi FOR SIDE ROADS)
 STA. 126+50 TO 131+50, SOLID LT & RT

TEMPORARY 4 INCH YELLOW LINE, PAINT
 (ALL LINES WILL INCLUDE C BREAKS FOR SIDE ROADS)
 STA. 126+50 TO 131+50, SOLID LT & RT

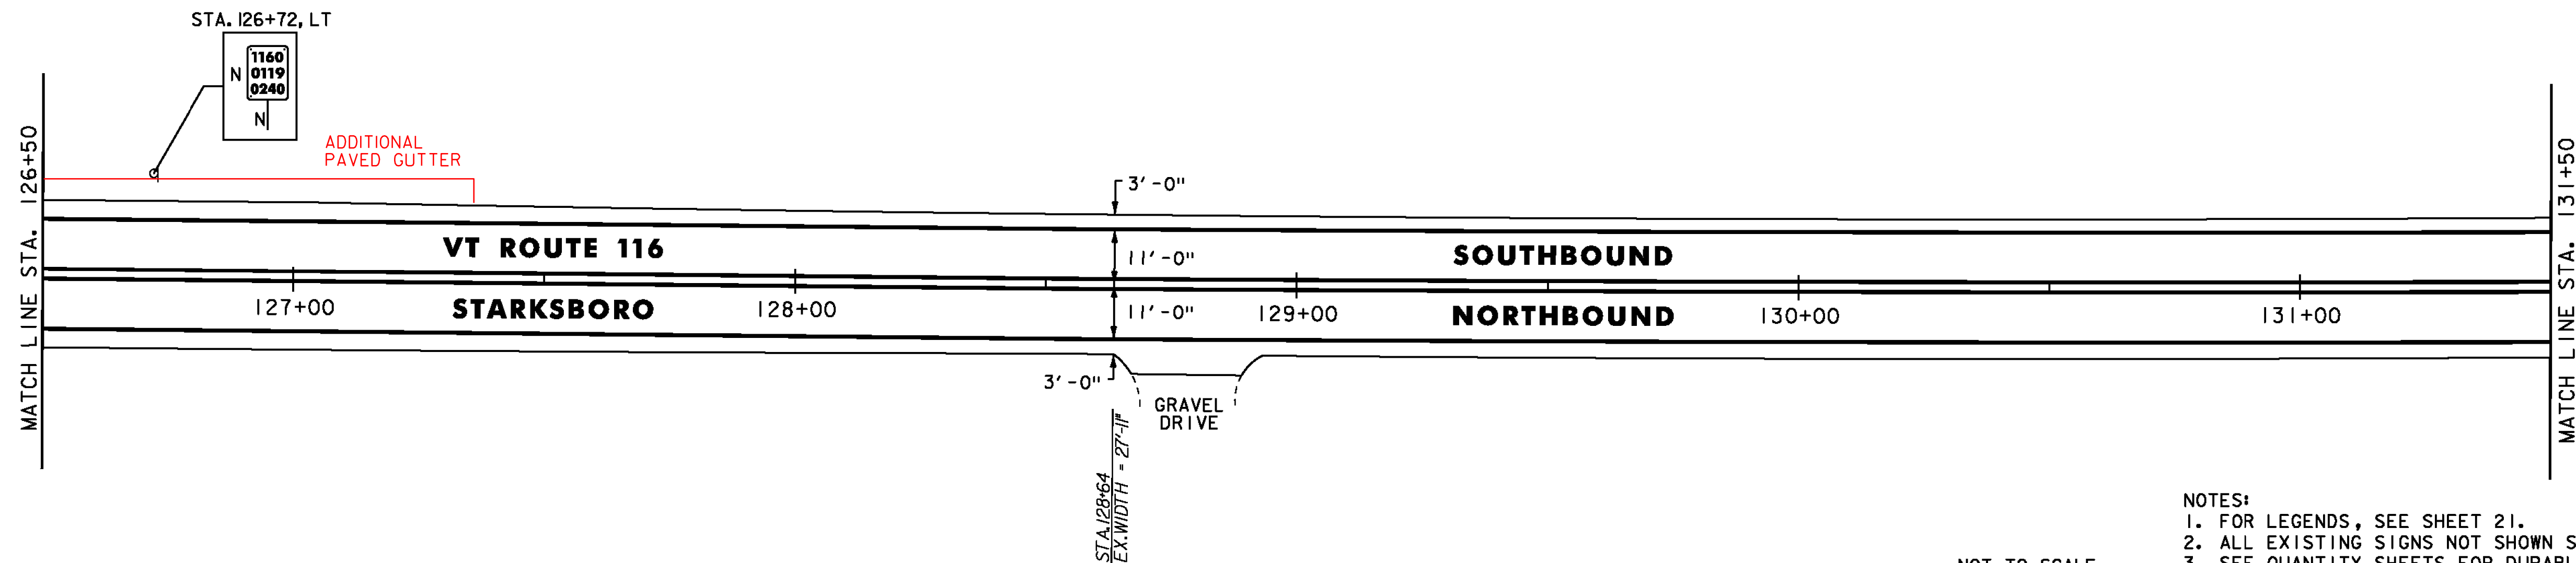

- NOTES:
1. FOR LEGENDS, SEE SHEET 21.
 2. ALL EXISTING SIGNS NOT SHOWN SHALL BE RETAINED.
 3. SEE QUANTITY SHEETS FOR DURABLE PAVEMENT MARKING OPTIONS.

NOT TO SCALE

PROJECT LAYOUT SHEET #5



PROJECT NAME: STARKSBORO-HINESBURG	PLOT DATE: 28-NOV-2012
PROJECT NUMBER: STP 2930(I)	DRAWN BY: STANTEC
FILE NAME: p10b266.dgn	CHECKED BY: MCF
PROJECT LEADER: JLL	SHEET 25 OF 119
DESIGNED BY: STANTEC	
IPARM FILE: p10b266105.i	