


**DURABLE 4 INCH WHITE LINE**  
 (ALL LINES WILL INCLUDE EDGE LINE BREAKS AND  
 RADII FOR SIDE ROADS)  
 STA. 170+50 TO 176+50, SOLID LT & RT

**DURABLE 4 INCH YELLOW LINE**  
 (ALL LINES WILL INCLUDE C BREAKS FOR SIDE ROADS)  
 STA. 170+50 TO 176+50, SOLID LT & RT

**TEMPORARY 4 INCH WHITE LINE, PAINT**  
 (ALL LINES WILL INCLUDE EDGE LINE BREAKS AND  
 RADII FOR SIDE ROADS)  
 STA. 170+50 TO 176+50, SOLID LT & RT

**TEMPORARY 4 INCH YELLOW LINE, PAINT**  
 (ALL LINES WILL INCLUDE C BREAKS FOR SIDE ROADS)  
 STA. 170+50 TO 176+50, SOLID LT & RT

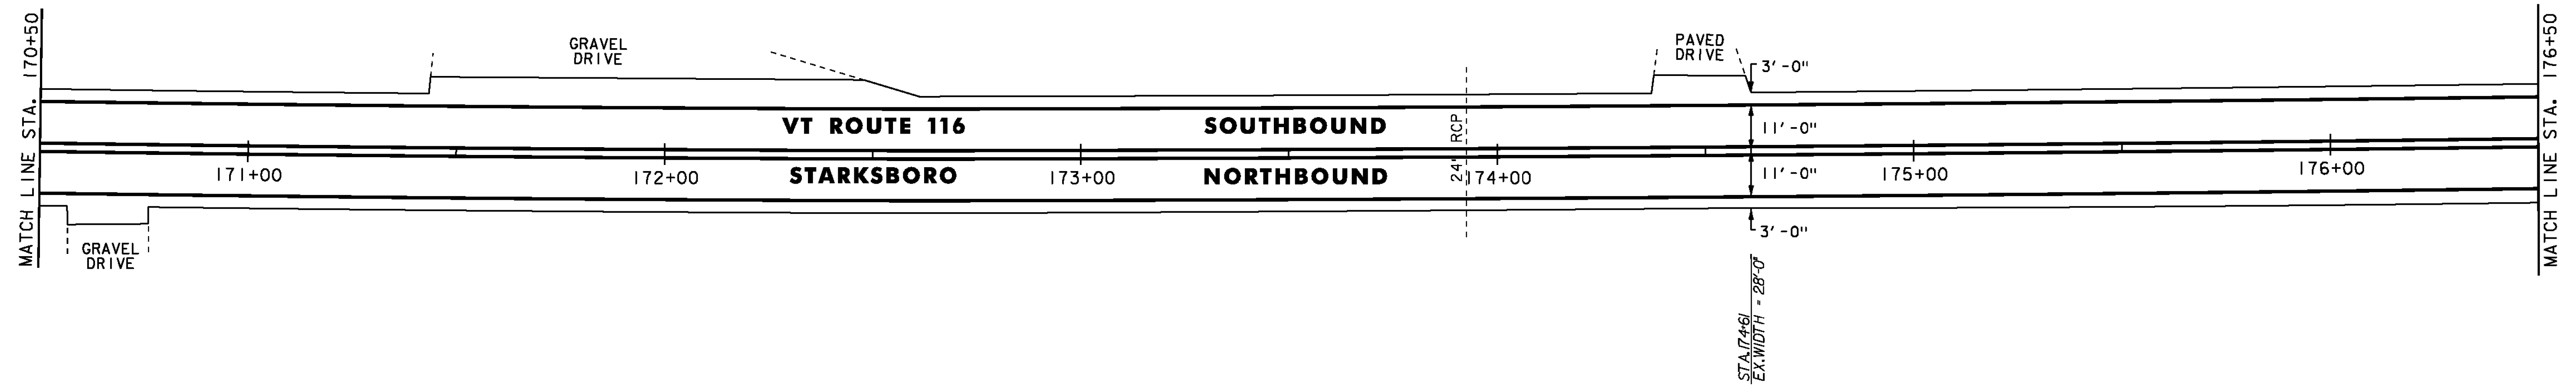

**STEEL BEAM GUARDRAIL, GALVANIZED**  
 STA. 178+90 TO 181+90, LT

**ANCHOR FOR STEEL BEAM RAIL**  
 STA. 178+90, LT  
 STA. 181+90, LT

**REMOVAL AND DISPOSAL OF GUARDRAIL**  
 STA. 178+93 TO 181+97, LT


**DURABLE 4 INCH WHITE LINE**  
 (ALL LINES WILL INCLUDE EDGE LINE BREAKS AND  
 RADII FOR SIDE ROADS)  
 STA. 176+50 TO 182+50, SOLID LT & RT


**DURABLE 4 INCH YELLOW LINE**  
 (ALL LINES WILL INCLUDE C BREAKS FOR SIDE ROADS)  
 STA. 176+50 TO 182+50, SOLID LT & RT

**TEMPORARY 4 INCH WHITE LINE, PAINT**  
 (ALL LINES WILL INCLUDE EDGE LINE BREAKS AND  
 RADII FOR SIDE ROADS)  
 STA. 176+50 TO 182+50, SOLID LT & RT

**TEMPORARY 4 INCH YELLOW LINE, PAINT**  
 (ALL LINES WILL INCLUDE C BREAKS FOR SIDE ROADS)  
 STA. 176+50 TO 182+50, SOLID LT & RT

**REMOVING SIGNS**  
 AS SHOWN - 3

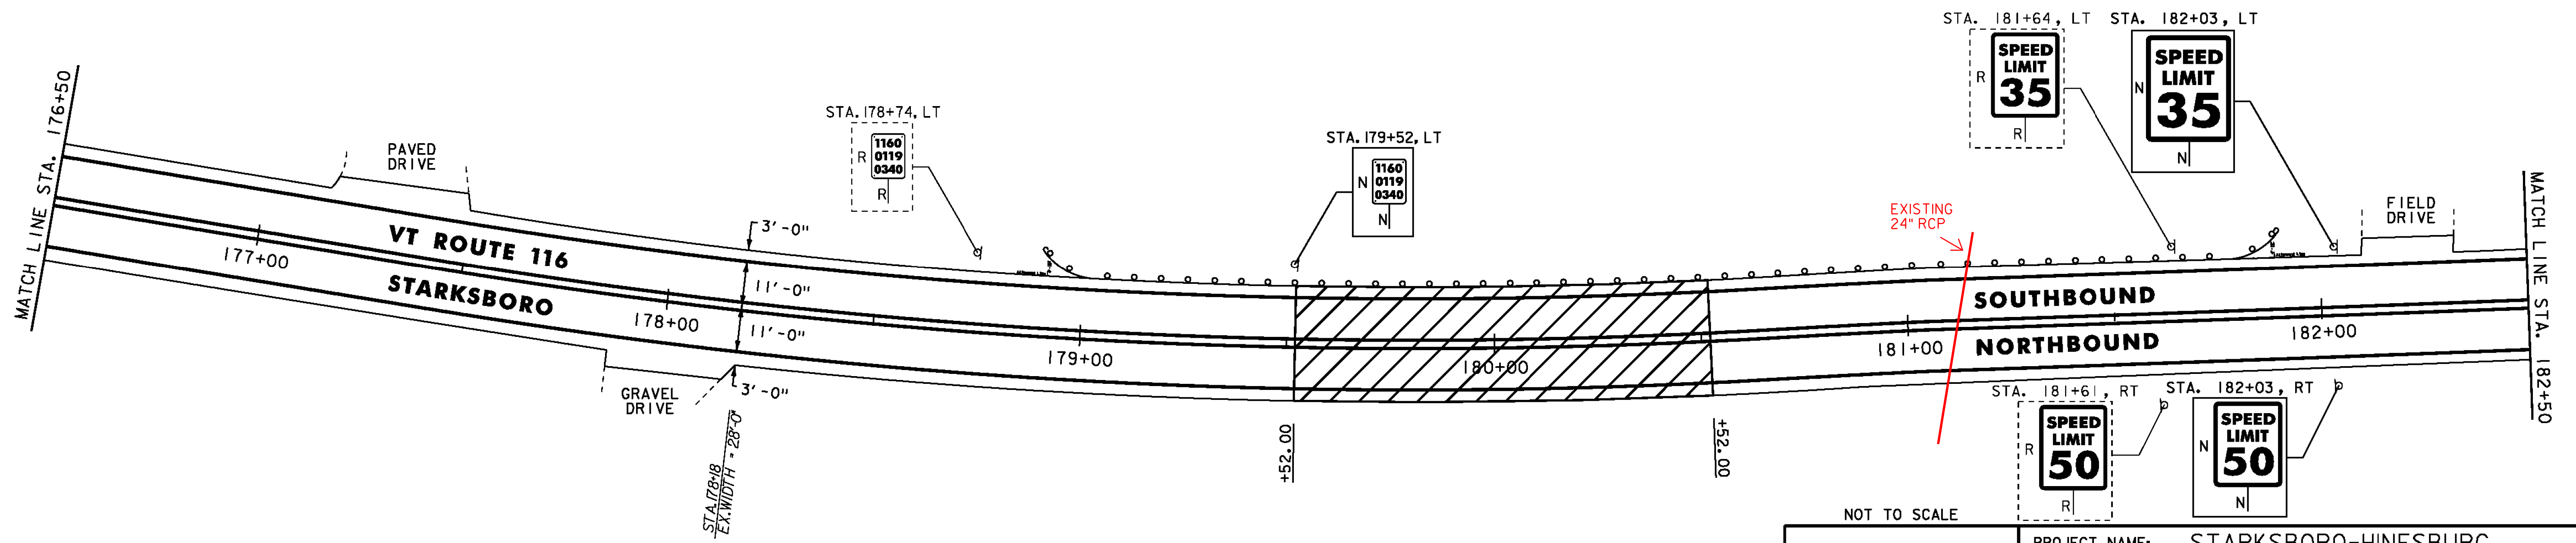

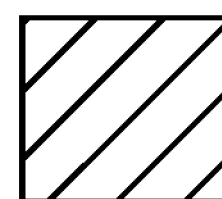 **COLD PLANE TRANSITION AREA**  
 (FOR TYPICAL, SEE SHEET 3)

- NOTES:**
1. FOR LEGENDS, SEE SHEET 21.
  2. ALL EXISTING SIGNS NOT SHOWN SHALL BE RETAINED.
  3. SEE QUANTITY SHEETS FOR DURABLE PAVEMENT MARKING OPTIONS.



**PROJECT LAYOUT SHEET #10**

PROJECT NAME: STARKSBORO-HINESBURG  
 PROJECT NUMBER: STP 2930(I)

FILE NAME: p10b266.dgn  
 PROJECT LEADER: JLL  
 DESIGNED BY: STANTEC  
 IPARM FILE: p10b266110.i

PLOT DATE: 28-NOV-2012  
 DRAWN BY: STANTEC  
 CHECKED BY: MCF  
 SHEET 30 OF 119