

**STEEL BEAM GUARDRAIL, GALVANIZED**  
 STA. 184+01 TO 186+38.5, LT  
 STA. 186+65 TO 188+50, LT

**ANCHOR FOR STEEL BEAM RAIL**  
 STA. 184+01, LT  
 STA. 186+38.5, LT  
 STA. 186+65, LT

**REMOVAL AND DISPOSAL OF GUARDRAIL**  
 STA. 184+00 TO 186+38.5, LT  
 STA. 186+65 TO 188+50, LT


**DURABLE 4 INCH WHITE LINE**  
 (ALL LINES WILL INCLUDE EDGE LINE BREAKS AND RADIUS FOR SIDE ROADS)  
 STA. 182+50 TO 188+50, SOLID LT & RT

**DURABLE 4 INCH YELLOW LINE**  
 (ALL LINES WILL INCLUDE C BREAKS FOR SIDE ROADS)  
 STA. 182+50 TO 188+50, SOLID LT & RT

**TEMPORARY 4 INCH WHITE LINE, PAINT**  
 (ALL LINES WILL INCLUDE EDGE LINE BREAKS AND RADIUS FOR SIDE ROADS)  
 STA. 182+50 TO 188+50, SOLID LT & RT

**TEMPORARY 4 INCH YELLOW LINE, PAINT**  
 (ALL LINES WILL INCLUDE C BREAKS FOR SIDE ROADS)  
 STA. 182+50 TO 188+50, SOLID LT & RT

**REMOVING SIGNS**  
 AS SHOWN - 2

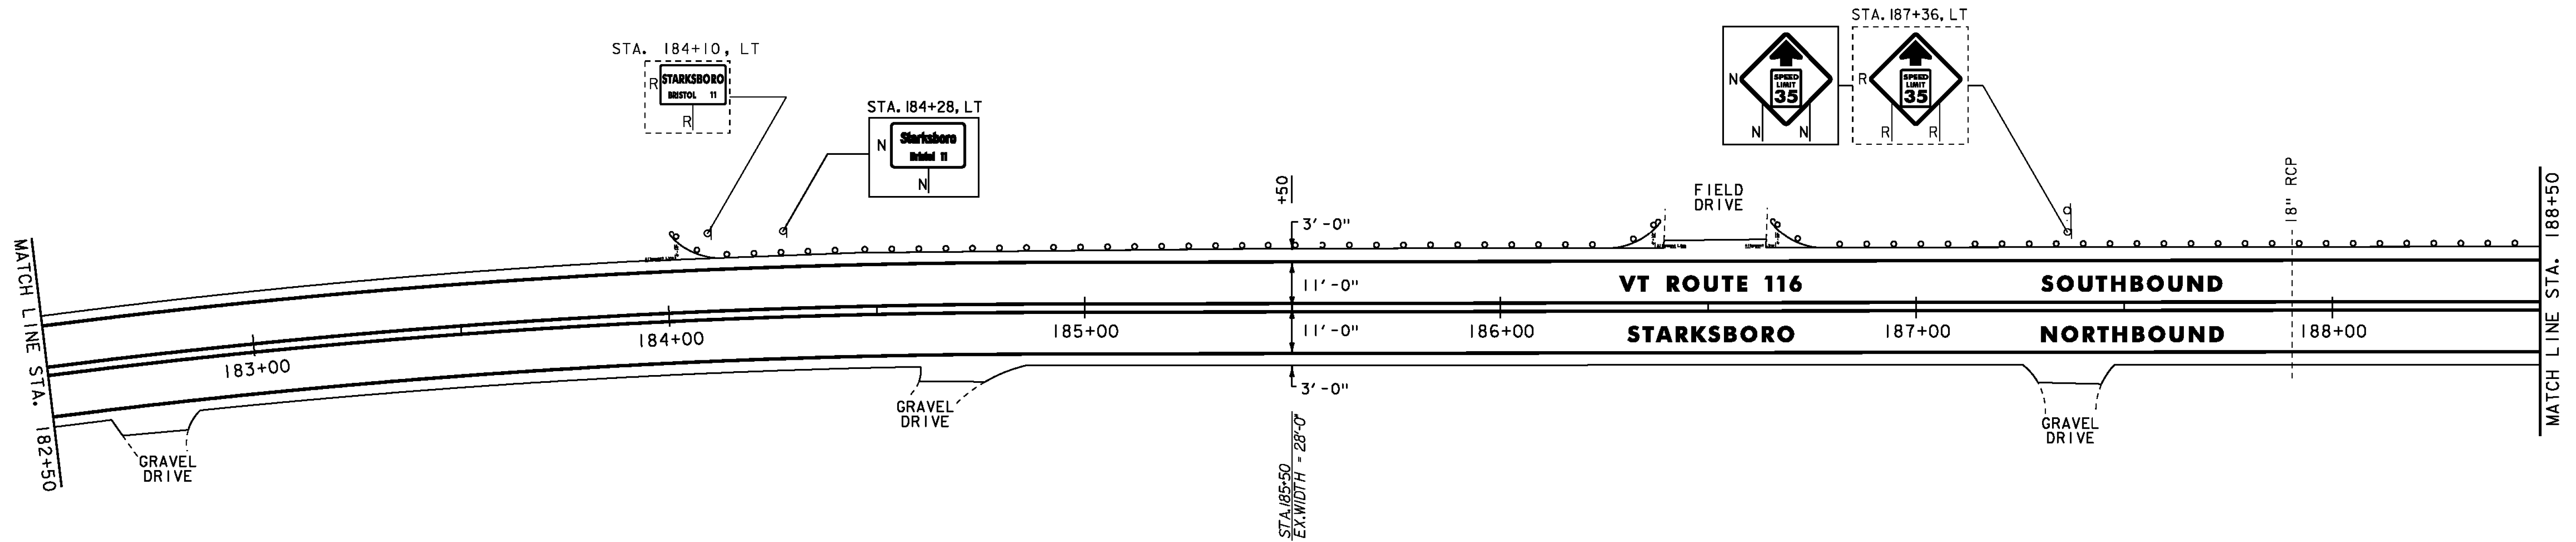

**STEEL BEAM GUARDRAIL, GALVANIZED**  
 STA. 188+50 TO 194+50, LT

**REMOVAL AND DISPOSAL OF GUARDRAIL**  
 STA. 188+50 TO 194+50, LT


**DURABLE 4 INCH WHITE LINE**  
 (ALL LINES WILL INCLUDE EDGE LINE BREAKS AND RADIUS FOR SIDE ROADS)  
 STA. 188+50 TO 194+50, SOLID LT & RT

**DURABLE 4 INCH YELLOW LINE**  
 (ALL LINES WILL INCLUDE C BREAKS FOR SIDE ROADS)  
 STA. 188+50 TO 194+50, SOLID LT & RT

**TEMPORARY 4 INCH WHITE LINE, PAINT**  
 (ALL LINES WILL INCLUDE EDGE LINE BREAKS AND RADIUS FOR SIDE ROADS)  
 STA. 188+50 TO 194+50, SOLID LT & RT

**TEMPORARY 4 INCH YELLOW LINE, PAINT**  
 (ALL LINES WILL INCLUDE C BREAKS FOR SIDE ROADS)  
 STA. 188+50 TO 194+50, SOLID LT & RT

**REMOVING SIGNS**  
 AS SHOWN - 1

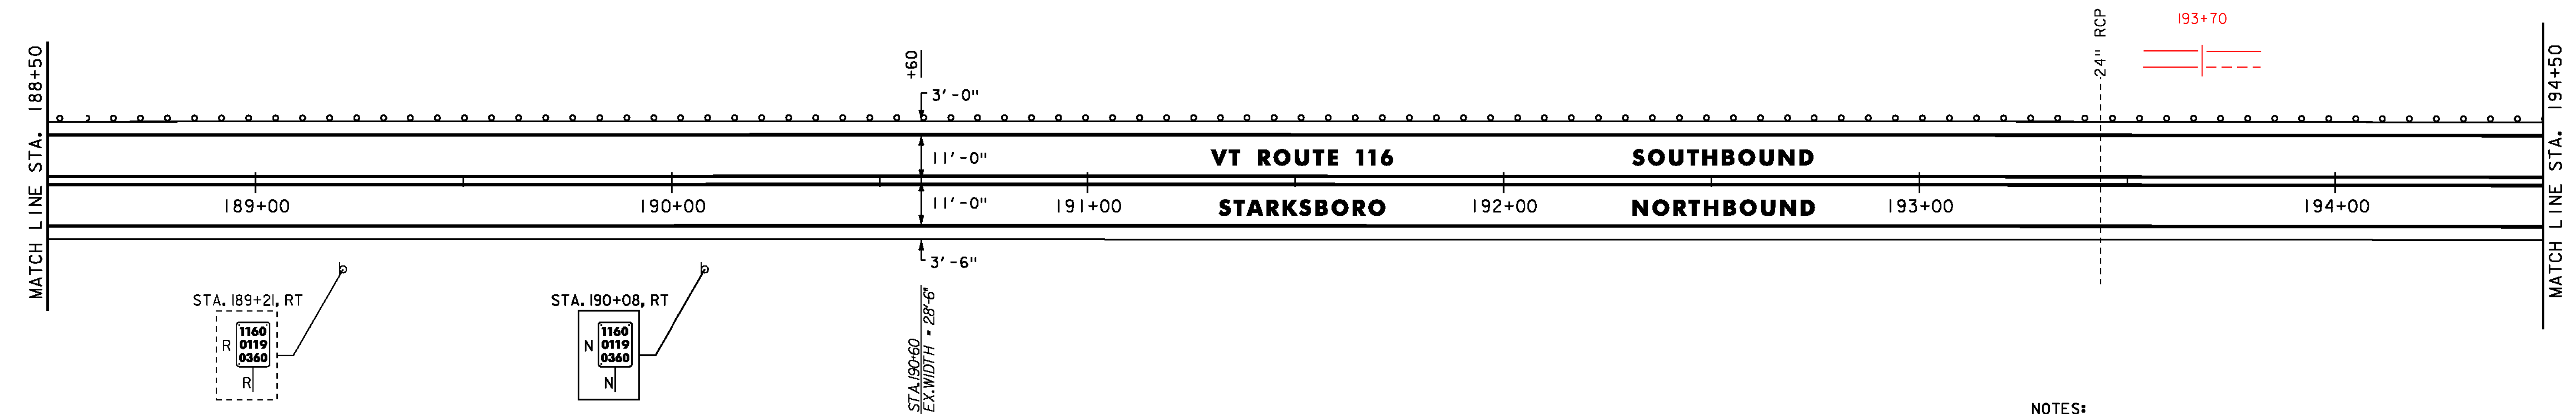

- NOTES:
- FOR LEGENDS, SEE SHEET 21.
  - ALL EXISTING SIGNS NOT SHOWN SHALL BE RETAINED.
  - SEE QUANTITY SHEETS FOR DURABLE PAVEMENT MARKING OPTIONS.

NOT TO SCALE

**PROJECT LAYOUT SHEET #11**



PROJECT NAME: STARKSBORO-HINESBURG  
 PROJECT NUMBER: STP 2930(I)

FILE NAME: p10b266.dgn  
 PROJECT LEADER: JLL  
 DESIGNED BY: STANTEC  
 IPARM FILE: p10b266111.i

PLOT DATE: 28-NOV-2012  
 DRAWN BY: STANTEC  
 CHECKED BY: MCF  
 SHEET 31 OF 119