


STEEL BEAM GUARDRAIL, GALVANIZED
 STA. 194+50 TO 200+50, LT
REMOVAL AND DISPOSAL OF GUARDRAIL
 STA. 194+50 TO 200+50, LT

DURABLE 4 INCH WHITE LINE
 (ALL LINES WILL INCLUDE EDGE LINE BREAKS AND
 RADII FOR SIDE ROADS)
 STA. 194+50 TO 200+50, SOLID LT & RT
DURABLE 4 INCH YELLOW LINE
 (ALL LINES WILL INCLUDE C BREAKS FOR SIDE ROADS)
 STA. 194+50 TO 194+83, SOLID LT & RT
 STA. 194+83 TO 200+50, SOLID LT, DASHED RT

TEMPORARY 4 INCH WHITE LINE, PAINT
 (ALL LINES WILL INCLUDE EDGE LINE BREAKS AND
 RADII FOR SIDE ROADS)
 STA. 194+50 TO 200+50, SOLID LT & RT
TEMPORARY 4 INCH YELLOW LINE, PAINT
 (ALL LINES WILL INCLUDE C BREAKS FOR SIDE ROADS)
 STA. 194+50 TO 194+83, SOLID LT & RT
 STA. 194+83 TO 200+50, SOLID LT, DASHED RT


REMOVING SIGNS
 AS SHOWN - 2

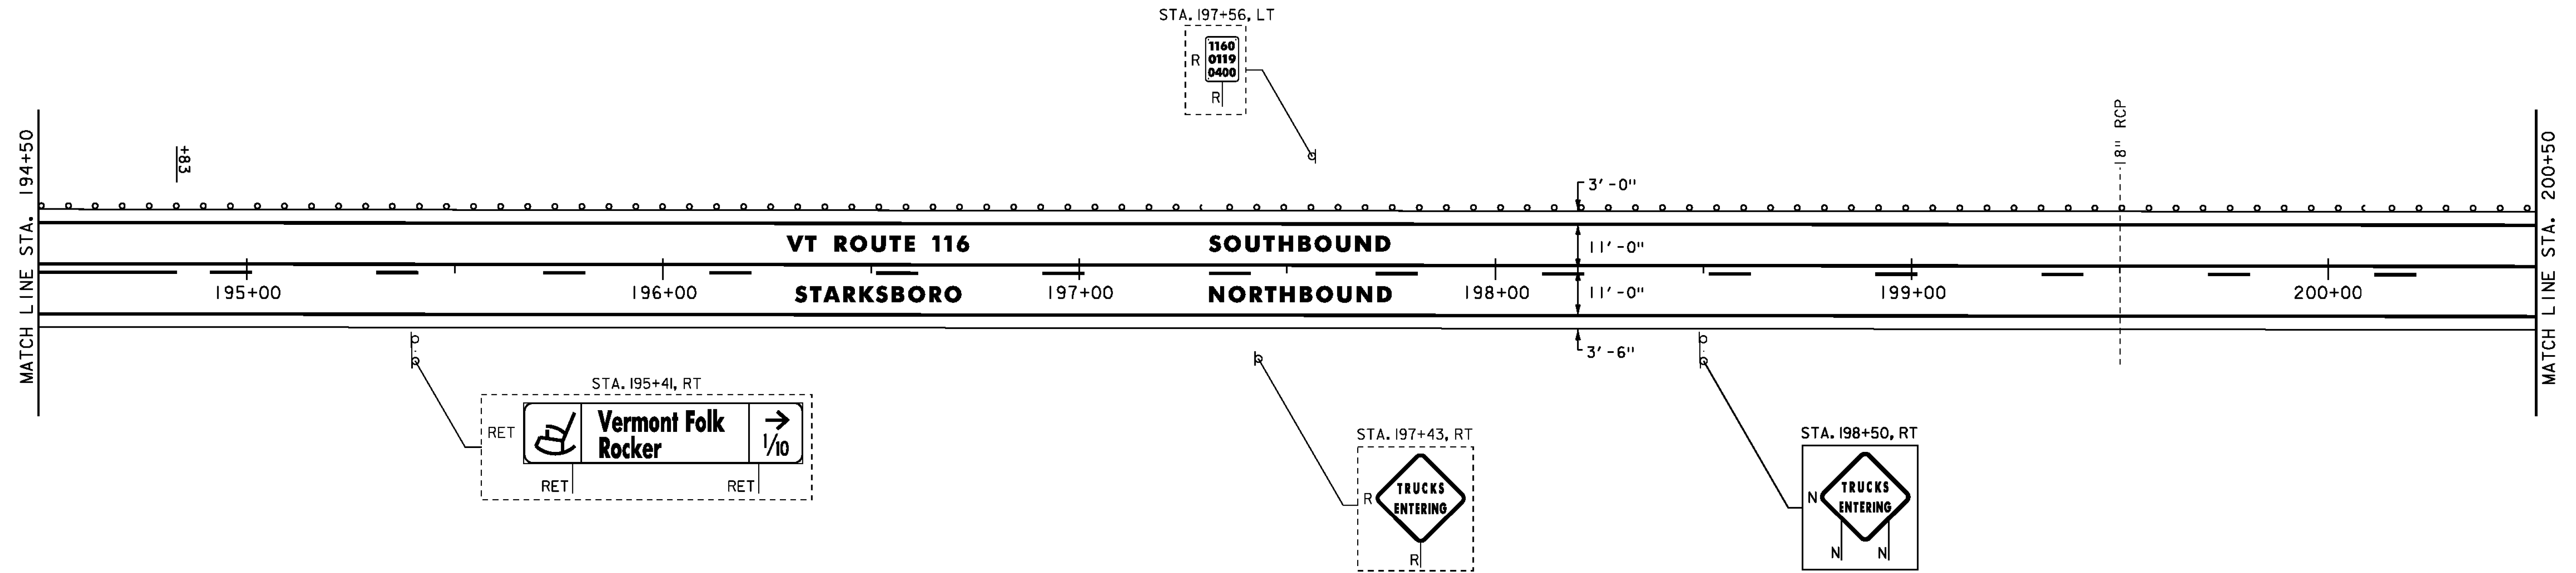

STEEL BEAM GUARDRAIL, GALVANIZED
 STA. 200+50 TO 206+50, LT
REMOVAL AND DISPOSAL OF GUARDRAIL
 STA. 200+50 TO 206+50, LT

DURABLE 4 INCH WHITE LINE
 (ALL LINES WILL INCLUDE EDGE LINE BREAKS AND
 RADII FOR SIDE ROADS)
 STA. 200+50 TO 206+50, SOLID LT & RT
DURABLE 4 INCH YELLOW LINE
 (ALL LINES WILL INCLUDE C BREAKS FOR SIDE ROADS)
 STA. 200+50 TO 202+70, SOLID LT, DASHED RT
 STA. 202+70 TO 206+50, DASHED C

TEMPORARY 4 INCH WHITE LINE, PAINT
 (ALL LINES WILL INCLUDE EDGE LINE BREAKS AND
 RADII FOR SIDE ROADS)
 STA. 200+50 TO 206+50, SOLID LT & RT
TEMPORARY 4 INCH YELLOW LINE, PAINT
 (ALL LINES WILL INCLUDE C BREAKS FOR SIDE ROADS)
 STA. 200+50 TO 202+70, SOLID LT, DASHED RT
 STA. 202+70 TO 206+50, DASHED C

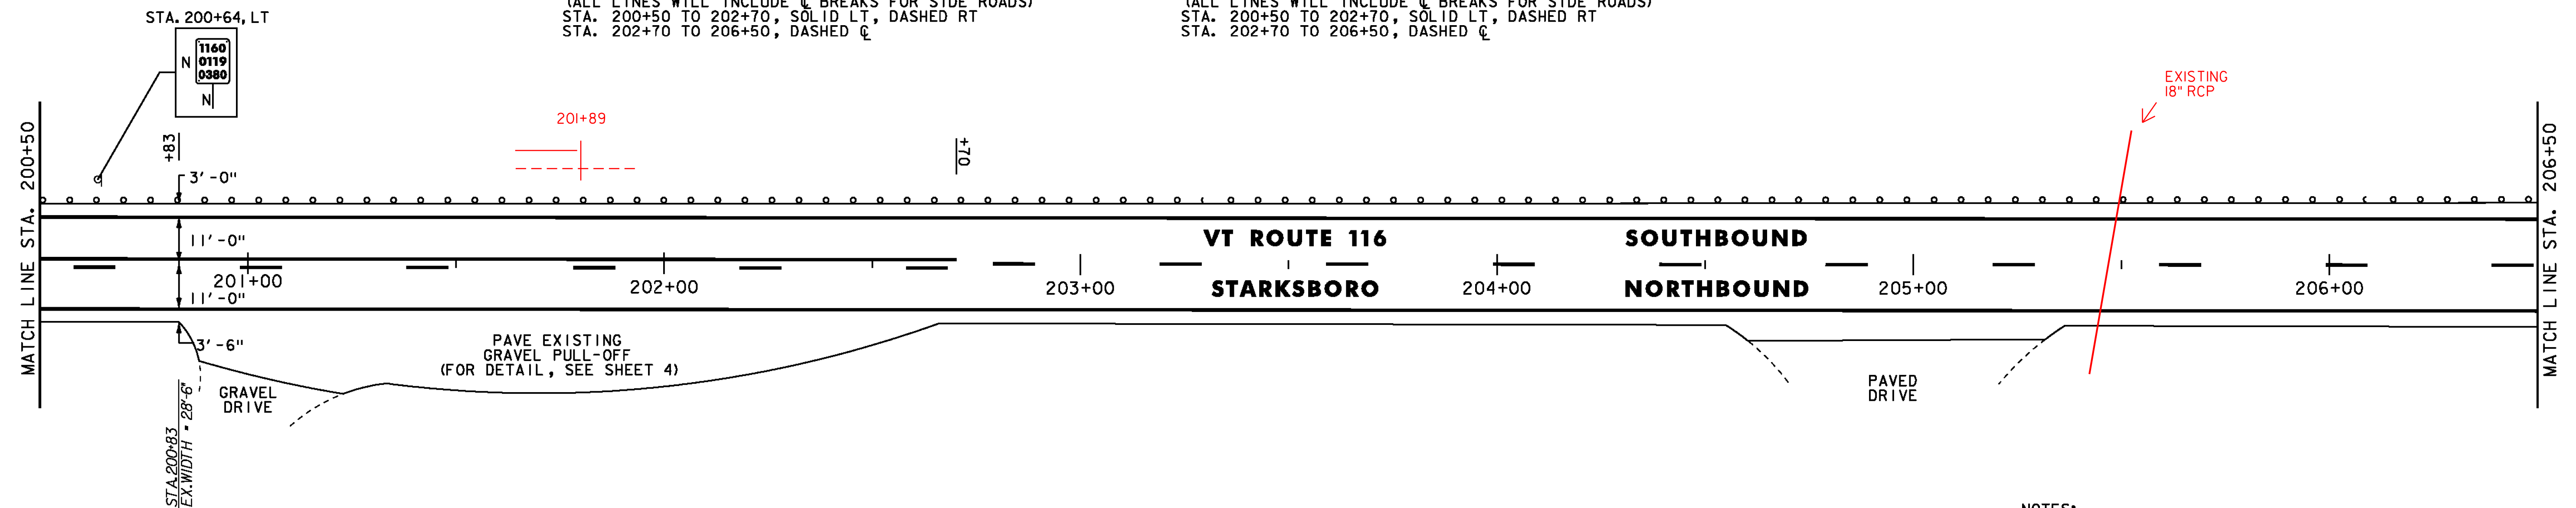

- NOTES:
 1. FOR LEGENDS, SEE SHEET 21.
 2. ALL EXISTING SIGNS NOT SHOWN SHALL BE RETAINED.
 3. SEE QUANTITY SHEETS FOR DURABLE PAVEMENT MARKING OPTIONS.

NOT TO SCALE

**PROJECT
 LAYOUT
 SHEET #12**



PROJECT NAME: STARKSBORO-HINESBURG
 PROJECT NUMBER: STP 2930(I)

FILE NAME: p10b266.dgn
 PROJECT LEADER: JLL
 DESIGNED BY: STANTEC
 IPARM FILE: p10b266i12.i

PLOT DATE: 28-NOV-2012
 DRAWN BY: STANTEC
 CHECKED BY: MCF
 SHEET 32 OF 119