


STEEL BEAM GUARDRAIL, GALVANIZED
 STA. 220+05 TO 223+92.5, LT
ANCHOR FOR STEEL BEAM RAIL
 STA. 220+05, LT
 STA. 223+92.5, LT
REMOVAL AND DISPOSAL OF GUARDRAIL
 STA. 220+05 TO 223+95, LT

DURABLE 4 INCH WHITE LINE
 (ALL LINES WILL INCLUDE EDGE LINE BREAKS AND RADI FOR SIDE ROADS)
 STA. 218+50 TO 224+50, SOLID LT & RT
DURABLE 4 INCH YELLOW LINE
 (ALL LINES WILL INCLUDE C BREAKS FOR SIDE ROADS)
 STA. 218+50 TO 219+12, SOLID LT & RT
 STA. 219+12 TO 224+50, SOLID LT, DASHED RT

TEMPORARY 4 INCH WHITE LINE, PAINT
 (ALL LINES WILL INCLUDE EDGE LINE BREAKS AND RADI FOR SIDE ROADS)
 STA. 218+50 TO 224+50, SOLID LT & RT
TEMPORARY 4 INCH YELLOW LINE, PAINT
 (ALL LINES WILL INCLUDE C BREAKS FOR SIDE ROADS)
 STA. 218+50 TO 219+12, SOLID LT & RT
 STA. 219+12 TO 224+50, SOLID LT, DASHED RT

REMOVING SIGNS
 AS SHOWN - 1

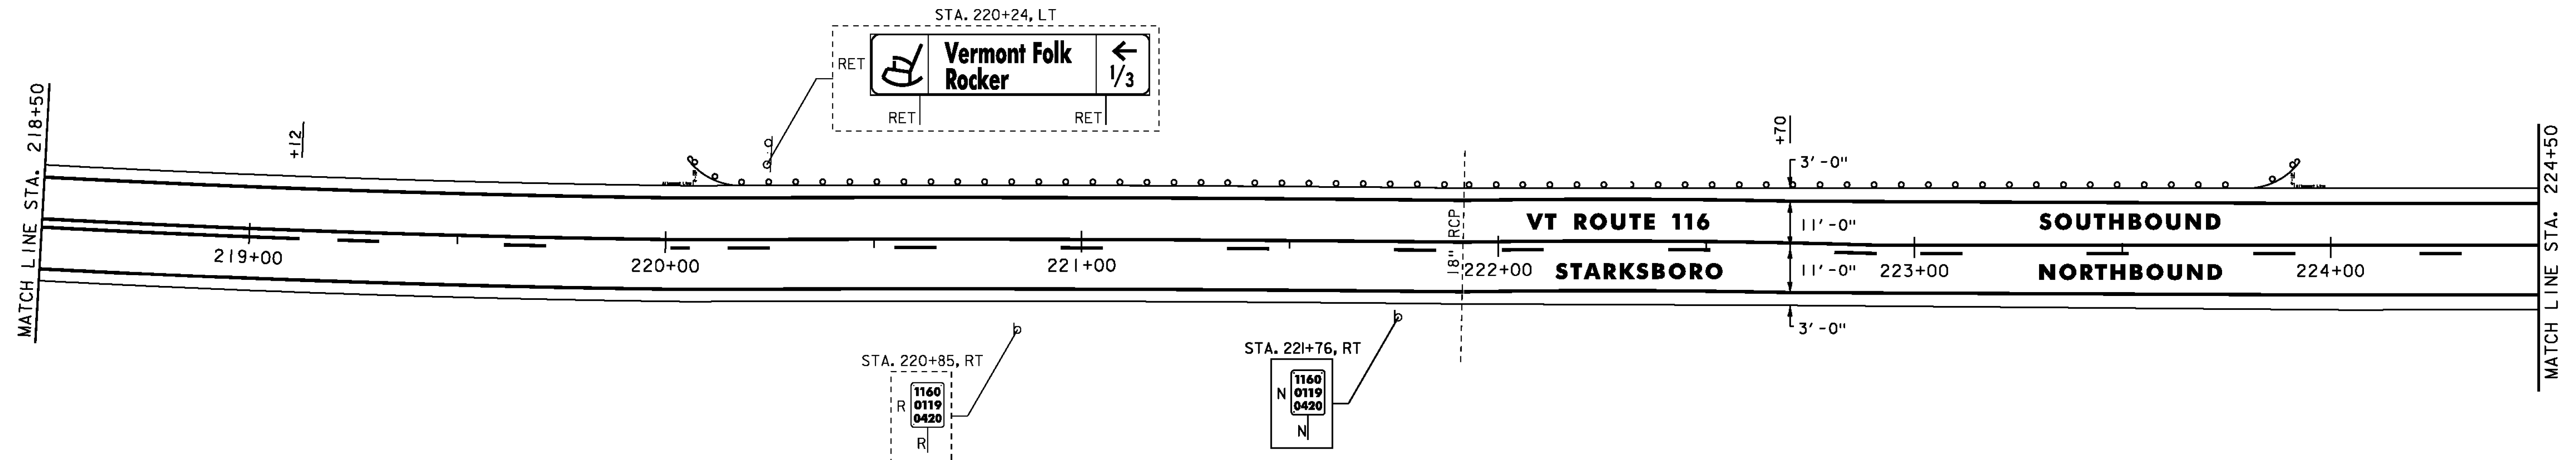


DURABLE 4 INCH WHITE LINE
 (ALL LINES WILL INCLUDE EDGE LINE BREAKS AND RADI FOR SIDE ROADS)
 STA. 224+50 TO 229+50, SOLID LT & RT

TEMPORARY 4 INCH WHITE LINE, PAINT
 (ALL LINES WILL INCLUDE EDGE LINE BREAKS AND RADI FOR SIDE ROADS)
 STA. 224+50 TO 229+50, SOLID LT & RT

DURABLE 4 INCH YELLOW LINE
 (ALL LINES WILL INCLUDE C BREAKS FOR SIDE ROADS)
 STA. 224+50 TO 226+25, SOLID LT, DASHED RT
 STA. 226+25 TO 229+50, DASHED C

TEMPORARY 4 INCH YELLOW LINE, PAINT
 (ALL LINES WILL INCLUDE C BREAKS FOR SIDE ROADS)
 STA. 224+50 TO 226+25, SOLID LT, DASHED RT
 STA. 226+25 TO 229+50, DASHED C

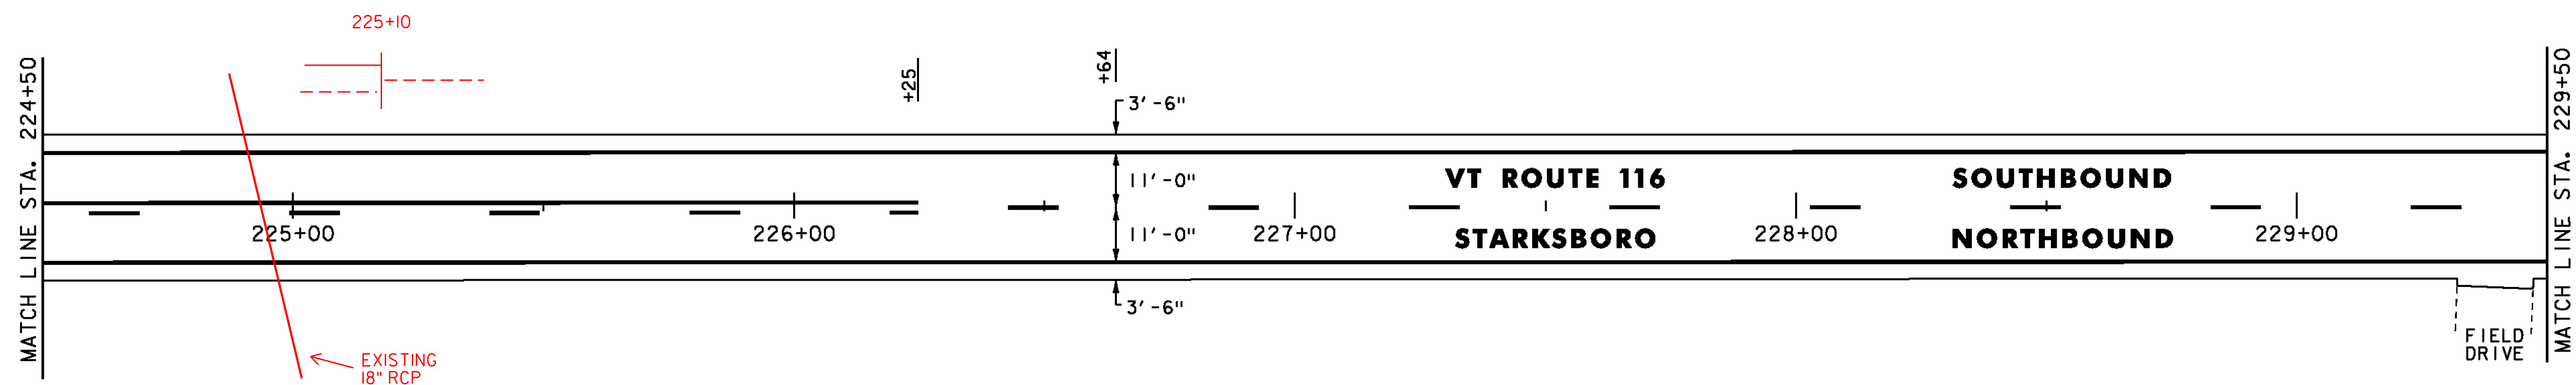

- NOTES:
 1. FOR LEGENDS, SEE SHEET 21.
 2. ALL EXISTING SIGNS NOT SHOWN SHALL BE RETAINED.
 3. SEE QUANTITY SHEETS FOR DURABLE PAVEMENT MARKING OPTIONS.

NOT TO SCALE

PROJECT LAYOUT SHEET #14



PROJECT NAME: STARKSBORO-HINESBURG
 PROJECT NUMBER: STP 2930(I)

FILE NAME: p10b266.dgn
 PROJECT LEADER: JLL
 DESIGNED BY: STANTEC
 IPARM FILE: p10b266114.i

PLOT DATE: 28-NOV-2012
 DRAWN BY: STANTEC
 CHECKED BY: MCF
 SHEET 34 OF 119