

DURABLE 4 INCH WHITE LINE
 (ALL LINES WILL INCLUDE EDGE LINE BREAKS AND RADIi FOR SIDE ROADS)
 STA. 255+50 TO 261+50, SOLID LT & RT

DURABLE 4 INCH YELLOW LINE
 (ALL LINES WILL INCLUDE C BREAKS FOR SIDE ROADS)
 STA. 255+50 TO 261+50, SOLID LT & RT
 STA. 257+78, DOUBLE SOLID RT (VARNEY HILL ROAD TH-14)

DURABLE 24 INCH STOP BAR
 STA. 257+78, RT (VARNEY HILL ROAD TH-14)

DURABLE LETTER OR SYMBOL
 STA. 257+78, RT "STOP" (VARNEY HILL ROAD TH-14)


TEMPORARY 4 INCH WHITE LINE, PAINT
 (ALL LINES WILL INCLUDE EDGE LINE BREAKS AND RADIi FOR SIDE ROADS)
 STA. 255+50 TO 261+50, SOLID LT & RT

TEMPORARY 4 INCH YELLOW LINE, PAINT
 (ALL LINES WILL INCLUDE C BREAKS FOR SIDE ROADS)
 STA. 255+50 TO 261+50, SOLID LT & RT
 STA. 257+78, DOUBLE SOLID RT (VARNEY HILL ROAD TH-14)

TEMPORARY 24 INCH STOP BAR, PAINT
 STA. 257+78, RT (VARNEY HILL ROAD TH-14)

TEMPORARY LETTER OR SYMBOL, PAINT
 STA. 257+78, RT "STOP" (VARNEY HILL ROAD TH-14)

REMOVING SIGNS
 AS SHOWN - 4

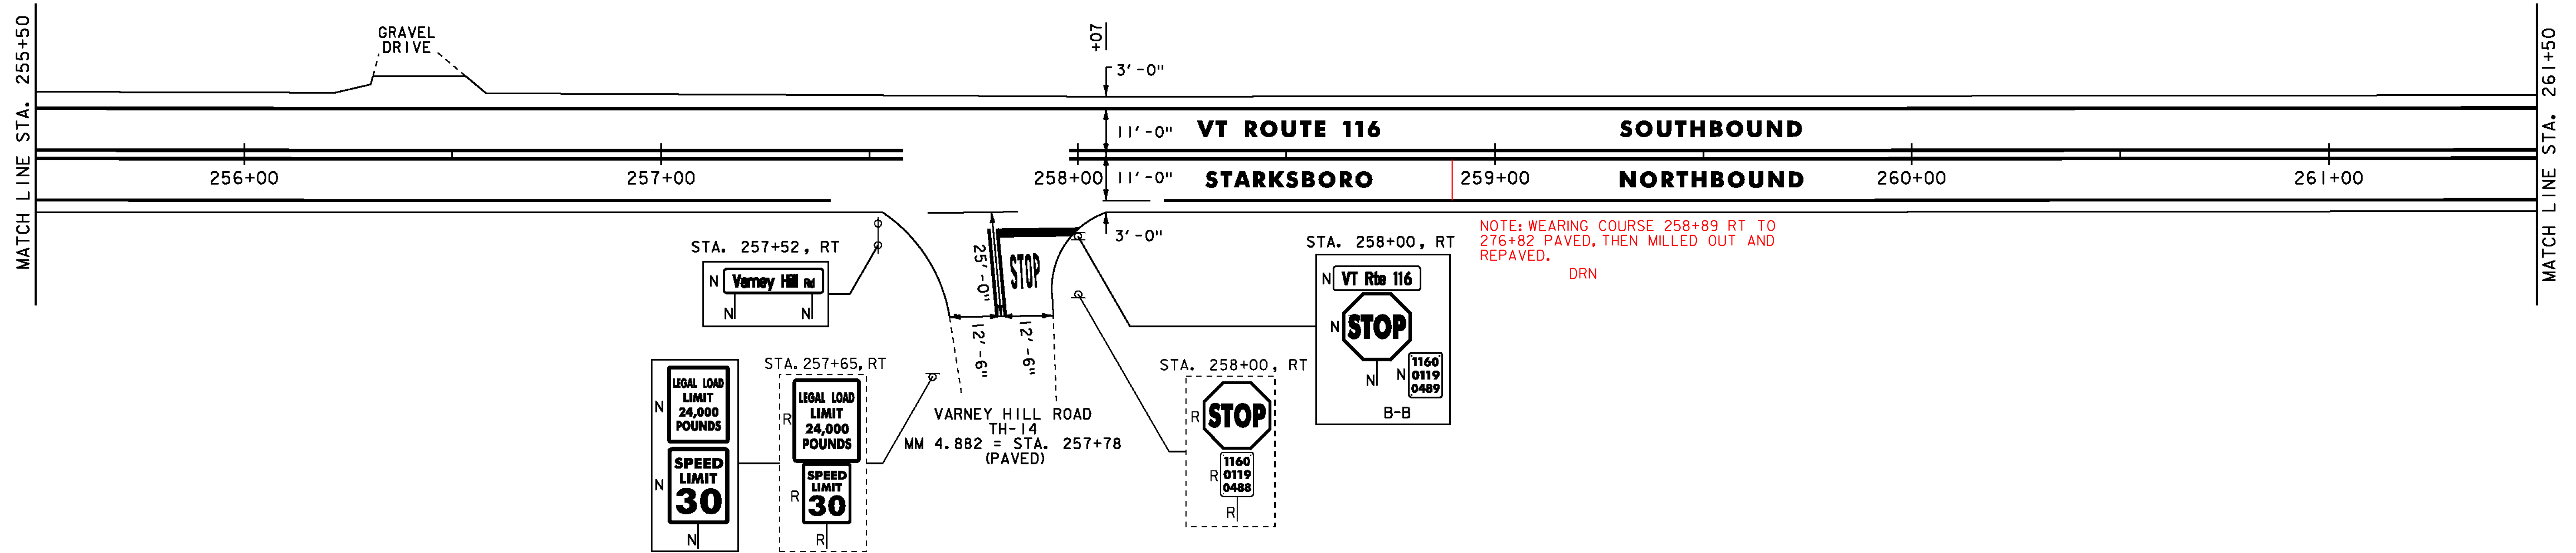


DURABLE 4 INCH WHITE LINE
 (ALL LINES WILL INCLUDE EDGE LINE BREAKS AND RADIi FOR SIDE ROADS)
 STA. 261+50 TO 267+50, SOLID LT & RT

DURABLE 4 INCH YELLOW LINE
 (ALL LINES WILL INCLUDE C BREAKS FOR SIDE ROADS)
 STA. 261+50 TO 267+50, SOLID LT & RT

TEMPORARY 4 INCH WHITE LINE, PAINT
 (ALL LINES WILL INCLUDE EDGE LINE BREAKS AND RADIi FOR SIDE ROADS)
 STA. 261+50 TO 267+50, SOLID LT & RT

TEMPORARY 4 INCH YELLOW LINE, PAINT
 (ALL LINES WILL INCLUDE C BREAKS FOR SIDE ROADS)
 STA. 261+50 TO 267+50, SOLID LT & RT

REMOVING SIGNS
 AS SHOWN - 2

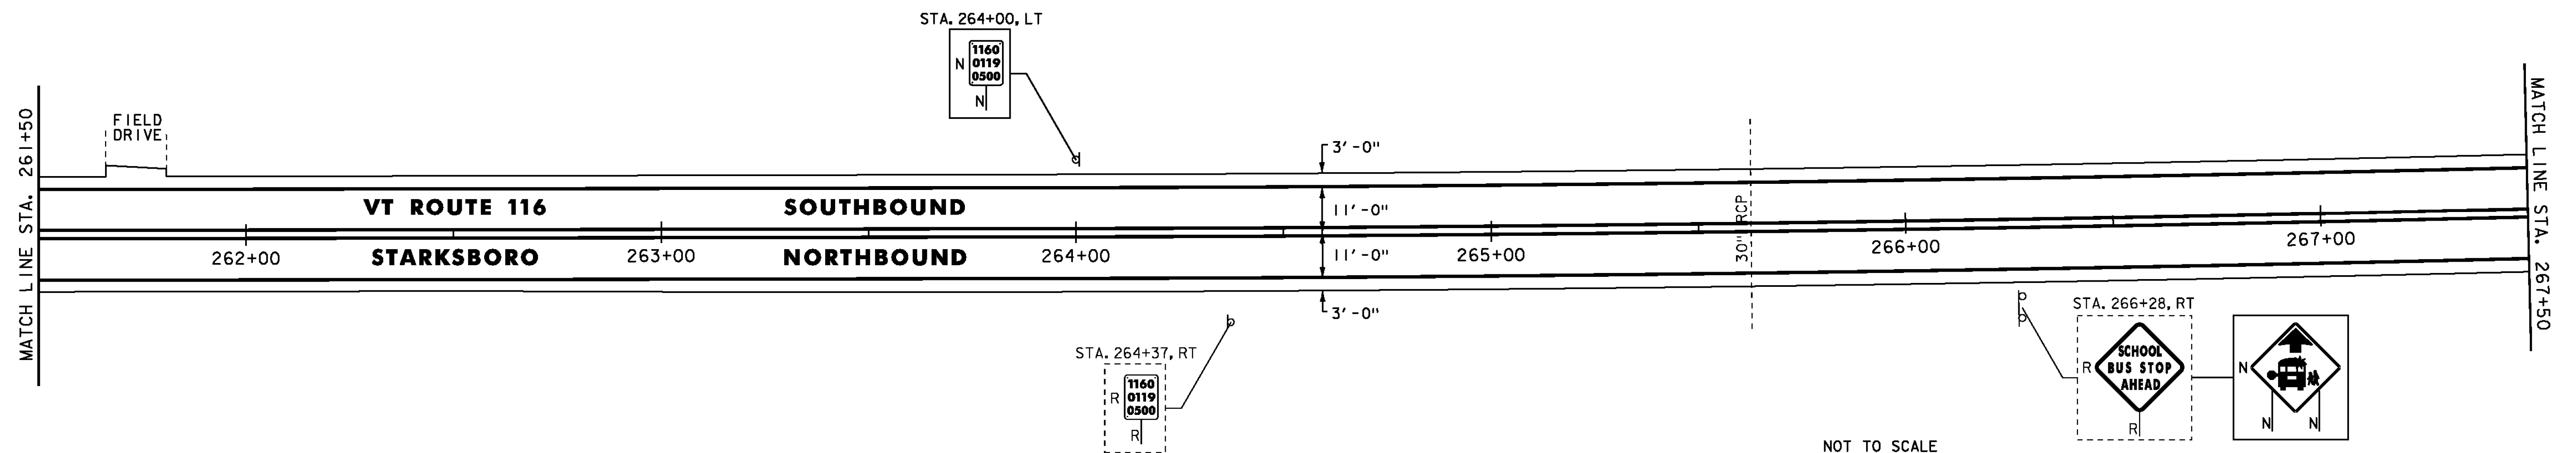

- NOTES:
- FOR LEGENDS, SEE SHEET 21.
 - ALL EXISTING SIGNS NOT SHOWN SHALL BE RETAINED.
 - SEE QUANTITY SHEETS FOR DURABLE PAVEMENT MARKING OPTIONS.



NOT TO SCALE

PROJECT LAYOUT SHEET #18

PROJECT NAME: STARKSBORO-HINESBURG
 PROJECT NUMBER: STP 2930(I)

FILE NAME: p10b266.dgn
 PROJECT LEADER: JLL
 DESIGNED BY: STANTEC
 IPARM FILE: p10b266i18.i

PLOT DATE: 28-NOV-2012
 DRAWN BY: STANTEC
 CHECKED BY: MCF
 SHEET 38 OF 119