

**STEEL BEAM GUARDRAIL, GALVANIZED**  
 STA. 291+50 TO 292+50, RT  
 STA. 295+10 TO 296+22.5, RT  
 STA. 295+90 TO 297+15, LT

**ANCHOR FOR STEEL BEAM RAIL**  
 STA. 292+50, RT  
 STA. 295+10, RT  
 STA. 295+90, LT  
 STA. 296+22.5, RT  
 STA. 297+15, LT

**REMOVAL AND DISPOSAL OF GUARDRAIL**  
 STA. 291+50 TO 292+48, RT  
 STA. 295+08 TO 296+23.5, RT  
 STA. 295+87 TO 297+14, LT


**DURABLE 4 INCH WHITE LINE**  
 (ALL LINES WILL INCLUDE EDGE LINE BREAKS AND  
 RADII FOR SIDE ROADS)  
 STA. 291+50 TO 297+50, SOLID LT & RT

**DURABLE 4 INCH YELLOW LINE**  
 (ALL LINES WILL INCLUDE C BREAKS FOR SIDE ROADS)  
 STA. 291+50 TO 295+68, SOLID LT, DASHED RT  
 STA. 295+68 TO 297+26, SOLID LT & RT  
 STA. 297+26 TO 297+50, DASHED LT, SOLID RT

**TEMPORARY 4 INCH WHITE LINE, PAINT**  
 (ALL LINES WILL INCLUDE EDGE LINE BREAKS AND  
 RADII FOR SIDE ROADS)  
 STA. 291+50 TO 297+50, SOLID LT & RT

**TEMPORARY 4 INCH YELLOW LINE, PAINT**  
 (ALL LINES WILL INCLUDE C BREAKS FOR SIDE ROADS)  
 STA. 291+50 TO 295+68, SOLID LT, DASHED RT  
 STA. 295+68 TO 297+26, SOLID LT & RT  
 STA. 297+26 TO 297+50, DASHED LT, SOLID RT

**REMOVING SIGNS**  
 AS SHOWN - 3

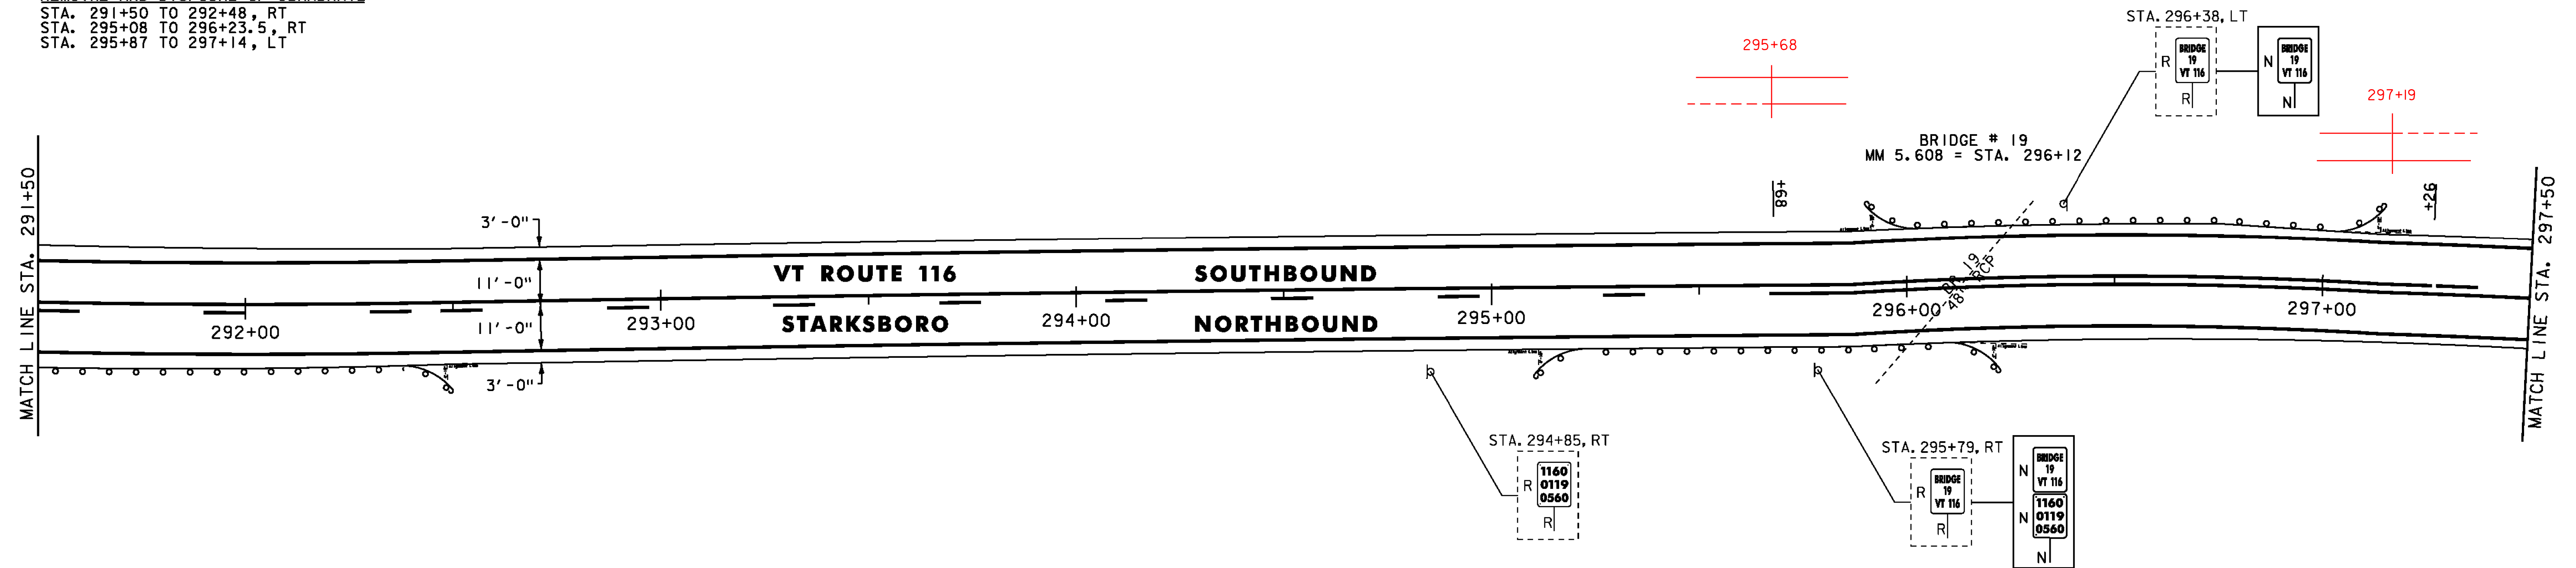

**STEEL BEAM GUARDRAIL, GALVANIZED**  
 STA. 301+60 TO 303+50, LT

**ANCHOR FOR STEEL BEAM RAIL**  
 STA. 301+60, LT


**REMOVAL AND DISPOSAL OF GUARDRAIL**  
 STA. 301+62 TO 303+50, LT

**DURABLE 4 INCH WHITE LINE**  
 (ALL LINES WILL INCLUDE EDGE LINE BREAKS AND  
 RADII FOR SIDE ROADS)  
 STA. 297+50 TO 303+50, SOLID LT & RT

**DURABLE 4 INCH YELLOW LINE**  
 (ALL LINES WILL INCLUDE C BREAKS FOR SIDE ROADS)  
 STA. 297+50 TO 303+50, DASHED LT, SOLID RT

**TEMPORARY 4 INCH WHITE LINE, PAINT**  
 (ALL LINES WILL INCLUDE EDGE LINE BREAKS AND  
 RADII FOR SIDE ROADS)  
 STA. 297+50 TO 303+50, SOLID LT & RT

**TEMPORARY 4 INCH YELLOW LINE, PAINT**  
 (ALL LINES WILL INCLUDE C BREAKS FOR SIDE ROADS)  
 STA. 297+50 TO 303+50, DASHED LT, SOLID RT

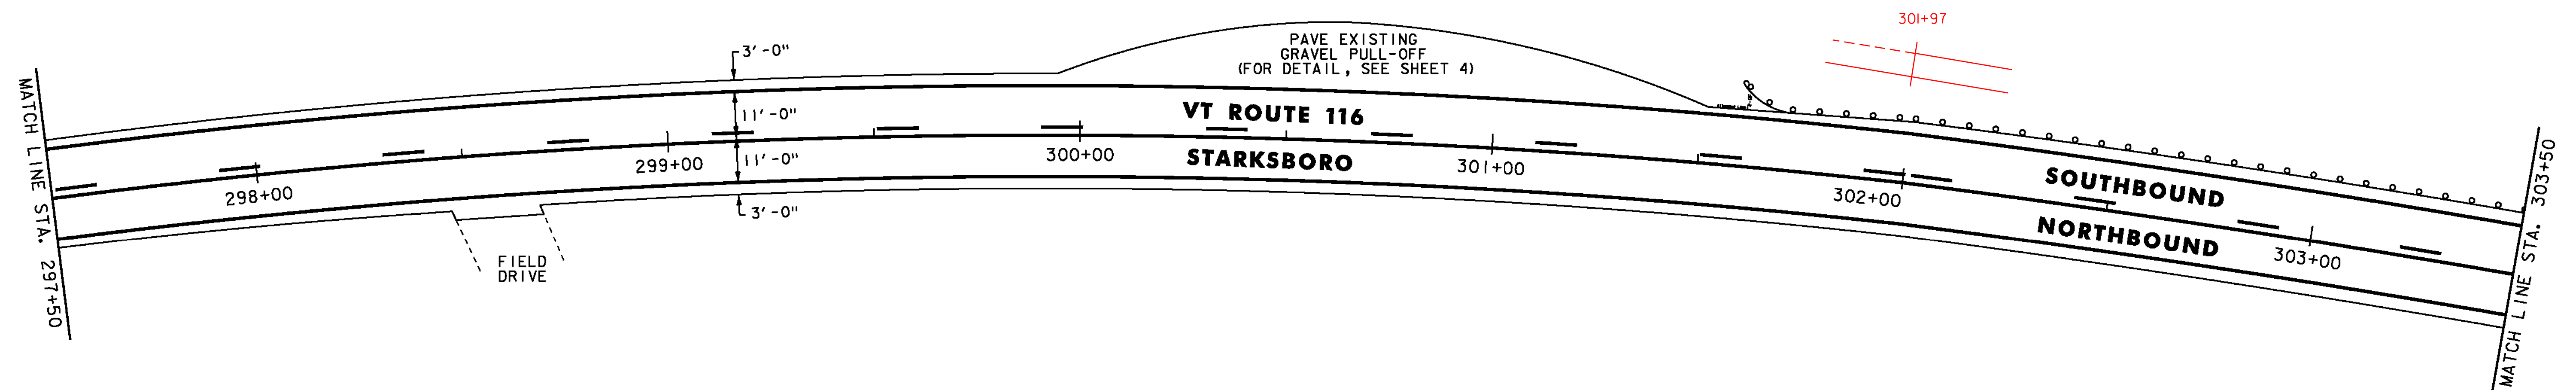

- NOTES:  
 1. FOR LEGENDS, SEE SHEET 21.  
 2. ALL EXISTING SIGNS NOT SHOWN SHALL BE RETAINED.  
 3. SEE QUANTITY SHEETS FOR DURABLE PAVEMENT MARKING OPTIONS.

NOT TO SCALE

**PROJECT LAYOUT SHEET #21**

PROJECT NAME: STARKSBORO-HINESBURG  
 PROJECT NUMBER: STP 2930(I)

FILE NAME: pl0b266.dgn  
 PROJECT LEADER: JLL  
 DESIGNED BY: STANTEC  
 IPARM FILE: p10b266121.i

PLOT DATE: 28-NOV-2012  
 DRAWN BY: STANTEC  
 CHECKED BY: MCF  
 SHEET 41 OF 119

