

**STEEL BEAM GUARDRAIL, GALVANIZED**  
 STA. 303+50 TO 305+60, LT  
 STA. 306+85 TO 309+35, LT

**ANCHOR FOR STEEL BEAM RAIL**  
 STA. 305+60, LT  
 STA. 306+85, LT  
 STA. 309+35, LT

**REMOVAL AND DISPOSAL OF GUARDRAIL**  
 STA. 303+50 TO 305+63, LT  
 STA. 306+84 TO 309+36.5, LT


**DURABLE 4 INCH WHITE LINE**  
 (ALL LINES WILL INCLUDE EDGE LINE BREAKS AND  
 RADII FOR SIDE ROADS)  
 STA. 303+50 TO 309+50, SOLID LT & RT

**DURABLE 4 INCH YELLOW LINE**  
 (ALL LINES WILL INCLUDE C BREAKS FOR SIDE ROADS)  
 STA. 303+50 TO 303+60, DASHED LT, SOLID RT  
 STA. 303+60 TO 309+50, SOLID LT & RT

**TEMPORARY 4 INCH WHITE LINE, PAINT**  
 (ALL LINES WILL INCLUDE EDGE LINE BREAKS AND  
 RADII FOR SIDE ROADS)  
 STA. 303+50 TO 309+50, SOLID LT & RT

**TEMPORARY 4 INCH YELLOW LINE, PAINT**  
 (ALL LINES WILL INCLUDE C BREAKS FOR SIDE ROADS)  
 STA. 303+50 TO 303+60, DASHED LT, SOLID RT  
 STA. 303+60 TO 309+50, SOLID LT & RT

**REMOVING SIGNS**  
 AS SHOWN - 1

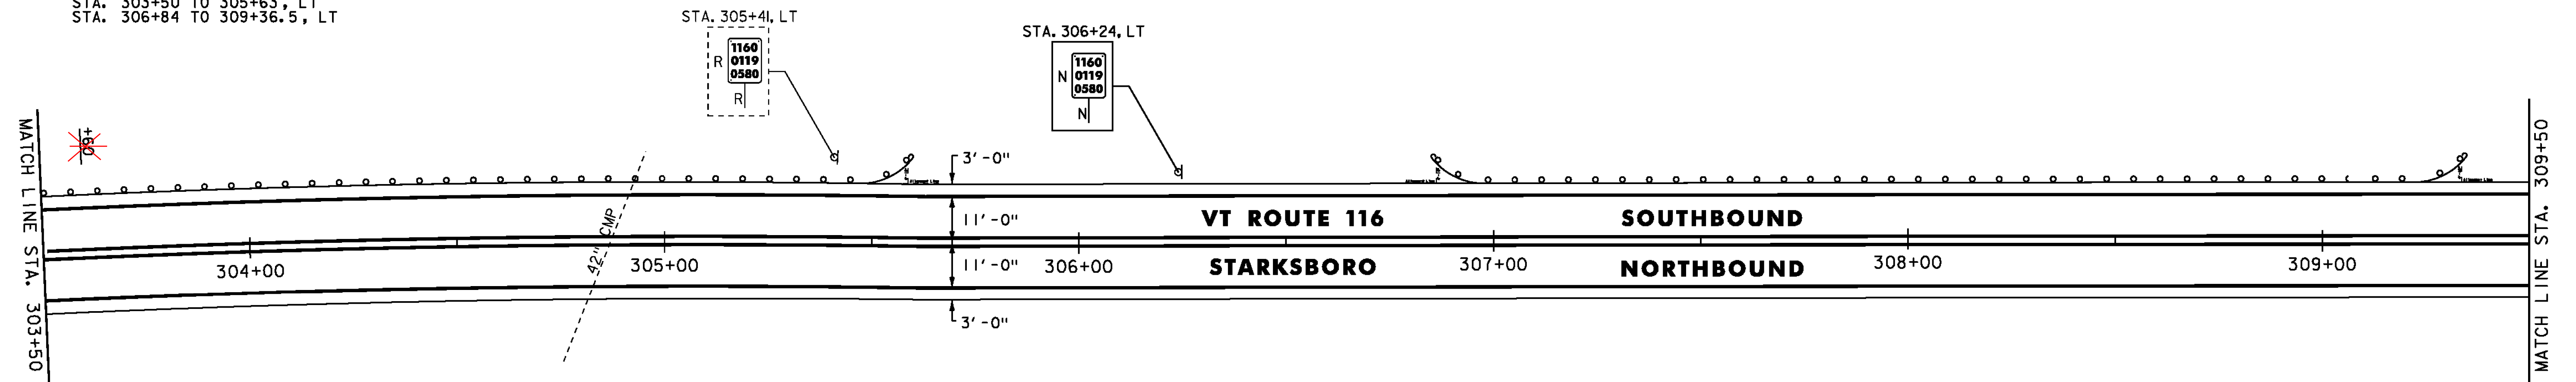

**STEEL BEAM GUARDRAIL, GALVANIZED**  
 STA. 312+98 TO 315+50, RT

**ANCHOR FOR STEEL BEAM RAIL**  
 STA. 312+98, RT

**REMOVAL AND DISPOSAL OF GUARDRAIL**  
 STA. 312+96.5 TO 315+50, RT


**DURABLE 4 INCH WHITE LINE**  
 (ALL LINES WILL INCLUDE EDGE LINE BREAKS AND  
 RADII FOR SIDE ROADS)  
 STA. 309+50 TO 315+50, SOLID LT & RT

**DURABLE 4 INCH YELLOW LINE**  
 (ALL LINES WILL INCLUDE C BREAKS FOR SIDE ROADS)  
 STA. 309+50 TO 315+50, SOLID LT & RT

**TEMPORARY 4 INCH WHITE LINE, PAINT**  
 (ALL LINES WILL INCLUDE EDGE LINE BREAKS AND  
 RADII FOR SIDE ROADS)  
 STA. 309+50 TO 315+50, SOLID LT & RT

**TEMPORARY 4 INCH YELLOW LINE, PAINT**  
 (ALL LINES WILL INCLUDE C BREAKS FOR SIDE ROADS)  
 STA. 309+50 TO 315+50, SOLID LT & RT

**REMOVING SIGNS**  
 AS SHOWN - 1

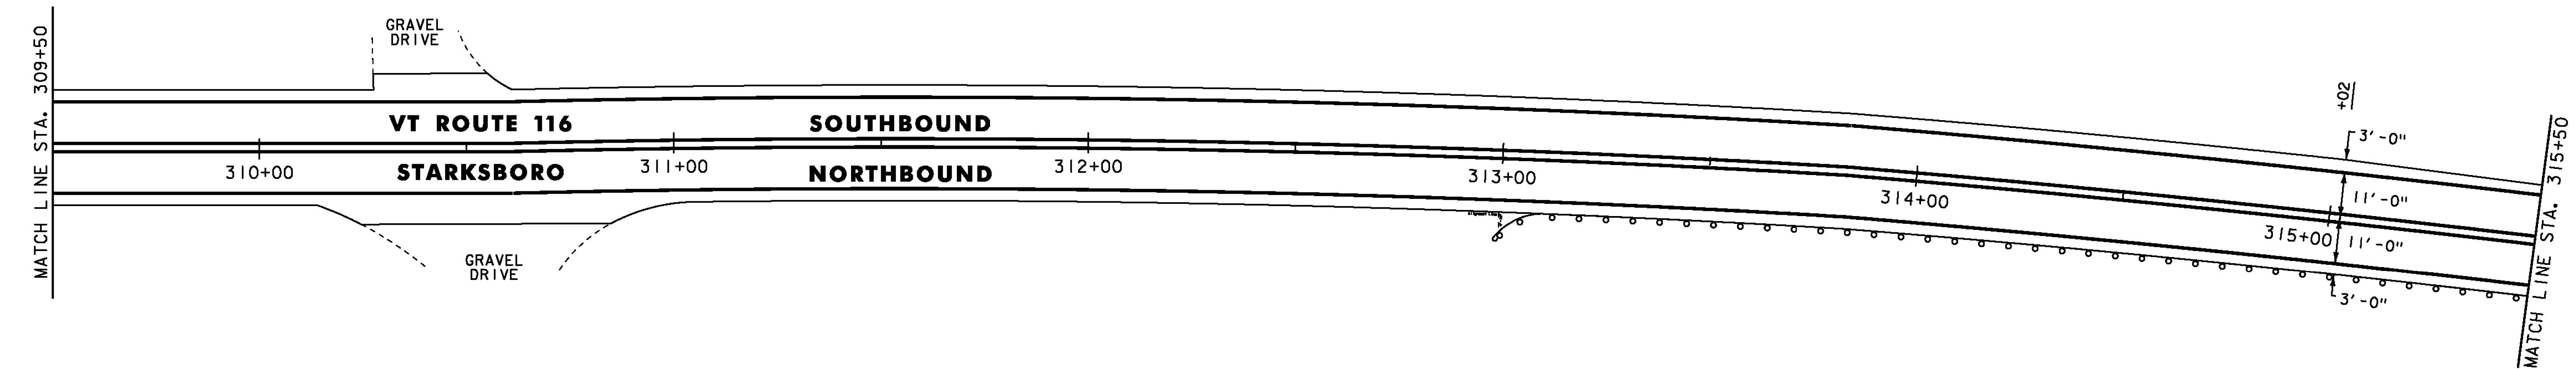

- NOTES:  
 1. FOR LEGENDS, SEE SHEET 21.  
 2. ALL EXISTING SIGNS NOT SHOWN SHALL BE RETAINED.  
 3. SEE QUANTITY SHEETS FOR DURABLE PAVEMENT MARKING OPTIONS.

NOT TO SCALE

<b>PROJECT LAYOUT SHEET #22</b>	PROJECT NAME: STARKSBORO-HINESBURG
	PROJECT NUMBER: STP 2930(I)
FILE NAME: p10b266.dgn	PLOT DATE: 28-NOV-2012
PROJECT LEADER: JLL	DRAWN BY: STANTEC
DESIGNED BY: STANTEC	CHECKED BY: MCF
IPARM FILE: p10b266122.i	SHEET 42 OF 119

