


DURABLE 4 INCH WHITE LINE
 (ALL LINES WILL INCLUDE EDGE LINE BREAKS AND RADI FOR SIDE ROADS)
 STA. 339+50 TO 345+50, SOLID LT & RT

DURABLE 4 INCH YELLOW LINE
 (ALL LINES WILL INCLUDE C BREAKS FOR SIDE ROADS)
 STA. 339+50 TO 345+50, DASHED LT, SOLID RT

TEMPORARY 4 INCH WHITE LINE, PAINT
 (ALL LINES WILL INCLUDE EDGE LINE BREAKS AND RADI FOR SIDE ROADS)
 STA. 339+50 TO 345+50, SOLID LT & RT

TEMPORARY 4 INCH YELLOW LINE, PAINT
 (ALL LINES WILL INCLUDE C BREAKS FOR SIDE ROADS)
 STA. 339+50 TO 345+50, DASHED LT, SOLID RT

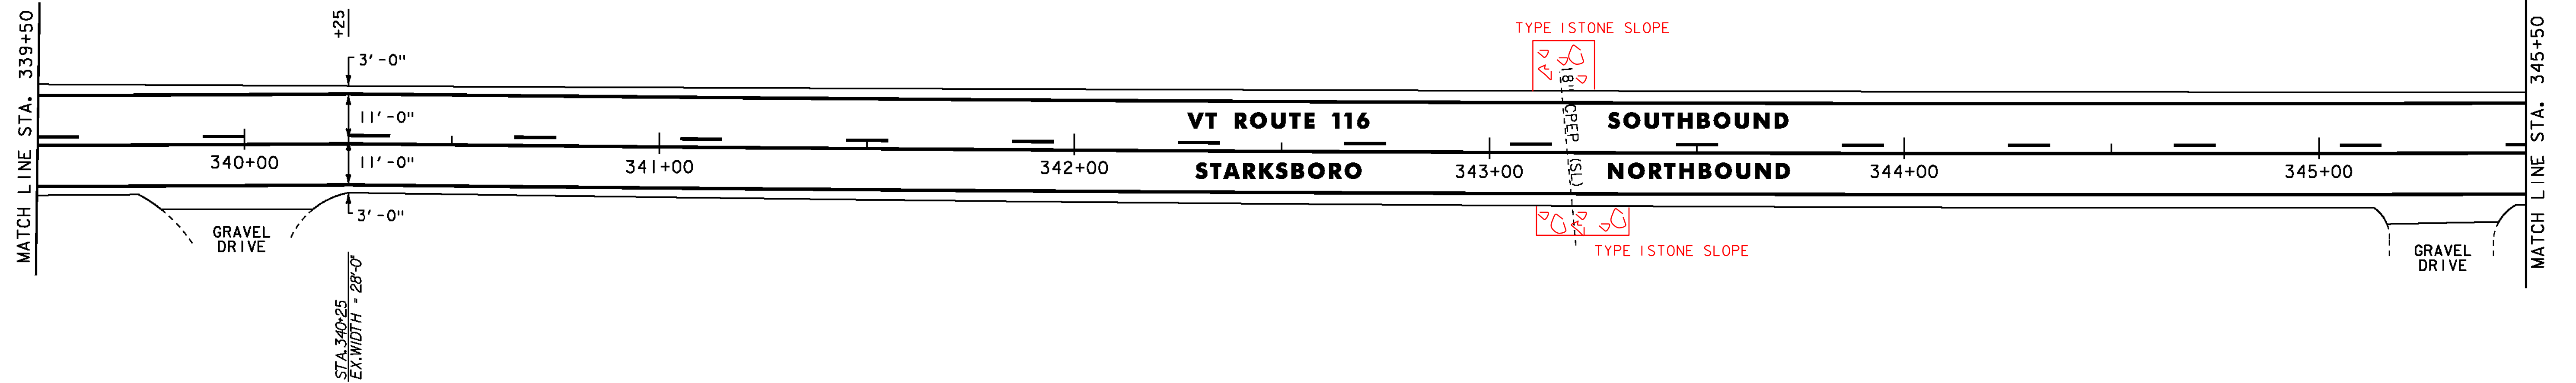

STEEL BEAM GUARDRAIL, GALVANIZED
 STA. 350+20 TO 351+45, RT

STEEL BEAM GUARDRAIL, GALVANIZED W/8 FEET POSTS
 STA. 350+43 TO 351+50, LT

ANCHOR FOR STEEL BEAM RAIL
 STA. 350+20, RT
 STA. 350+43, LT
 STA. 351+45, RT


REMOVAL AND DISPOSAL OF GUARDRAIL
 STA. 350+22 TO 351+49.5, RT
 STA. 350+42.5 TO 351+50, LT

DURABLE 4 INCH WHITE LINE
 (ALL LINES WILL INCLUDE EDGE LINE BREAKS AND RADI FOR SIDE ROADS)
 STA. 345+50 TO 351+50, SOLID LT & RT

DURABLE 4 INCH YELLOW LINE
 (ALL LINES WILL INCLUDE C BREAKS FOR SIDE ROADS)
 STA. 345+50 TO 346+90, DASHED LT, SOLID RT
 STA. 346+90 TO 351+12, SOLID LT & RT
 STA. 351+12 TO 351+50, SOLID LT, DASHED RT

TEMPORARY 4 INCH WHITE LINE, PAINT
 (ALL LINES WILL INCLUDE EDGE LINE BREAKS AND RADI FOR SIDE ROADS)
 STA. 345+50 TO 351+50, SOLID LT & RT

TEMPORARY 4 INCH YELLOW LINE, PAINT
 (ALL LINES WILL INCLUDE C BREAKS FOR SIDE ROADS)
 STA. 345+50 TO 346+90, DASHED LT, SOLID RT
 STA. 346+90 TO 351+12, SOLID LT & RT
 STA. 351+12 TO 351+50, SOLID LT, DASHED RT

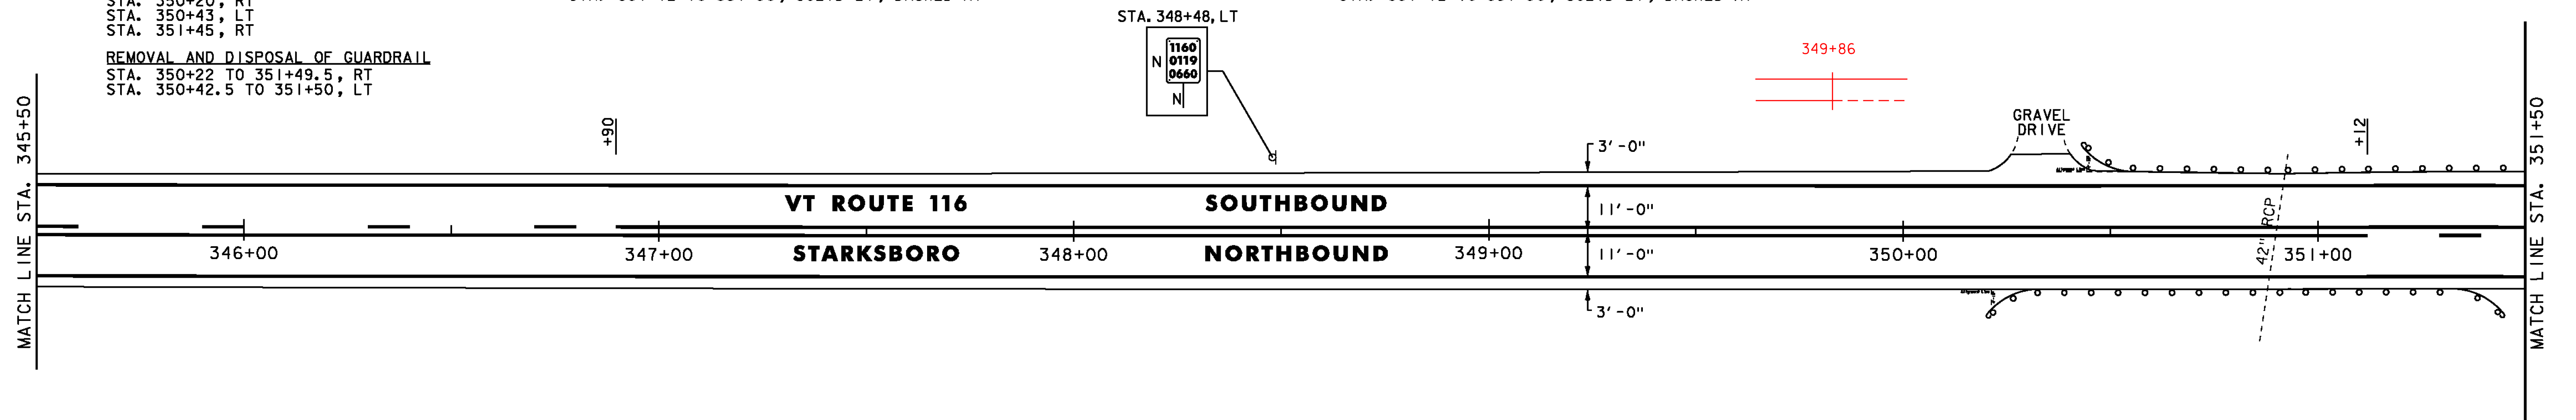

- NOTES:
- FOR LEGENDS, SEE SHEET 21.
 - ALL EXISTING SIGNS NOT SHOWN SHALL BE RETAINED.
 - SEE QUANTITY SHEETS FOR DURABLE PAVEMENT MARKING OPTIONS.

NOT TO SCALE

PROJECT LAYOUT SHEET #25



PROJECT NAME: STARKSBORO-HINESBURG
 PROJECT NUMBER: STP 2930(I)

FILE NAME: p10b266.dgn
 PROJECT LEADER: JLL
 DESIGNED BY: STANTEC
 IPARM FILE: p10b266i25.i

PLOT DATE: 28-NOV-2012
 DRAWN BY: STANTEC
 CHECKED BY: MCF
 SHEET 45 OF 119