

**24 INCH STOP BAR**  
 STA. 14+87, LT (TYLER BRIDGE ROAD TH-25)

**LETTER OR SYMBOL**  
 STA. 14+87, LT "STOP" (TYLER BRIDGE ROAD TH-25)

**DURABLE 4 INCH WHITE LINE**  
 (ALL LINES WILL INCLUDE EDGE LINE BREAKS AND RADIUS FOR SIDE ROADS)  
 STA. 11+50 TO 17+50, SOLID LT & RT  
 STA. 14+87, SOLID LT (EDGE LINES, TYLER BRIDGE ROAD TH-25)

**DURABLE 4 INCH YELLOW LINE**  
 (ALL LINES WILL INCLUDE C BREAKS FOR SIDE ROADS)  
 STA. 11+50 TO 14+26, DASHED LT, SOLID RT  
 STA. 14+26 TO 17+50, SOLID LT & RT  
 STA. 14+87, DOUBLE SOLID LT (TYLER BRIDGE ROAD TH-25)


**TEMPORARY 4 INCH WHITE LINE, PAINT**  
 (ALL LINES WILL INCLUDE EDGE LINE BREAKS AND RADIUS FOR SIDE ROADS)  
 STA. 11+50 TO 17+50, SOLID LT & RT  
 STA. 14+87, SOLID LT (EDGE LINES, TYLER BRIDGE ROAD TH-25)

**TEMPORARY 4 INCH YELLOW LINE, PAINT**  
 (ALL LINES WILL INCLUDE C BREAKS FOR SIDE ROADS)  
 STA. 11+50 TO 14+26, DASHED LT, SOLID RT  
 STA. 14+26 TO 17+50, SOLID LT & RT  
 STA. 14+87, DOUBLE SOLID LT (TYLER BRIDGE ROAD TH-25)

**TEMPORARY 24 INCH STOP BAR, PAINT**  
 STA. 14+87, LT (TYLER BRIDGE ROAD TH-25)

**TEMPORARY LETTER OR SYMBOL, PAINT**  
 STA. 14+87, LT "STOP" (TYLER BRIDGE ROAD TH-25)

**REMOVING SIGNS**  
 AS SHOWN - 5

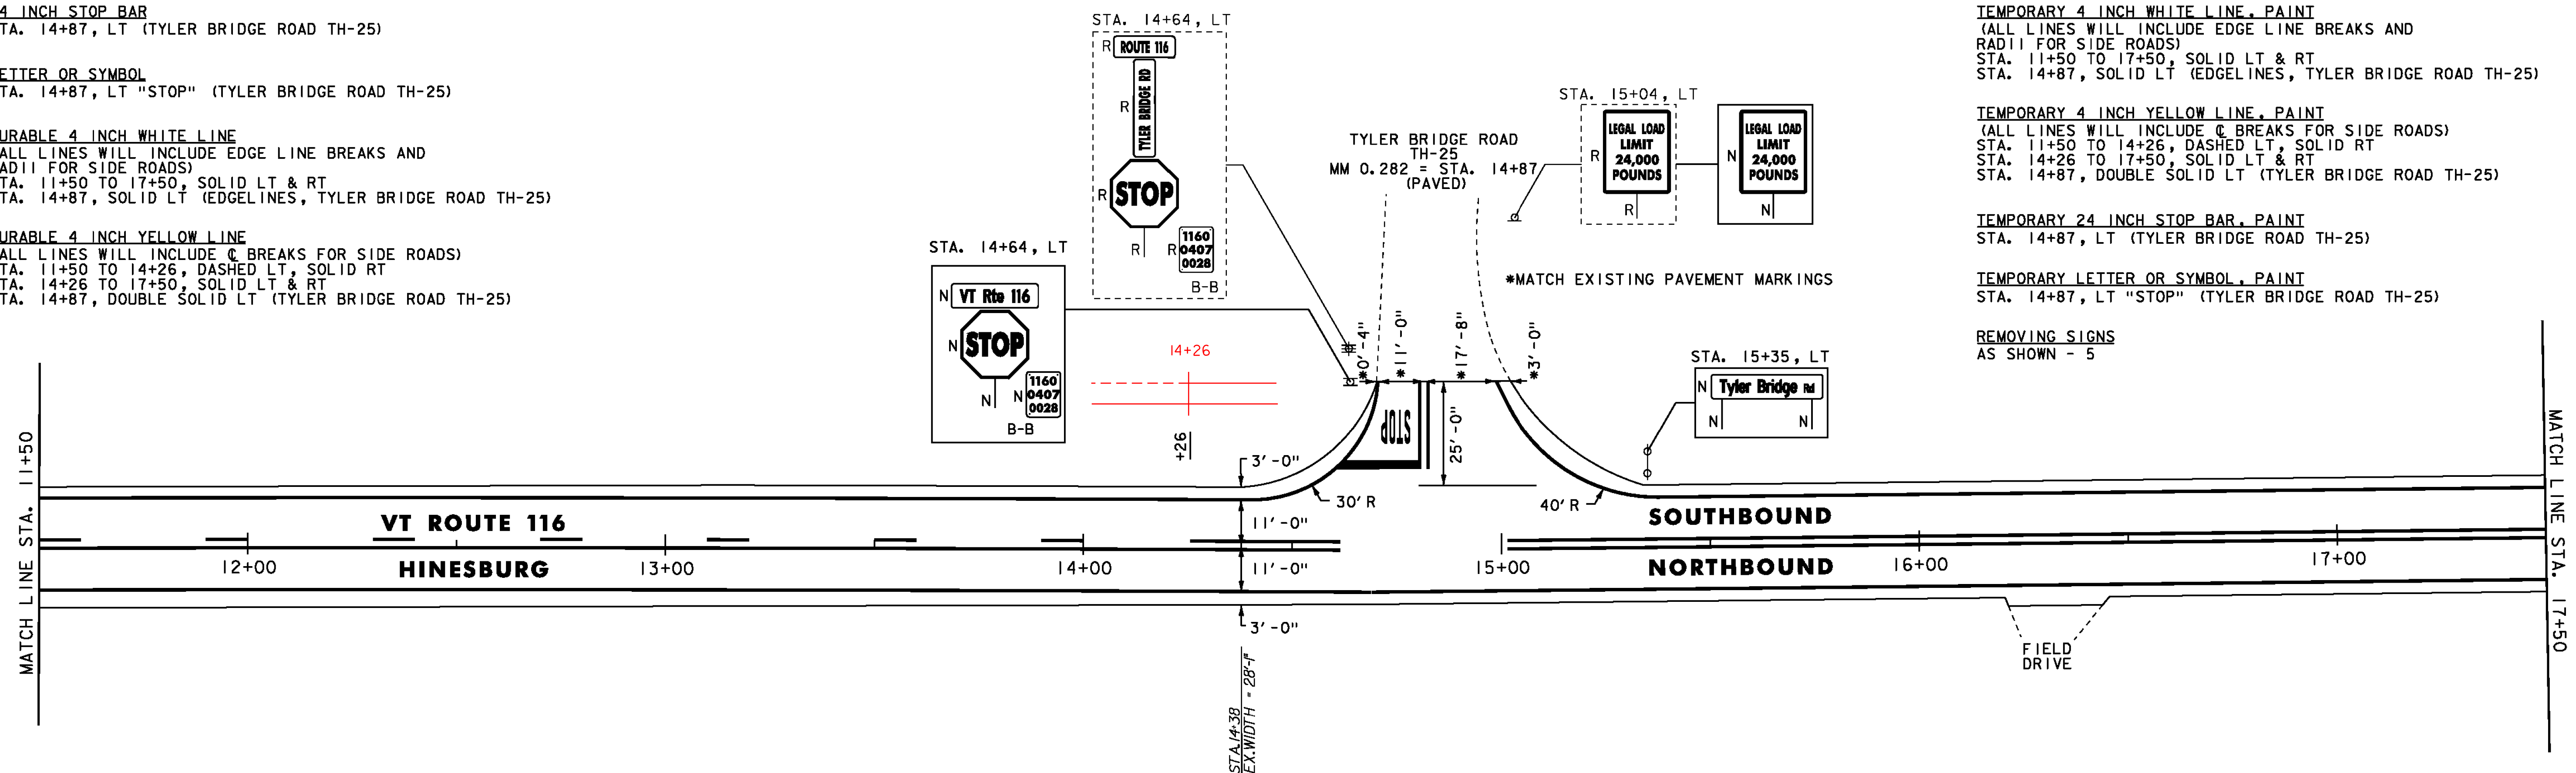


**DURABLE 4 INCH WHITE LINE**  
 (ALL LINES WILL INCLUDE EDGE LINE BREAKS AND RADIUS FOR SIDE ROADS)  
 STA. 17+50 TO 23+50, SOLID LT & RT

**DURABLE 4 INCH YELLOW LINE**  
 (ALL LINES WILL INCLUDE C BREAKS FOR SIDE ROADS)  
 STA. 17+50 TO 23+50, SOLID LT & RT

**TEMPORARY 4 INCH WHITE LINE, PAINT**  
 (ALL LINES WILL INCLUDE EDGE LINE BREAKS AND RADIUS FOR SIDE ROADS)  
 STA. 17+50 TO 23+50, SOLID LT & RT

**TEMPORARY 4 INCH YELLOW LINE, PAINT**  
 (ALL LINES WILL INCLUDE C BREAKS FOR SIDE ROADS)  
 STA. 17+50 TO 23+50, SOLID LT & RT

**REMOVING SIGNS**  
 AS SHOWN - 1

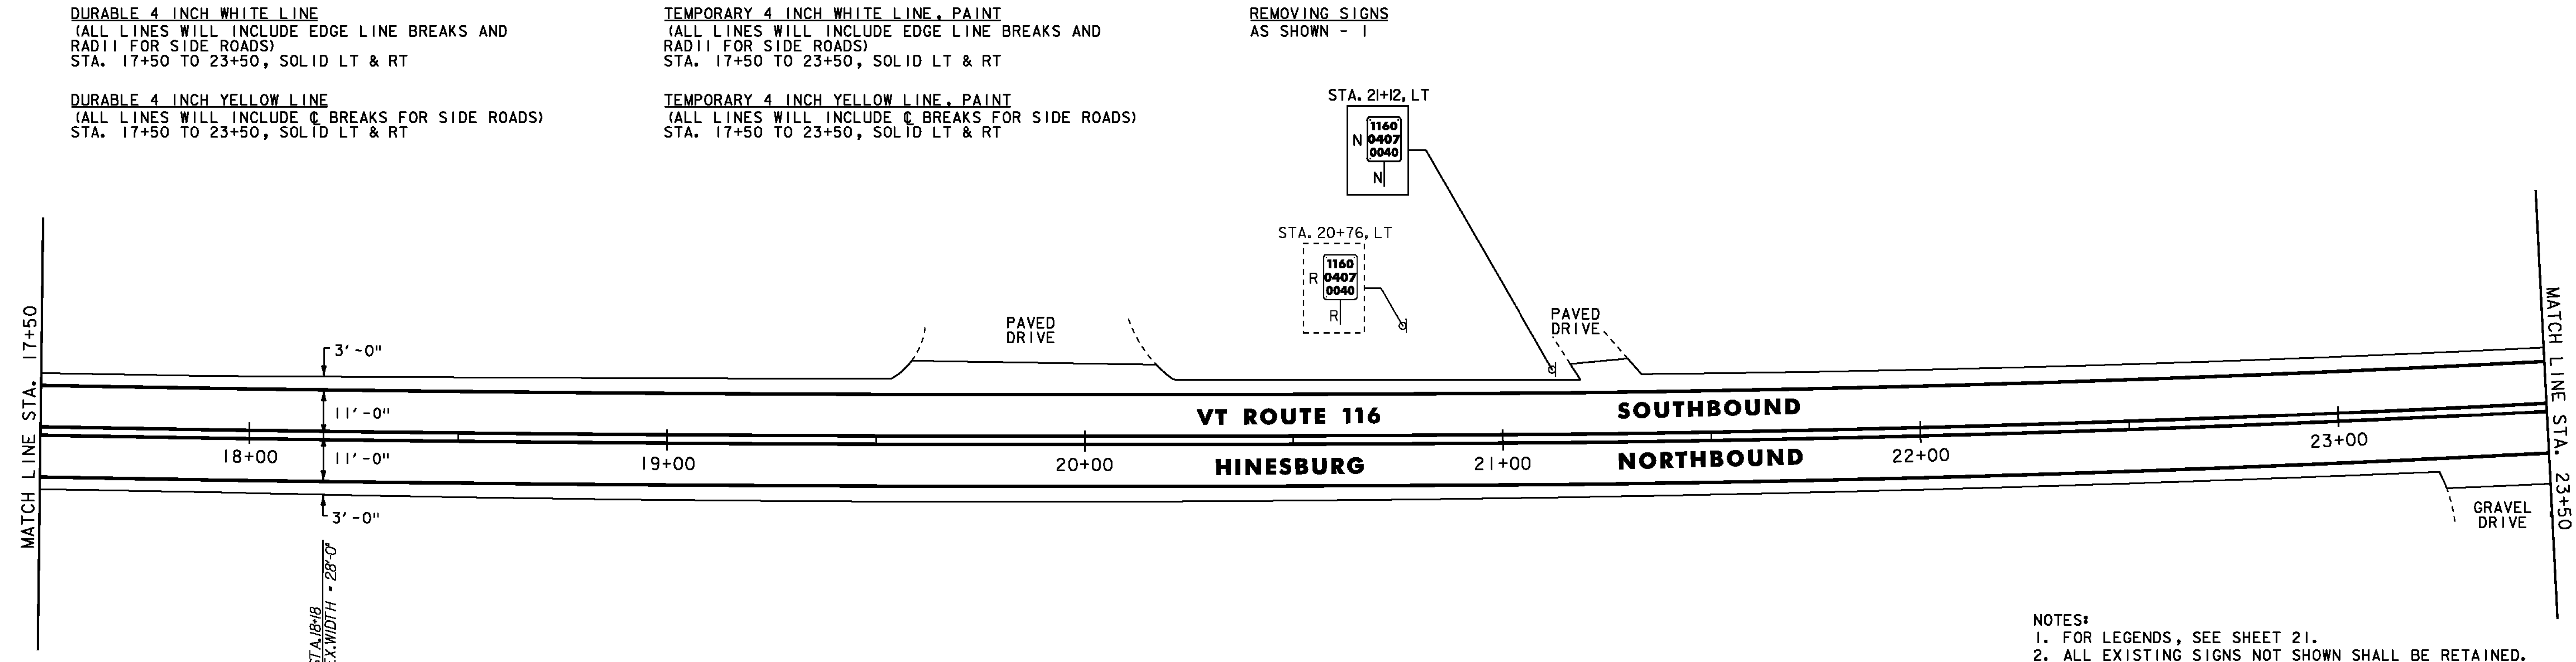

- NOTES:**
1. FOR LEGENDS, SEE SHEET 21.
  2. ALL EXISTING SIGNS NOT SHOWN SHALL BE RETAINED.
  3. SEE QUANTITY SHEETS FOR DURABLE PAVEMENT MARKING OPTIONS.

NOT TO SCALE

**PROJECT LAYOUT SHEET #27**



PROJECT NAME: STARKSBORO-HINESBURG  
 PROJECT NUMBER: STP 2930(1)

FILE NAME: p10b266.dgn  
 PROJECT LEADER: JLL  
 DESIGNED BY: STANTEC  
 IPARM FILE: p10b266(1).i

PLOT DATE: 28-NOV-2012  
 DRAWN BY: STANTEC  
 CHECKED BY: MCF  
 SHEET 47 OF 119