


DURABLE 4 INCH WHITE LINE
 (ALL LINES WILL INCLUDE EDGE LINE BREAKS AND
 RADII FOR SIDE ROADS)
 STA. 95+50 TO 101+50, SOLID LT & RT

TEMPORARY 4 INCH WHITE LINE, PAINT
 (ALL LINES WILL INCLUDE EDGE LINE BREAKS AND
 RADII FOR SIDE ROADS)
 STA. 95+50 TO 101+50, SOLID LT & RT

DURABLE 4 INCH YELLOW LINE
 (ALL LINES WILL INCLUDE C BREAKS FOR SIDE ROADS)
 STA. 95+50 TO 97+42, SOLID LT & RT
 STA. 97+42 TO 101+50, SOLID LT, DASHED RT

TEMPORARY 4 INCH YELLOW LINE, PAINT
 (ALL LINES WILL INCLUDE C BREAKS FOR SIDE ROADS)
 STA. 95+50 TO 97+42, SOLID LT & RT
 STA. 97+42 TO 101+50, SOLID LT, DASHED RT

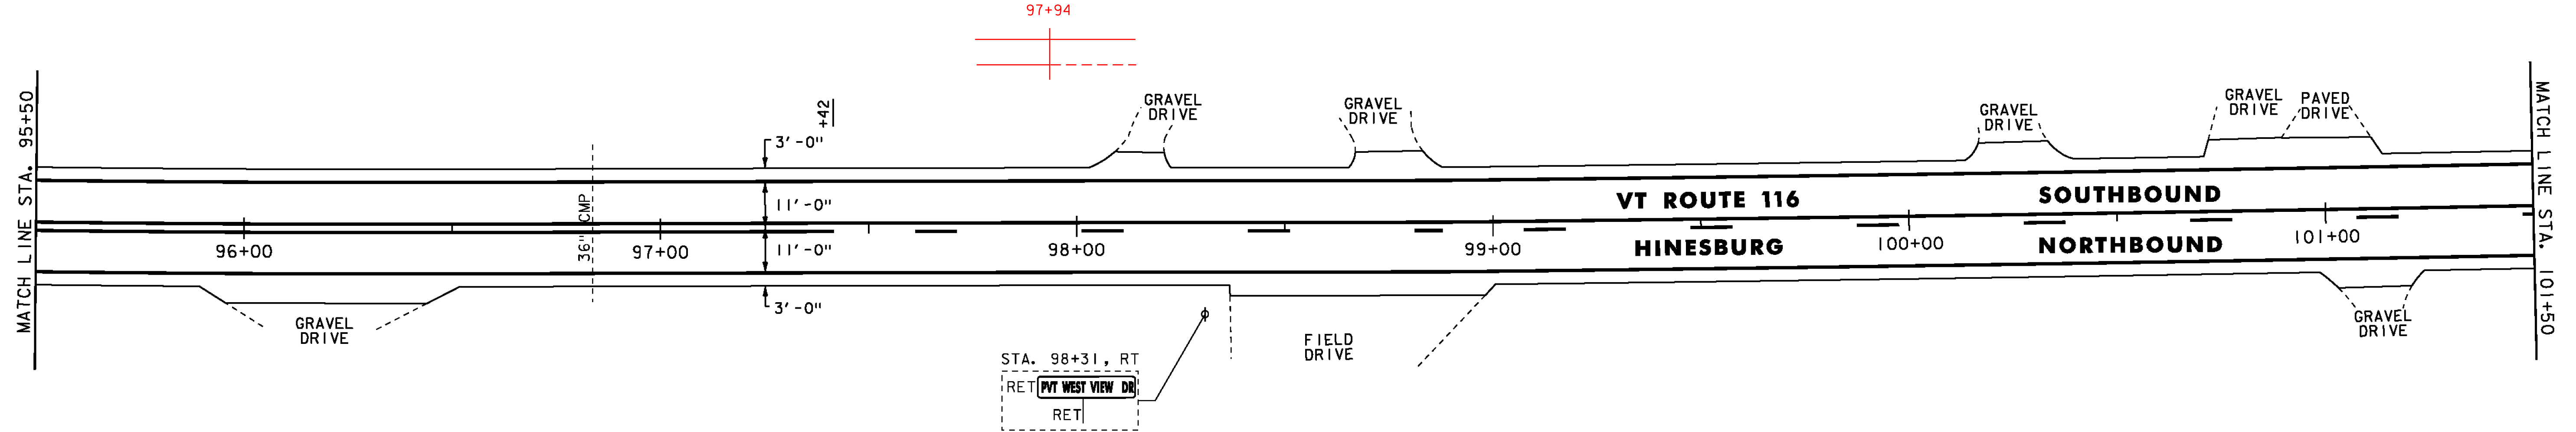

STONE FILL, TYPE I
 STA. 105+86 TO 105+92, LT
 STA. 107+46 TO 107+50, LT

DURABLE 4 INCH WHITE LINE
 (ALL LINES WILL INCLUDE EDGE LINE BREAKS AND
 RADII FOR SIDE ROADS)
 STA. 101+50 TO 107+50, SOLID LT & RT

TEMPORARY 4 INCH WHITE LINE, PAINT
 (ALL LINES WILL INCLUDE EDGE LINE BREAKS AND
 RADII FOR SIDE ROADS)
 STA. 101+50 TO 107+50, SOLID LT & RT

GEOTEXTILE UNDER STONE FILL
 STA. 105+86 TO 105+92, LT
 STA. 107+46 TO 107+50, LT

REMOVING SIGNS
 AS SHOWN - 1


**STEEL BEAM GUARDRAIL, GALVANIZED
 W/8 FEET POSTS**
 STA. 103+29.5 TO 107+50, LT
ANCHOR FOR STEEL BEAM RAIL
 STA. 103+29.5, LT

DURABLE 4 INCH YELLOW LINE
 (ALL LINES WILL INCLUDE C BREAKS FOR SIDE ROADS)
 STA. 101+50 TO 107+18, SOLID LT, DASHED RT
 STA. 107+18 TO 107+50, SOLID LT & RT

TEMPORARY 4 INCH YELLOW LINE, PAINT
 (ALL LINES WILL INCLUDE C BREAKS FOR SIDE ROADS)
 STA. 101+50 TO 107+18, SOLID LT, DASHED RT
 STA. 107+18 TO 107+50, SOLID LT & RT

GRUBBING MATERIAL
 STA. 105+86 TO 105+92, LT
 STA. 107+46 TO 107+50, LT

REMOVAL AND DISPOSAL OF GUARDRAIL
 STA. 103+29 TO 107+50, LT

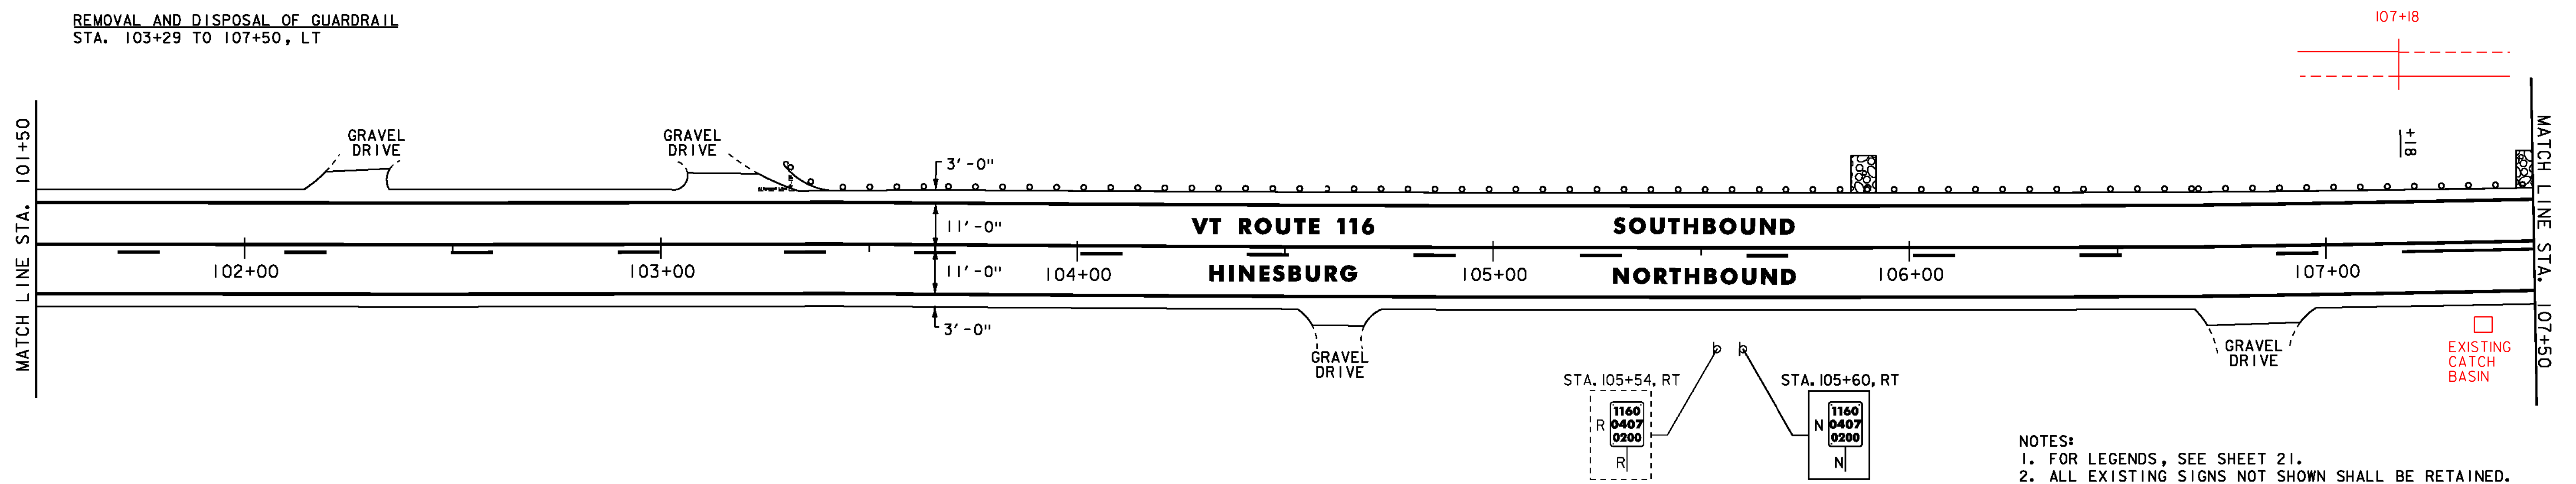

- NOTES:
 1. FOR LEGENDS, SEE SHEET 21.
 2. ALL EXISTING SIGNS NOT SHOWN SHALL BE RETAINED.
 3. SEE QUANTITY SHEETS FOR DURABLE PAVEMENT MARKING OPTIONS.

NOT TO SCALE

**PROJECT
 LAYOUT
 SHEET #34**



PROJECT NAME: STARKSBORO-HINESBURG
 PROJECT NUMBER: STP 2930(I)

FILE NAME: p10b266.dgn PLOT DATE: 28-NOV-2012
 PROJECT LEADER: JLL DRAWN BY: STANTEC
 DESIGNED BY: STANTEC CHECKED BY: MCF
 IPARM FILE: p10b266i34.i SHEET 54 OF 119