


STEEL BEAM GUARDRAIL, GALVANIZED  
 STA. 122+65 TO 125+50, RT  
 ANCHOR FOR STEEL BEAM RAIL  
 STA. 122+65, RT  
 REMOVAL AND DISPOSAL OF GUARDRAIL  
 STA. 122+65 TO 125+50, RT

24 INCH STOP BAR  
 STA. 121+12, RT (NORTH ROAD TH-9)  
 LETTER OR SYMBOL  
 STA. 121+12, RT "STOP" (NORTH ROAD TH-9)  
 DURABLE 4 INCH WHITE LINE  
 (ALL LINES WILL INCLUDE EDGE LINE BREAKS AND  
 RADI FOR SIDE ROADS)  
 STA. 119+50 TO 125+50, SOLID LT & RT  
 STA. 121+12, SOLID RT (EDGELINES, NORTH ROAD TH-9)  
 DURABLE 4 INCH YELLOW LINE  
 (ALL LINES WILL INCLUDE C BREAKS FOR SIDE ROADS)  
 STA. 119+50 TO 125+50, SOLID LT & RT  
 STA. 121+12, DOUBLE SOLID RT (NORTH ROAD TH-9)

TEMPORARY 4 INCH WHITE LINE, PAINT  
 (ALL LINES WILL INCLUDE EDGE LINE BREAKS AND  
 RADI FOR SIDE ROADS)  
 STA. 119+50 TO 125+50, SOLID LT & RT  
 STA. 121+12, SOLID RT (EDGELINES, NORTH ROAD TH-9)  
 TEMPORARY 4 INCH YELLOW LINE, PAINT  
 (ALL LINES WILL INCLUDE C BREAKS FOR SIDE ROADS)  
 STA. 119+50 TO 125+50, SOLID LT & RT  
 STA. 121+12, DOUBLE SOLID RT (NORTH ROAD TH-9)

TEMPORARY 24 INCH STOP BAR, PAINT  
 STA. 121+12, RT (NORTH ROAD TH-9)  
 TEMPORARY LETTER OR SYMBOL, PAINT  
 STA. 121+12, RT "STOP" (NORTH ROAD TH-9)  
 REMOVING SIGNS  
 AS SHOWN - 7

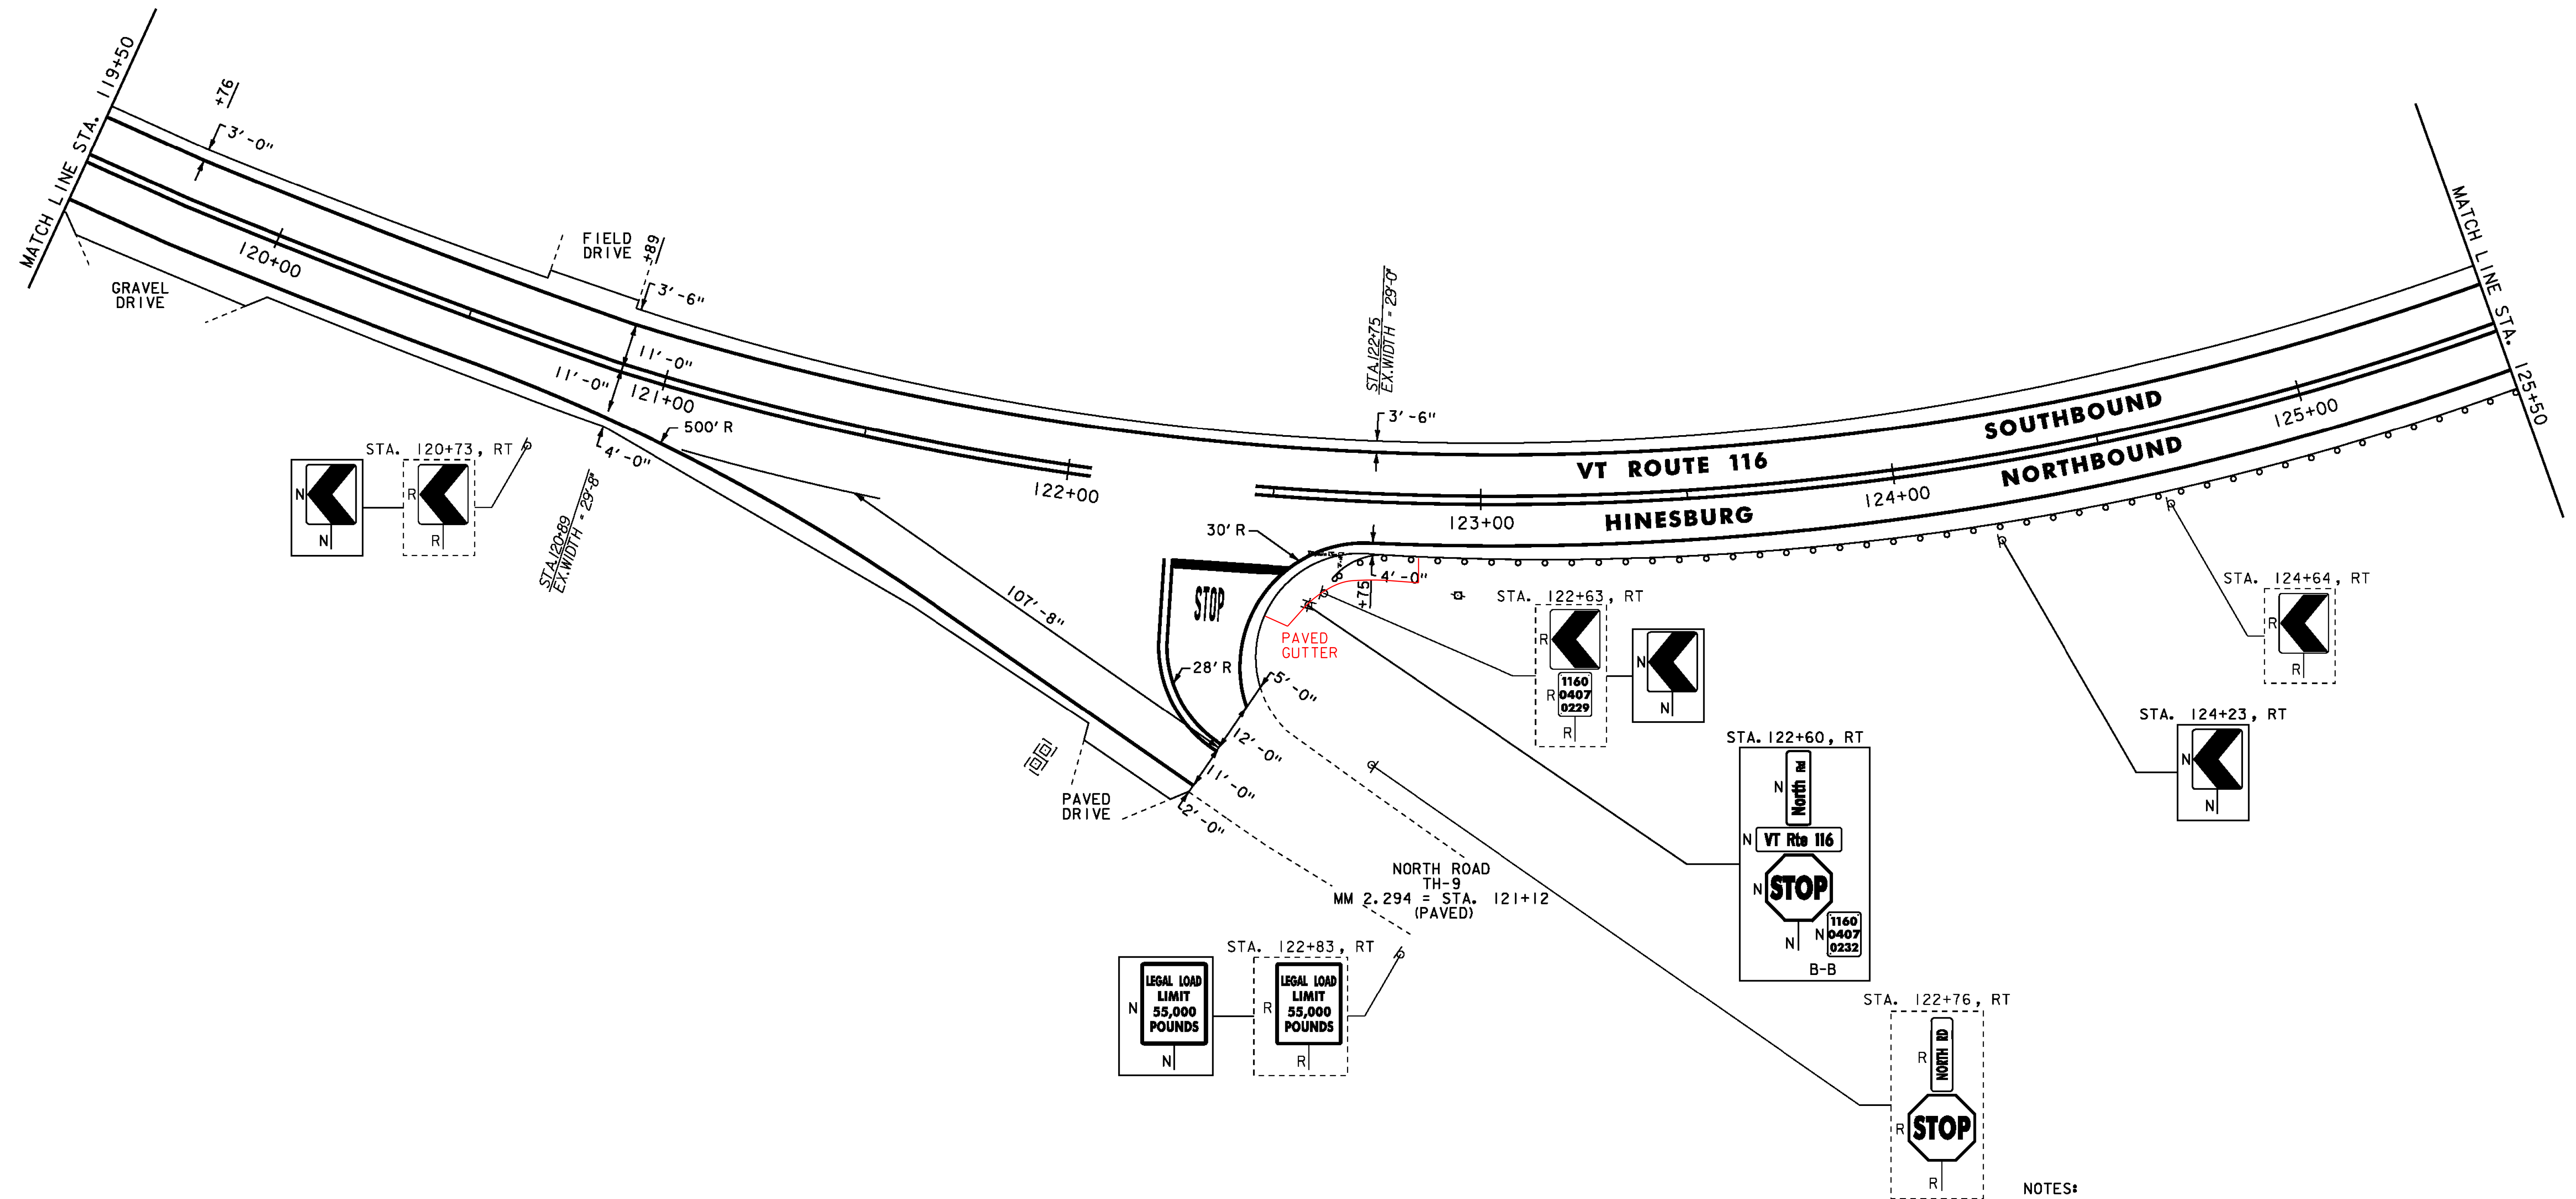

NOTES:  
 1. FOR LEGENDS, SEE SHEET 21.  
 2. ALL EXISTING SIGNS NOT SHOWN SHALL BE RETAINED.  
 3. SEE QUANTITY SHEETS FOR DURABLE PAVEMENT MARKING OPTIONS.

NOT TO SCALE

<b>PROJECT LAYOUT SHEET #36</b>	PROJECT NAME: STARKSBORO-HINESBURG
	PROJECT NUMBER: STP 2930(I)
FILE NAME: p10b266.dgn	PLOT DATE: 28-NOV-2012
PROJECT LEADER: JLL	DRAWN BY: STANTEC
DESIGNED BY: STANTEC	CHECKED BY: MCF
IPARM FILE: p10b266136.i	SHEET 56 OF 119

