



STONE FILL, TYPE I STA. 127+79 TO 127+87, LT	STEEL BEAM GUARDRAIL, GALVANIZED W/8 FEET POSTS STA. 126+62.5 TO 130+00, LT	DURABLE 4 INCH WHITE LINE (ALL LINES WILL INCLUDE EDGE LINE BREAKS AND RADI FOR SIDE ROADS) STA. 125+50 TO 130+50, SOLID LT & RT	TEMPORARY 4 INCH WHITE LINE, PAINT (ALL LINES WILL INCLUDE EDGE LINE BREAKS AND RADI FOR SIDE ROADS) STA. 125+50 TO 130+50, SOLID LT & RT	GEOTEXTILE UNDER STONE FILL STA. 127+79 TO 127+87, LT	REMOVING SIGNS AS SHOWN - 1
BITUMINOUS CONCRETE CURB, TYPE A STA. 126+93 TO 128+19, LT STA. 128+25 TO 129+44, LT	ANCHOR FOR STEEL BEAM RAIL STA. 126+62.5, LT STA. 130+00, LT	DURABLE 4 INCH YELLOW LINE (ALL LINES WILL INCLUDE C BREAKS FOR SIDE ROADS) STA. 125+50 TO 128+04, SOLID LT & RT STA. 128+04 TO 130+50, SOLID LT, DASHED RT	TEMPORARY 4 INCH YELLOW LINE, PAINT (ALL LINES WILL INCLUDE C BREAKS FOR SIDE ROADS) STA. 125+50 TO 128+04, SOLID LT & RT STA. 128+04 TO 130+50, SOLID LT, DASHED RT	GRUBBING MATERIAL STA. 127+79 TO 127+87, LT	
BITUMINOUS CONCRETE GUTTERS AND TRAFFIC ISLANDS STA. 128+22, LT FOR DETAIL, SEE SHEET 18.	REMOVAL AND DISPOSAL OF GUARDRAIL STA. 125+50 TO 130+50, RT STA. 126+66 TO 130+00, LT				
STEEL BEAM GUARDRAIL, GALVANIZED STA. 125+50 TO 130+50, RT					

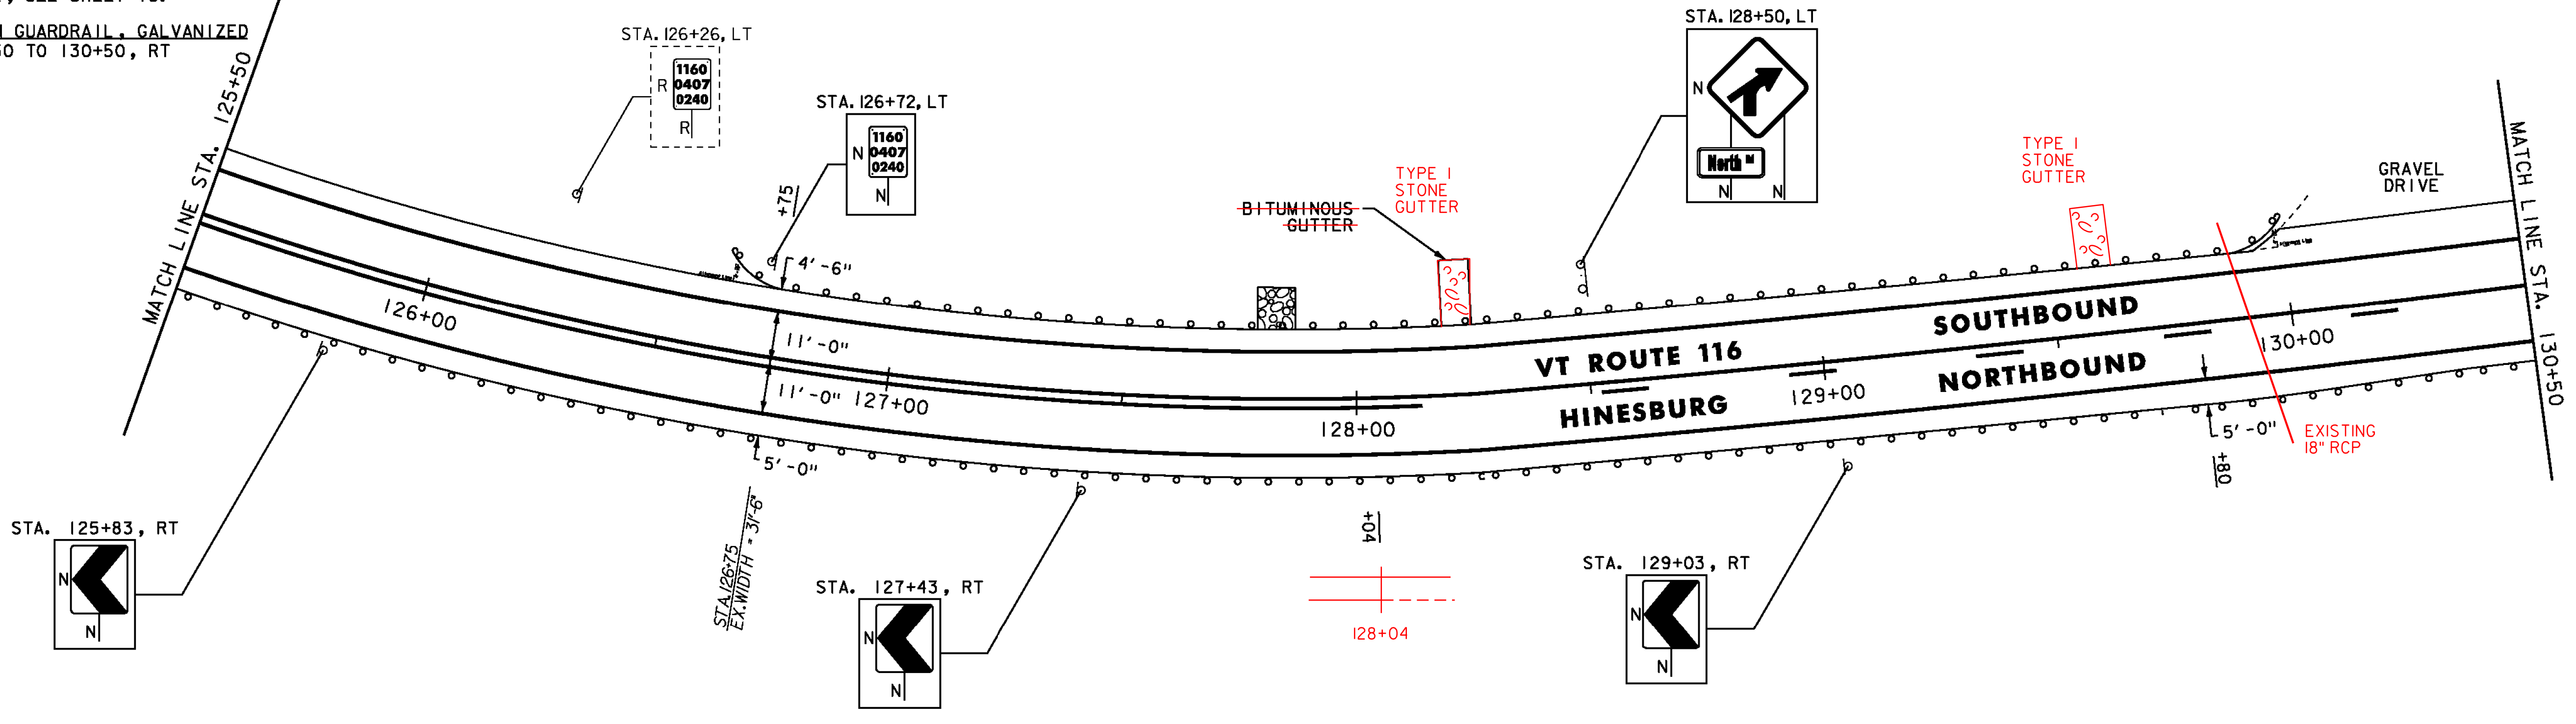

BITUMINOUS CONCRETE CURB, TYPE A STA. 133+38.5 TO 135+01.5, RT STA. 135+08.5 TO 136+50, RT	STEEL BEAM GUARDRAIL, GALVANIZED STA. 130+50 TO 130+90, RT STA. 131+25.5 TO 133+38, RT	REMOVAL AND DISPOSAL OF GUARDRAIL STA. 130+50 TO 130+87, RT STA. 131+26 TO 136+50, RT	TEMPORARY 4 INCH WHITE LINE, PAINT (ALL LINES WILL INCLUDE EDGE LINE BREAKS AND RADI FOR SIDE ROADS) STA. 130+50 TO 136+50, SOLID LT & RT
BITUMINOUS CONCRETE GUTTERS AND TRAFFIC ISLANDS STA. 135+05, RT FOR DETAIL, SEE SHEET 18.	STEEL BEAM GUARDRAIL, GALVANIZED W/8 FEET POSTS STA. 133+38 TO 136+50, RT	DURABLE 4 INCH WHITE LINE (ALL LINES WILL INCLUDE EDGE LINE BREAKS AND RADI FOR SIDE ROADS) STA. 130+50 TO 136+50, SOLID LT & RT	TEMPORARY 4 INCH YELLOW LINE, PAINT (ALL LINES WILL INCLUDE C BREAKS FOR SIDE ROADS) STA. 130+50 TO 136+22, SOLID LT, DASHED RT STA. 136+22 TO 136+50, DASHED C
	ANCHOR FOR STEEL BEAM RAIL STA. 130+90, RT STA. 131+25.5, RT	DURABLE 4 INCH YELLOW LINE (ALL LINES WILL INCLUDE C BREAKS FOR SIDE ROADS) STA. 130+50 TO 136+22, SOLID LT, DASHED RT STA. 136+22 TO 136+50, DASHED C	

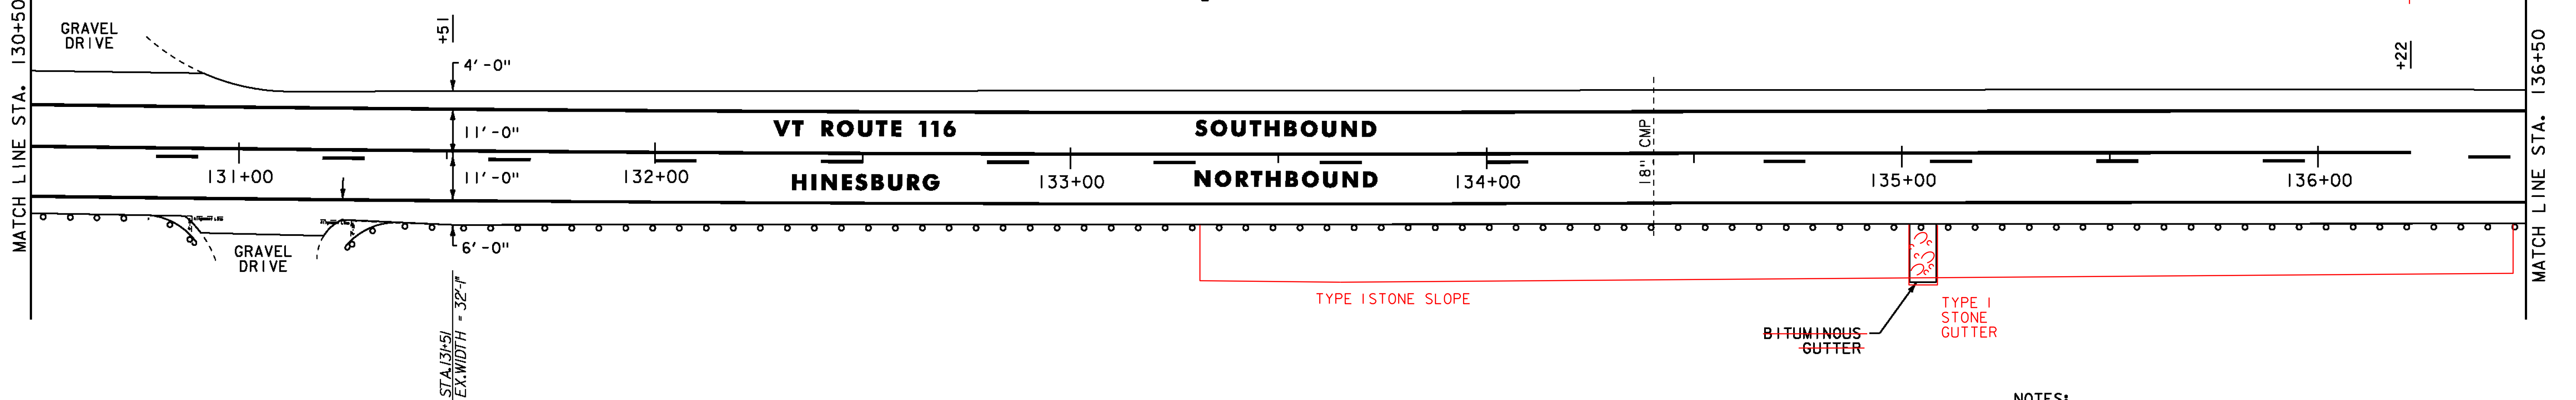

NOTES:
 1. FOR LEGENDS, SEE SHEET 21.
 2. ALL EXISTING SIGNS NOT SHOWN SHALL BE RETAINED.
 3. SEE QUANTITY SHEETS FOR DURABLE PAVEMENT MARKING OPTIONS.

PROJECT LAYOUT SHEET #37	PROJECT NAME: STARKSBORO-HINESBURG PROJECT NUMBER: STP 2930(I)
	FILE NAME: p10b266.dgn PROJECT LEADER: JLL DESIGNED BY: STANTEC IPARM FILE: p10b266137.i



PLOT DATE: 28-NOV-2012
 DRAWN BY: STANTEC
 CHECKED BY: MCF
 SHEET 57 OF 119