

BITUMINOUS CONCRETE CURB, TYPE A
 STA. 136+50 TO 137+33.5, RT
 STA. 137+40 TO 140+02.5, RT
 STA. 140+08.5 TO 142+50, RT

STEEL BEAM GUARDRAIL, GALVANIZED W/8 FEET POSTS
 STA. 136+50 TO 142+50, RT

REMOVAL AND DISPOSAL OF GUARDRAIL
 STA. 136+50 TO 142+50, RT

DURABLE 4 INCH WHITE LINE
 (ALL LINES WILL INCLUDE EDGE LINE BREAKS AND RADIUS FOR SIDE ROADS)
 STA. 136+50 TO 142+50, SOLID LT & RT


TEMPORARY 4 INCH WHITE LINE, PAINT
 (ALL LINES WILL INCLUDE EDGE LINE BREAKS AND RADIUS FOR SIDE ROADS)
 STA. 136+50 TO 142+50, SOLID LT & RT

REMOVING SIGNS
 AS SHOWN - 1

BITUMINOUS CONCRETE GUTTERS AND TRAFFIC ISLANDS
 STA. 137+37, RT
 STA. 140+05, RT
 FOR DETAIL, SEE SHEET 18.

DURABLE 4 INCH YELLOW LINE
 (ALL LINES WILL INCLUDE C BREAKS FOR SIDE ROADS)
 STA. 136+50 TO 142+50, DASHED C

TEMPORARY 4 INCH YELLOW LINE, PAINT
 (ALL LINES WILL INCLUDE C BREAKS FOR SIDE ROADS)
 STA. 136+50 TO 142+50, DASHED C

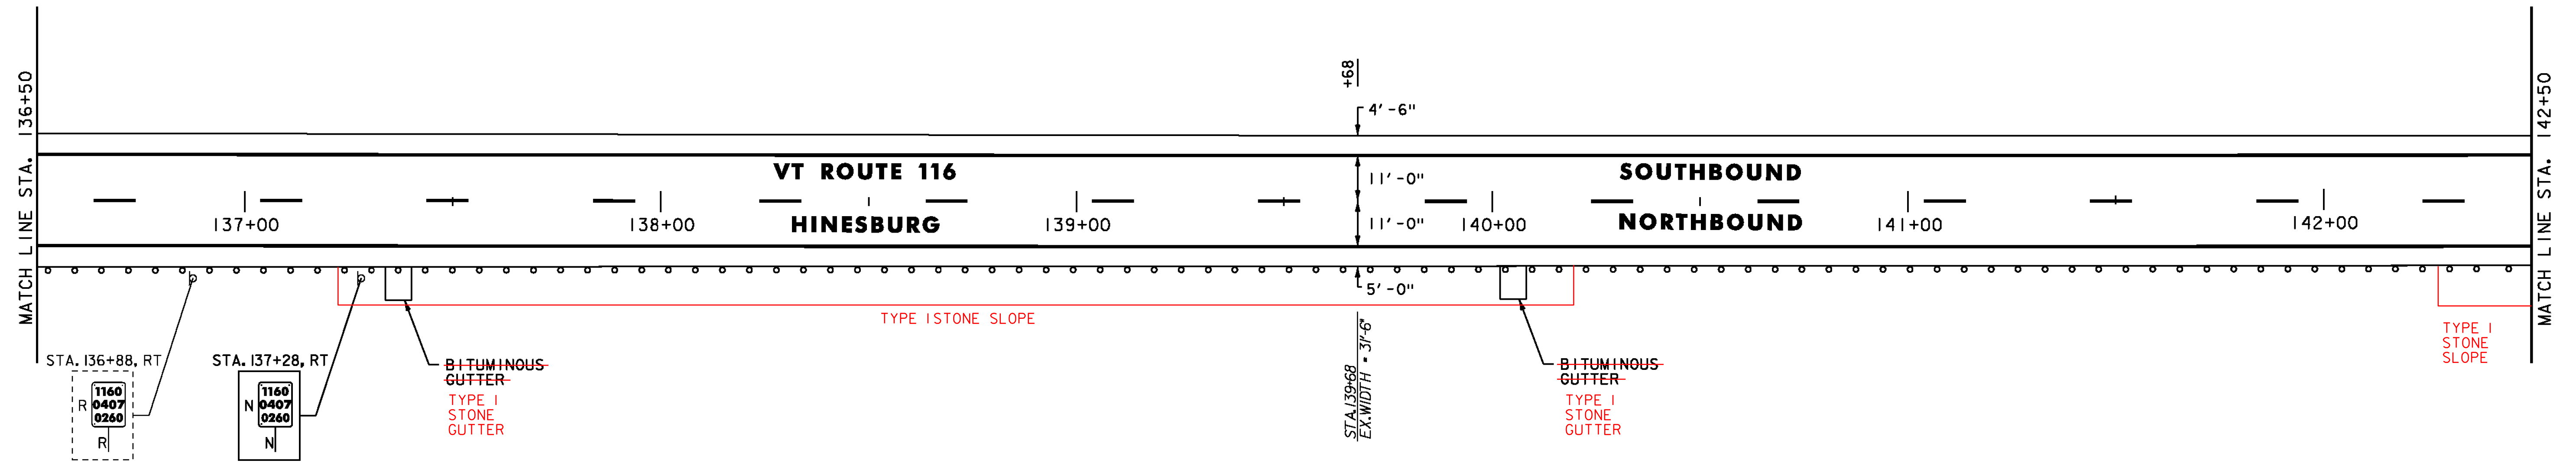

STONE FILL, TYPE I
 STA. 143+74 TO 143+80, RT
 STA. 144+37 TO 144+43, RT

STEEL BEAM GUARDRAIL, GALVANIZED W/8 FEET POSTS
 STA. 142+50 TO 144+50.5, RT
 STA. 144+33.5 TO 145+33.5, LT
 STA. 147+90 TO 148+50, LT
 STA. 147+95 TO 148+50, RT

DURABLE 4 INCH WHITE LINE
 (ALL LINES WILL INCLUDE EDGE LINE BREAKS AND RADIUS FOR SIDE ROADS)
 STA. 142+50 TO 148+50, SOLID LT & RT

TEMPORARY 4 INCH WHITE LINE, PAINT
 (ALL LINES WILL INCLUDE EDGE LINE BREAKS AND RADIUS FOR SIDE ROADS)
 STA. 142+50 TO 148+50, SOLID LT & RT

GEOTEXTILE UNDER STONE FILL
 STA. 143+74 TO 143+80, RT
 STA. 144+37 TO 144+43, RT

REMOVING SIGNS
 AS SHOWN - 2

BITUMINOUS CONCRETE CURB, TYPE A
 STA. 142+50 TO 144+02.5, RT


ANCHOR FOR STEEL BEAM RAIL
 STA. 144+50.5, RT
 STA. 144+33.5, LT
 STA. 145+33.5, LT
 STA. 147+90, LT
 STA. 147+95, RT

DURABLE 4 INCH YELLOW LINE
 (ALL LINES WILL INCLUDE C BREAKS FOR SIDE ROADS)
 STA. 142+50 TO 148+50, DASHED C

TEMPORARY 4 INCH YELLOW LINE, PAINT
 (ALL LINES WILL INCLUDE C BREAKS FOR SIDE ROADS)
 STA. 142+50 TO 148+50, DASHED C

GRUBBING MATERIAL
 STA. 143+74 TO 143+80, RT
 STA. 144+37 TO 144+43, RT

STA. 148+40, LT

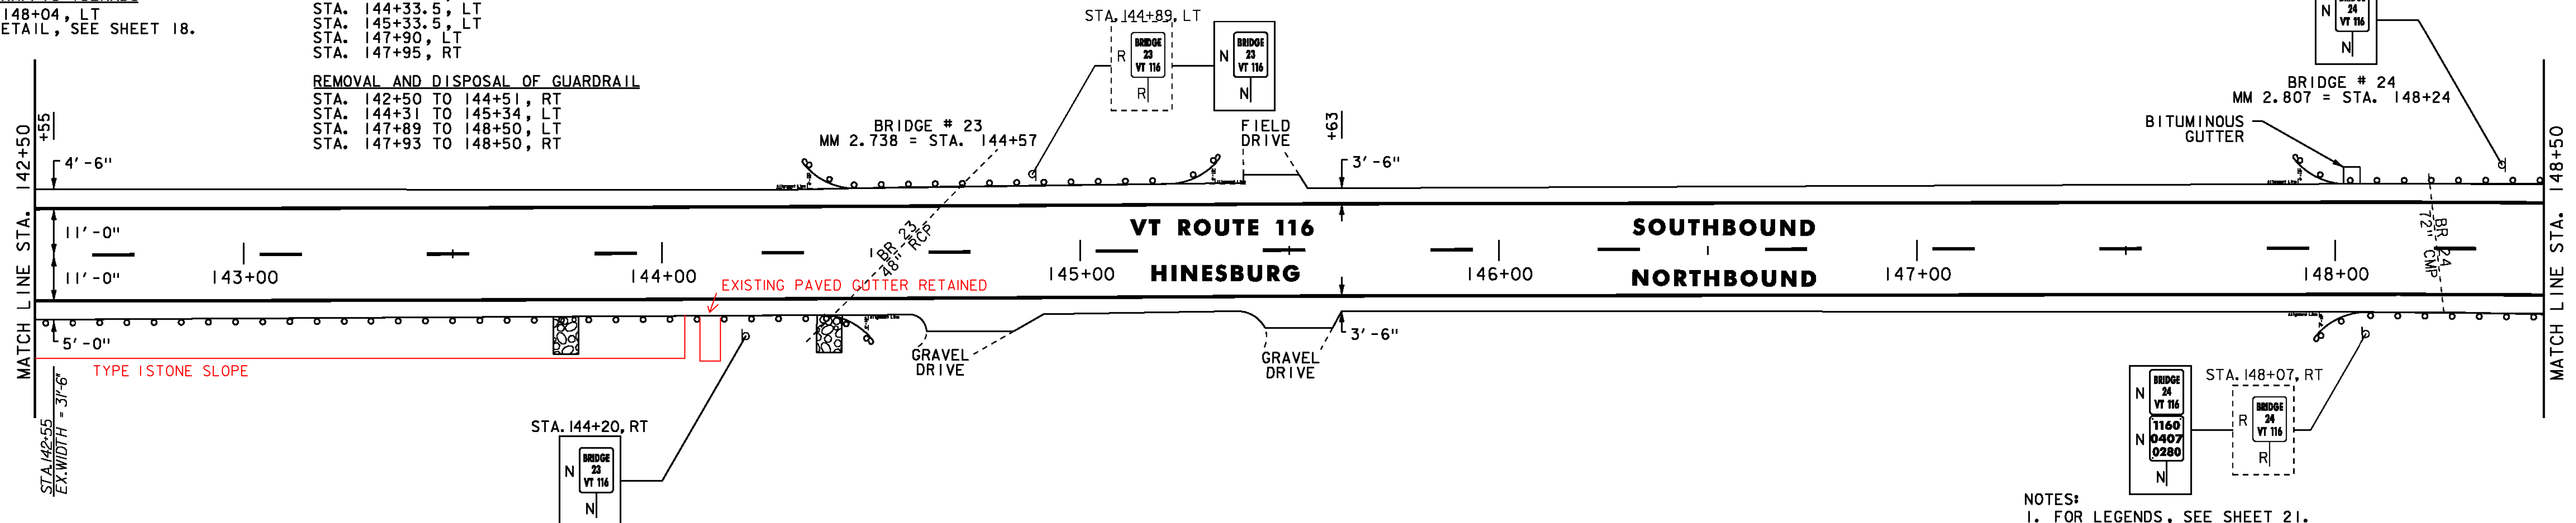

- NOTES:
 1. FOR LEGENDS, SEE SHEET 21.
 2. ALL EXISTING SIGNS NOT SHOWN SHALL BE RETAINED.
 3. SEE QUANTITY SHEETS FOR DURABLE PAVEMENT MARKING OPTIONS.

NOT TO SCALE

PROJECT LAYOUT SHEET #38



PROJECT NAME: STARKSBORO-HINESBURG
 PROJECT NUMBER: STP 2930(I)

FILE NAME: p10b266.dgn
 PROJECT LEADER: JLL
 DESIGNED BY: STANTEC
 IPARM FILE: p10b266138.i

PLOT DATE: 28-NOV-2012
 DRAWN BY: STANTEC
 CHECKED BY: MCF
 SHEET 58 OF 119