

STEEL BEAM GUARDRAIL, GALVANIZED W/8 FEET POSTS
 STA. 148+50 TO 148+65, LT
 STA. 148+50 TO 148+95, RT

ANCHOR FOR STEEL BEAM RAIL
 STA. 148+65, LT
 STA. 148+95, RT


REMOVAL AND DISPOSAL OF GUARDRAIL
 STA. 148+50 TO 148+67, LT
 STA. 148+50 TO 148+96, RT

DURABLE 4 INCH WHITE LINE
 (ALL LINES WILL INCLUDE EDGE LINE BREAKS AND
 RADI1 FOR SIDE ROADS)
 STA. 148+50 TO 154+50, SOLID LT & RT

DURABLE 4 INCH YELLOW LINE
 (ALL LINES WILL INCLUDE C BREAKS FOR SIDE ROADS)
 STA. 148+50 TO 148+95, DASHED C
 STA. 148+95 TO 154+50, DASHED LT, SOLID RT

TEMPORARY 4 INCH WHITE LINE, PAINT
 (ALL LINES WILL INCLUDE EDGE LINE BREAKS AND
 RADI1 FOR SIDE ROADS)
 STA. 148+50 TO 154+50, SOLID LT & RT

TEMPORARY 4 INCH YELLOW LINE, PAINT
 (ALL LINES WILL INCLUDE C BREAKS FOR SIDE ROADS)
 STA. 148+50 TO 148+95, DASHED C
 STA. 148+95 TO 154+50, DASHED LT, SOLID RT

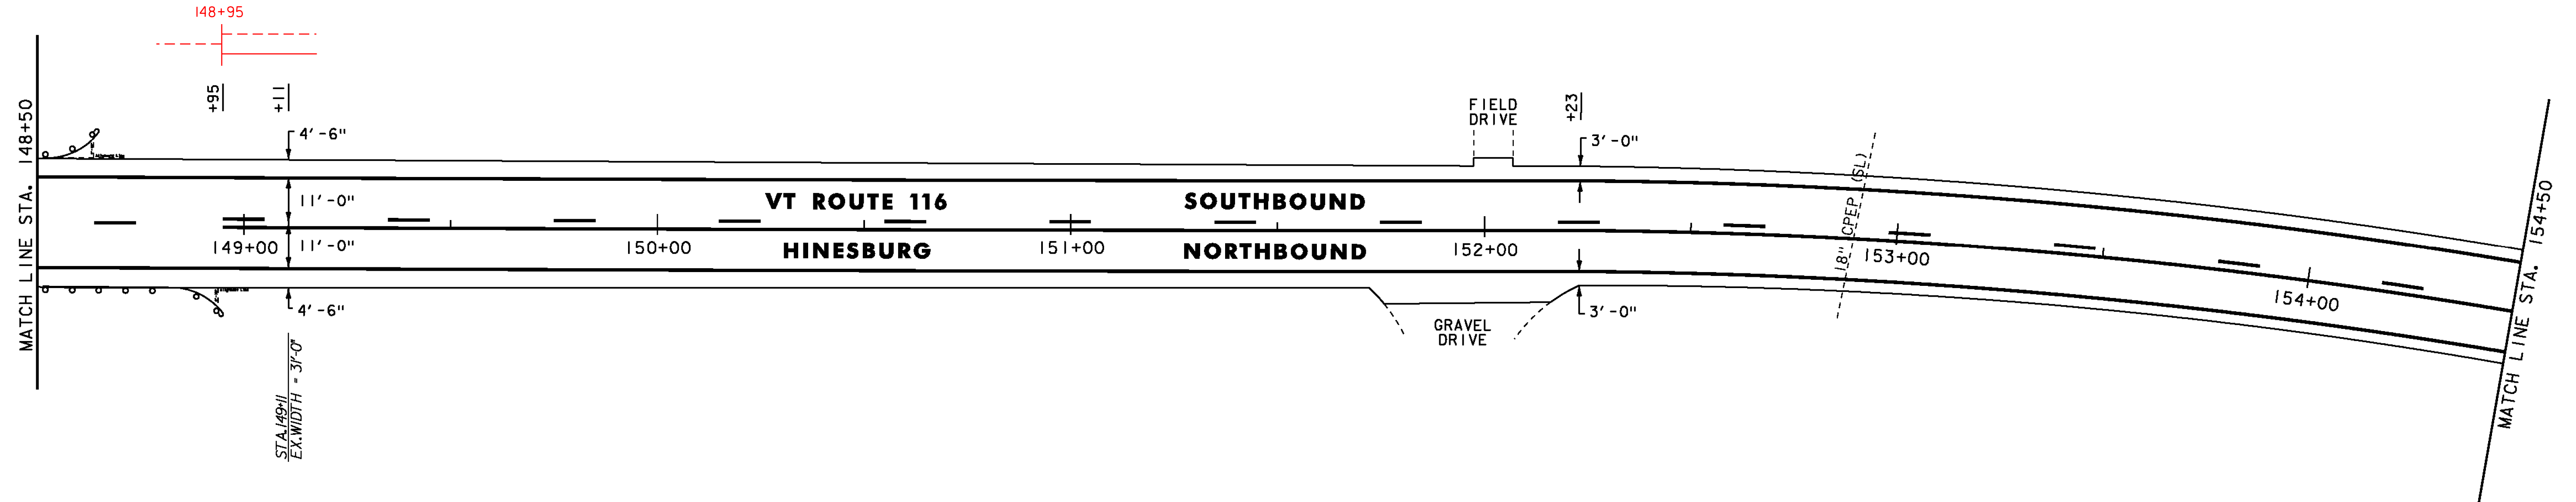


DURABLE 4 INCH WHITE LINE
 (ALL LINES WILL INCLUDE EDGE LINE BREAKS AND
 RADI1 FOR SIDE ROADS)
 STA. 154+50 TO 160+50, SOLID LT & RT

DURABLE 4 INCH YELLOW LINE
 (ALL LINES WILL INCLUDE C BREAKS FOR SIDE ROADS)
 STA. 154+50 TO 155+76, DASHED LT, SOLID RT
 STA. 155+76 TO 160+50, SOLID LT & RT

TEMPORARY 4 INCH WHITE LINE, PAINT
 (ALL LINES WILL INCLUDE EDGE LINE BREAKS AND
 RADI1 FOR SIDE ROADS)
 STA. 154+50 TO 160+50, SOLID LT & RT

TEMPORARY 4 INCH YELLOW LINE, PAINT
 (ALL LINES WILL INCLUDE C BREAKS FOR SIDE ROADS)
 STA. 154+50 TO 155+76, DASHED LT, SOLID RT
 STA. 155+76 TO 160+50, SOLID LT & RT

REMOVING SIGNS
 AS SHOWN - 1

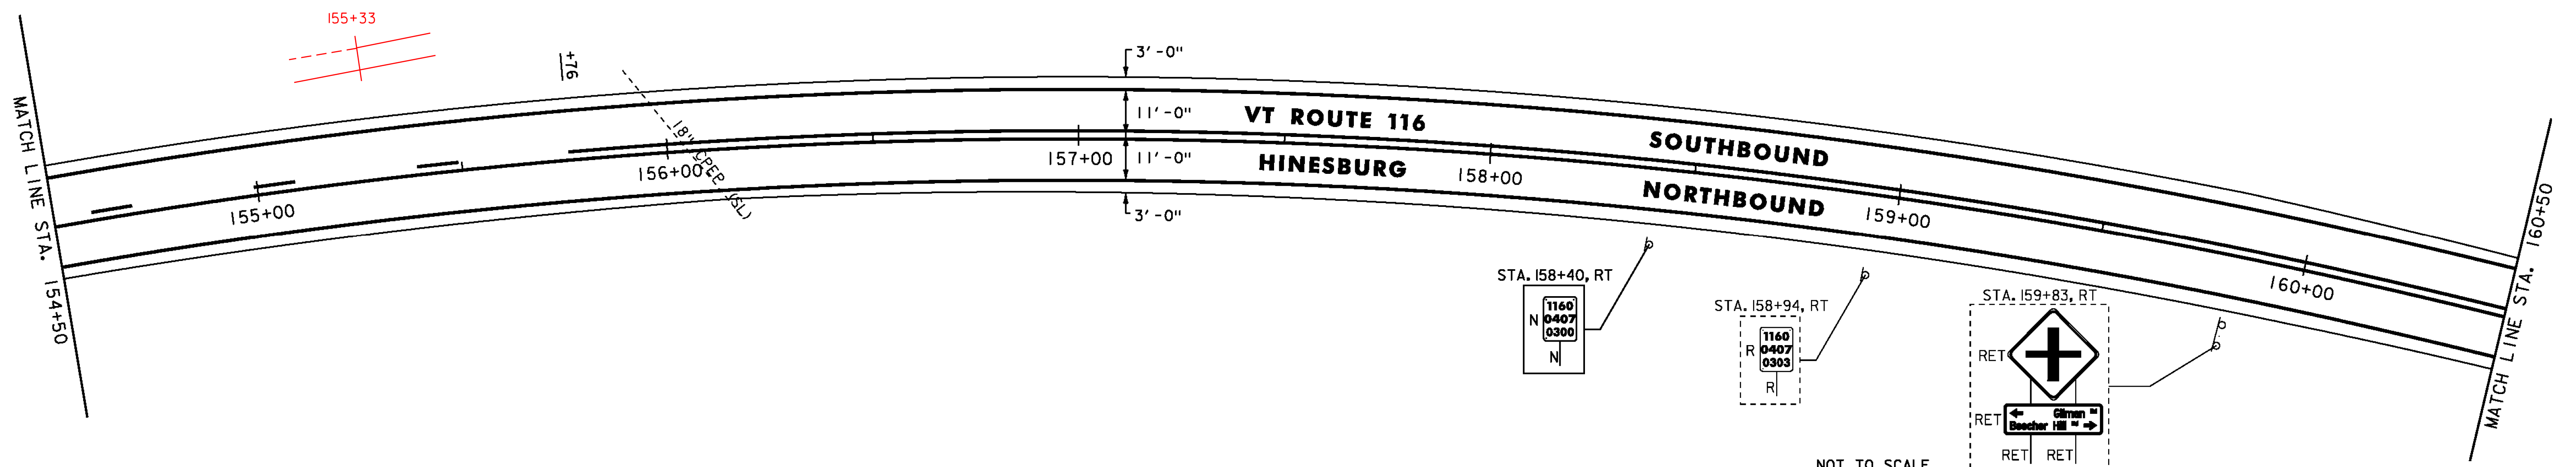

NOT TO SCALE

- NOTES:
- FOR LEGENDS, SEE SHEET 21.
 - ALL EXISTING SIGNS NOT SHOWN SHALL BE RETAINED.
 - SEE QUANTITY SHEETS FOR DURABLE PAVEMENT MARKING OPTIONS.



PROJECT LAYOUT SHEET #39

PROJECT NAME: STARKSBORO-HINESBURG
 PROJECT NUMBER: STP 2930(I)

FILE NAME: p10b266.dgn
 PROJECT LEADER: JLL
 DESIGNED BY: STANTEC
 IPARM FILE: p10b266i39.i

PLOT DATE: 28-NOV-2012
 DRAWN BY: STANTEC
 CHECKED BY: MCF
 SHEET 59 OF 119