

STEEL BEAM GUARDRAIL, GALVANIZED
 STA. 173+95 TO 174+70, LT

ANCHOR FOR STEEL BEAM RAIL
 STA. 173+95, LT
 STA. 174+70, LT

REMOVAL AND DISPOSAL OF GUARDRAIL
 STA. 173+92 TO 174+70.5, LT

24 INCH STOP BAR
 STA. 176+33, RT (LAVIGNE HILL ROAD TH-21)

LETTER OR SYMBOL
 STA. 176+33, RT "STOP" (LAVIGNE HILL ROAD TH-21)

DURABLE 4 INCH WHITE LINE
 (ALL LINES WILL INCLUDE EDGE LINE BREAKS AND
 RADIi FOR SIDE ROADS)
 STA. 171+50 TO 177+50, SOLID LT & RT
 STA. 176+33, SOLID RT (EDGELINES, LAVIGNE HILL ROAD TH-21)

DURABLE 4 INCH YELLOW LINE
 (ALL LINES WILL INCLUDE C BREAKS FOR SIDE ROADS)
 STA. 171+50 TO 177+50, SOLID LT & RT
 STA. 176+33, DOUBLE SOLID RT (LAVIGNE HILL ROAD TH-21)


TEMPORARY 4 INCH WHITE LINE, PAINT
 (ALL LINES WILL INCLUDE EDGE LINE BREAKS AND
 RADIi FOR SIDE ROADS)
 STA. 171+50 TO 177+50, SOLID LT & RT
 STA. 176+33, SOLID RT (EDGELINES, LAVIGNE HILL ROAD TH-21)

TEMPORARY 4 INCH YELLOW LINE, PAINT
 (ALL LINES WILL INCLUDE C BREAKS FOR SIDE ROADS)
 STA. 171+50 TO 177+50, SOLID LT & RT
 STA. 176+33, DOUBLE SOLID RT (LAVIGNE HILL ROAD TH-21)

TEMPORARY 24 INCH STOP BAR, PAINT
 STA. 176+33, RT (LAVIGNE HILL ROAD TH-21)

TEMPORARY LETTER OR SYMBOL, PAINT
 STA. 176+33, RT "STOP" (LAVIGNE HILL ROAD TH-21)

REMOVING SIGNS
 AS SHOWN - 7

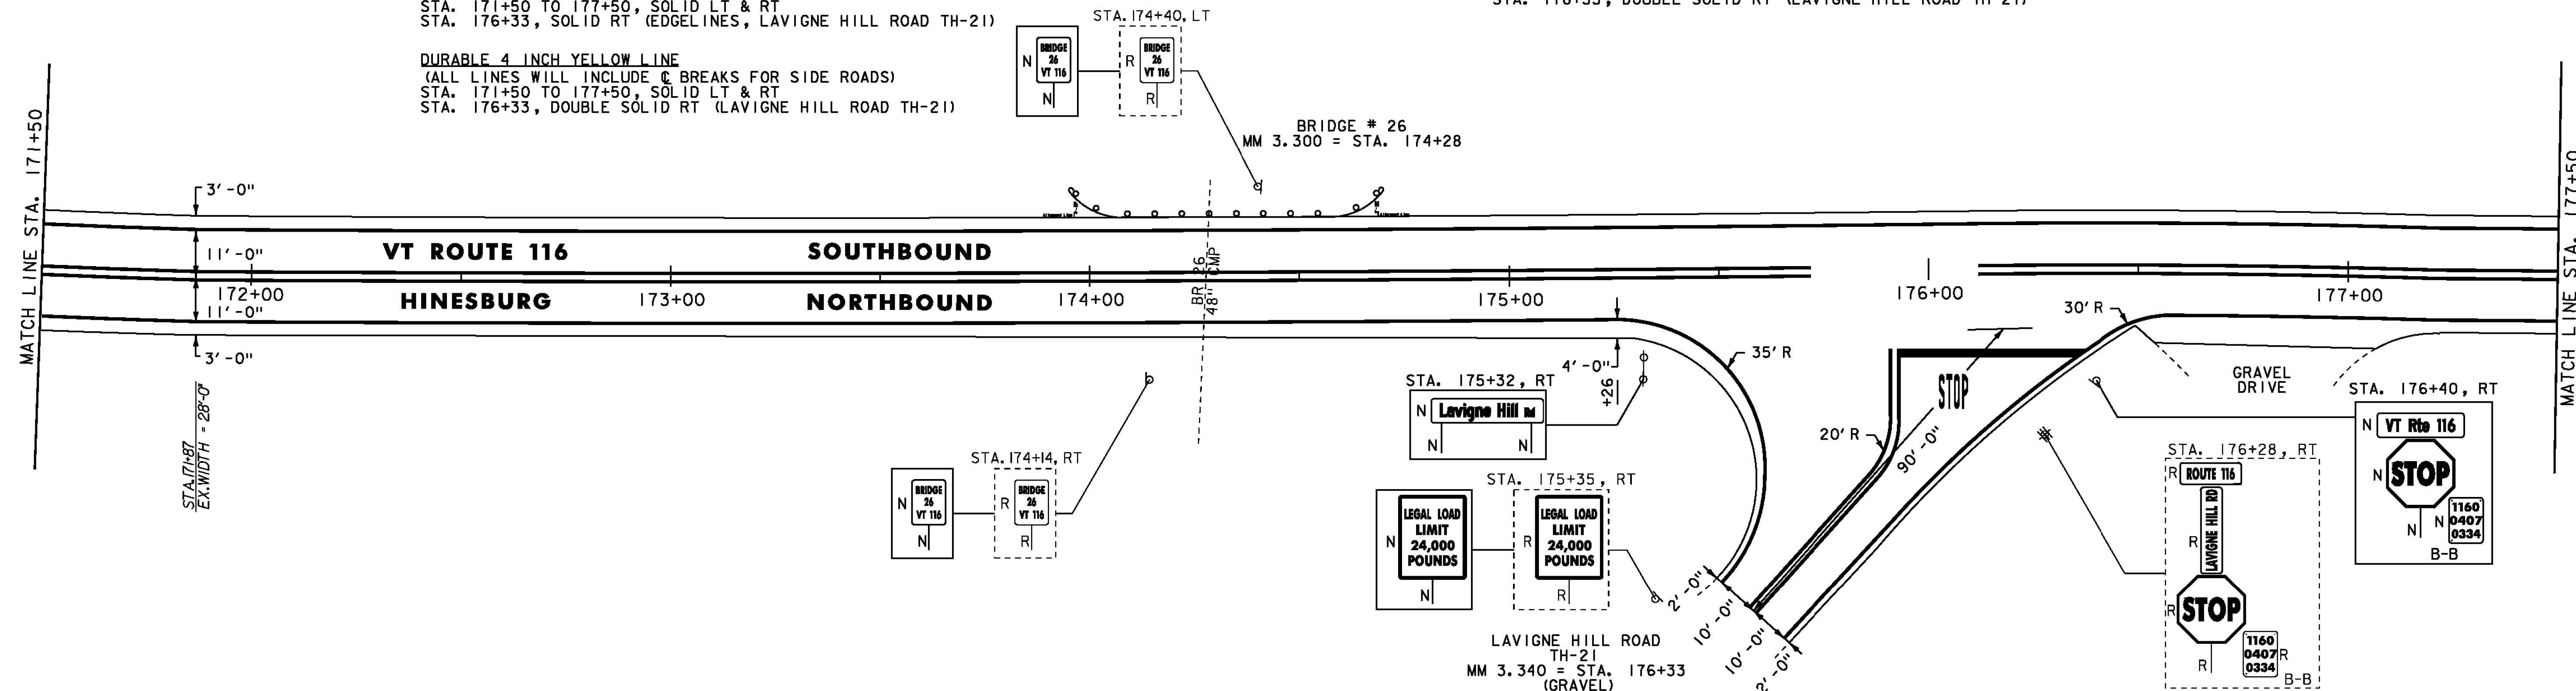


DURABLE 4 INCH WHITE LINE
 (ALL LINES WILL INCLUDE EDGE LINE BREAKS AND
 RADIi FOR SIDE ROADS)
 STA. 177+50 TO 182+50, SOLID LT & RT

TEMPORARY 4 INCH WHITE LINE, PAINT
 (ALL LINES WILL INCLUDE EDGE LINE BREAKS AND
 RADIi FOR SIDE ROADS)
 STA. 177+50 TO 182+50, SOLID LT & RT

TEMPORARY 4 INCH YELLOW LINE, PAINT
 (ALL LINES WILL INCLUDE C BREAKS FOR SIDE ROADS)
 STA. 177+50 TO 178+99, SOLID LT & RT
 STA. 178+99 TO 182+50, SOLID LT, DASHED RT

REMOVING SIGNS
 AS SHOWN - 1

DURABLE 4 INCH YELLOW LINE
 (ALL LINES WILL INCLUDE C BREAKS FOR SIDE ROADS)
 STA. 177+50 TO 178+99, SOLID LT & RT
 STA. 178+99 TO 182+50, SOLID LT, DASHED RT

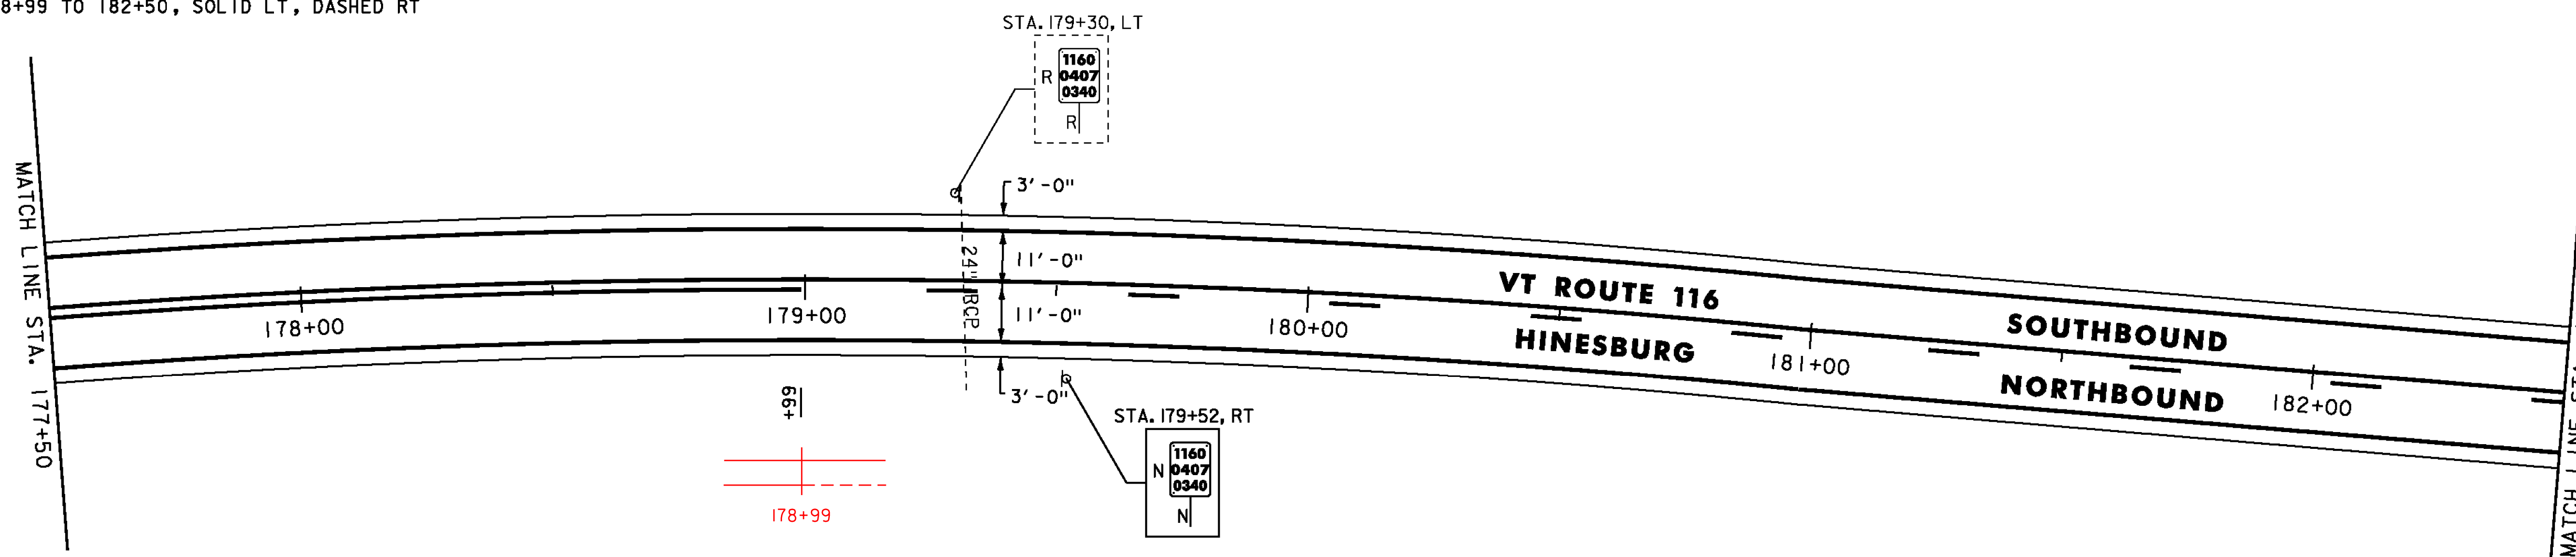

- NOTES:
- FOR LEGENDS, SEE SHEET 21.
 - ALL EXISTING SIGNS NOT SHOWN SHALL BE RETAINED.
 - SEE QUANTITY SHEETS FOR DURABLE PAVEMENT MARKING OPTIONS.

NOT TO SCALE

PROJECT LAYOUT SHEET #41

PROJECT NAME: STARKSBORO-HINESBURG
 PROJECT NUMBER: STP 2930(I)

FILE NAME: p10b266.dgn
 PROJECT LEADER: JLL
 DESIGNED BY: STANTEC
 IPARM FILE: p10b266i41.i

PLOT DATE: 28-NOV-2012
 DRAWN BY: STANTEC
 CHECKED BY: MCF
 SHEET 61 OF 119

