


DURABLE 4 INCH WHITE LINE
 (ALL LINES WILL INCLUDE EDGE LINE BREAKS AND
 RADII FOR SIDE ROADS)
 STA. 182+50 TO 188+50, SOLID LT & RT

TEMPORARY 4 INCH WHITE LINE, PAINT
 (ALL LINES WILL INCLUDE EDGE LINE BREAKS AND
 RADII FOR SIDE ROADS)
 STA. 182+50 TO 188+50, SOLID LT & RT

DURABLE 4 INCH YELLOW LINE
 (ALL LINES WILL INCLUDE C BREAKS FOR SIDE ROADS)
 STA. 182+50 TO 187+07, SOLID LT, DASHED RT
 STA. 187+07 TO 188+50, DASHED C

TEMPORARY 4 INCH YELLOW LINE, PAINT
 (ALL LINES WILL INCLUDE C BREAKS FOR SIDE ROADS)
 STA. 182+50 TO 187+07, SOLID LT, DASHED RT
 STA. 187+07 TO 188+50, DASHED C

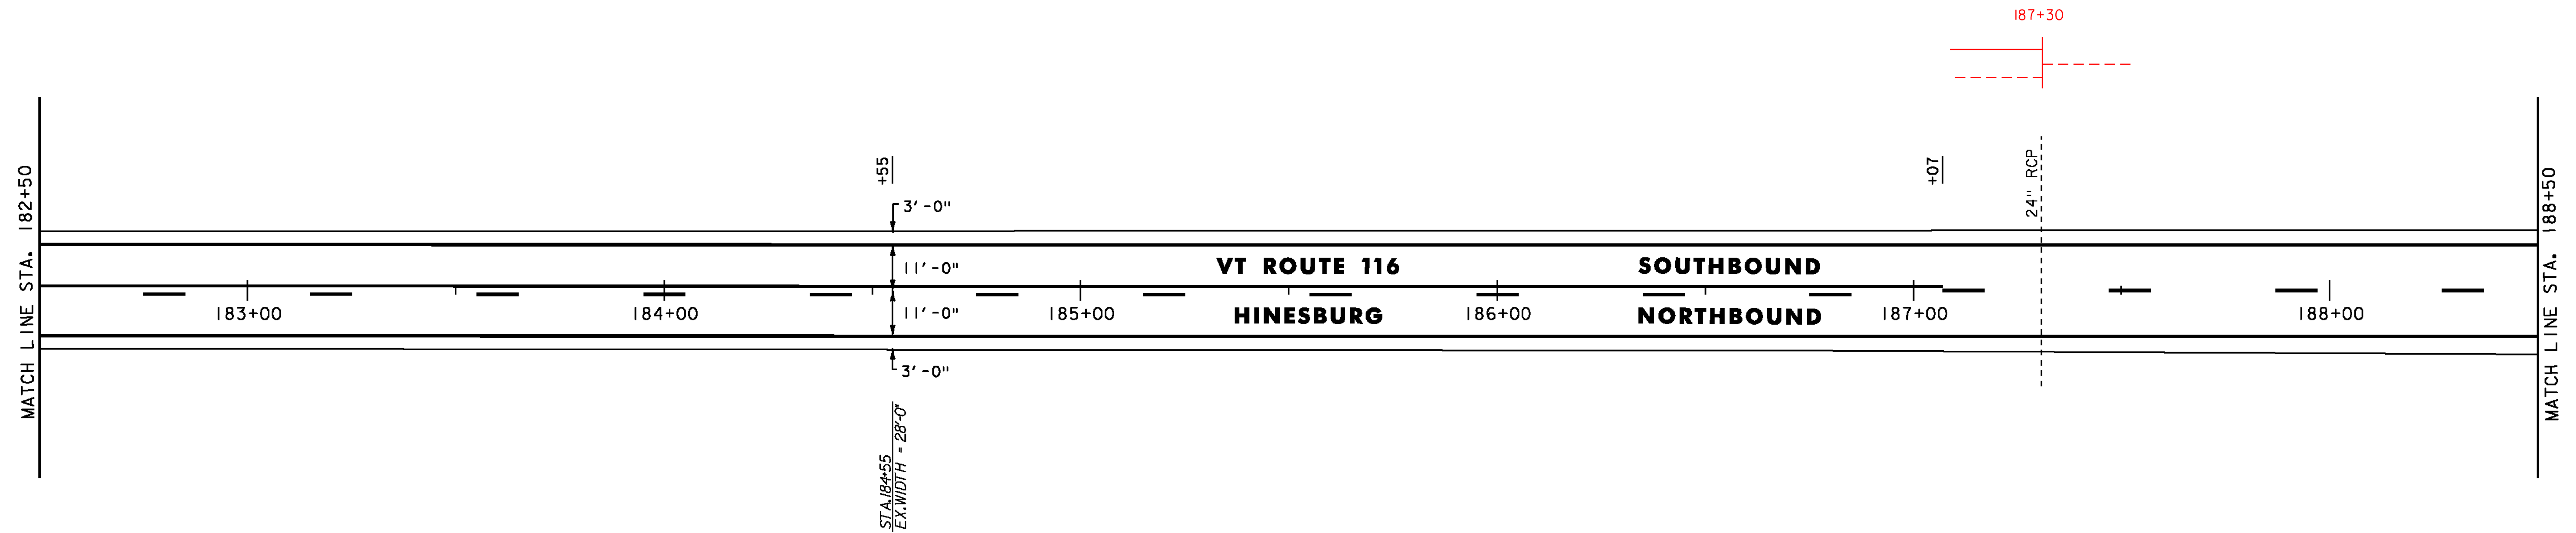


DURABLE 4 INCH WHITE LINE
 (ALL LINES WILL INCLUDE EDGE LINE BREAKS AND
 RADII FOR SIDE ROADS)
 STA. 188+50 TO 194+50, SOLID LT & RT

TEMPORARY 4 INCH WHITE LINE, PAINT
 (ALL LINES WILL INCLUDE EDGE LINE BREAKS AND
 RADII FOR SIDE ROADS)
 STA. 188+50 TO 194+50, SOLID LT & RT

REMOVING SIGNS
 AS SHOWN - 2

DURABLE 4 INCH YELLOW LINE
 (ALL LINES WILL INCLUDE C BREAKS FOR SIDE ROADS)
 STA. 188+50 TO 192+98, DASHED C
 STA. 192+98 TO 194+50, DASHED LT, SOLID RT

TEMPORARY 4 INCH YELLOW LINE, PAINT
 (ALL LINES WILL INCLUDE C BREAKS FOR SIDE ROADS)
 STA. 188+50 TO 192+98, DASHED C
 STA. 192+98 TO 194+50, DASHED LT, SOLID RT

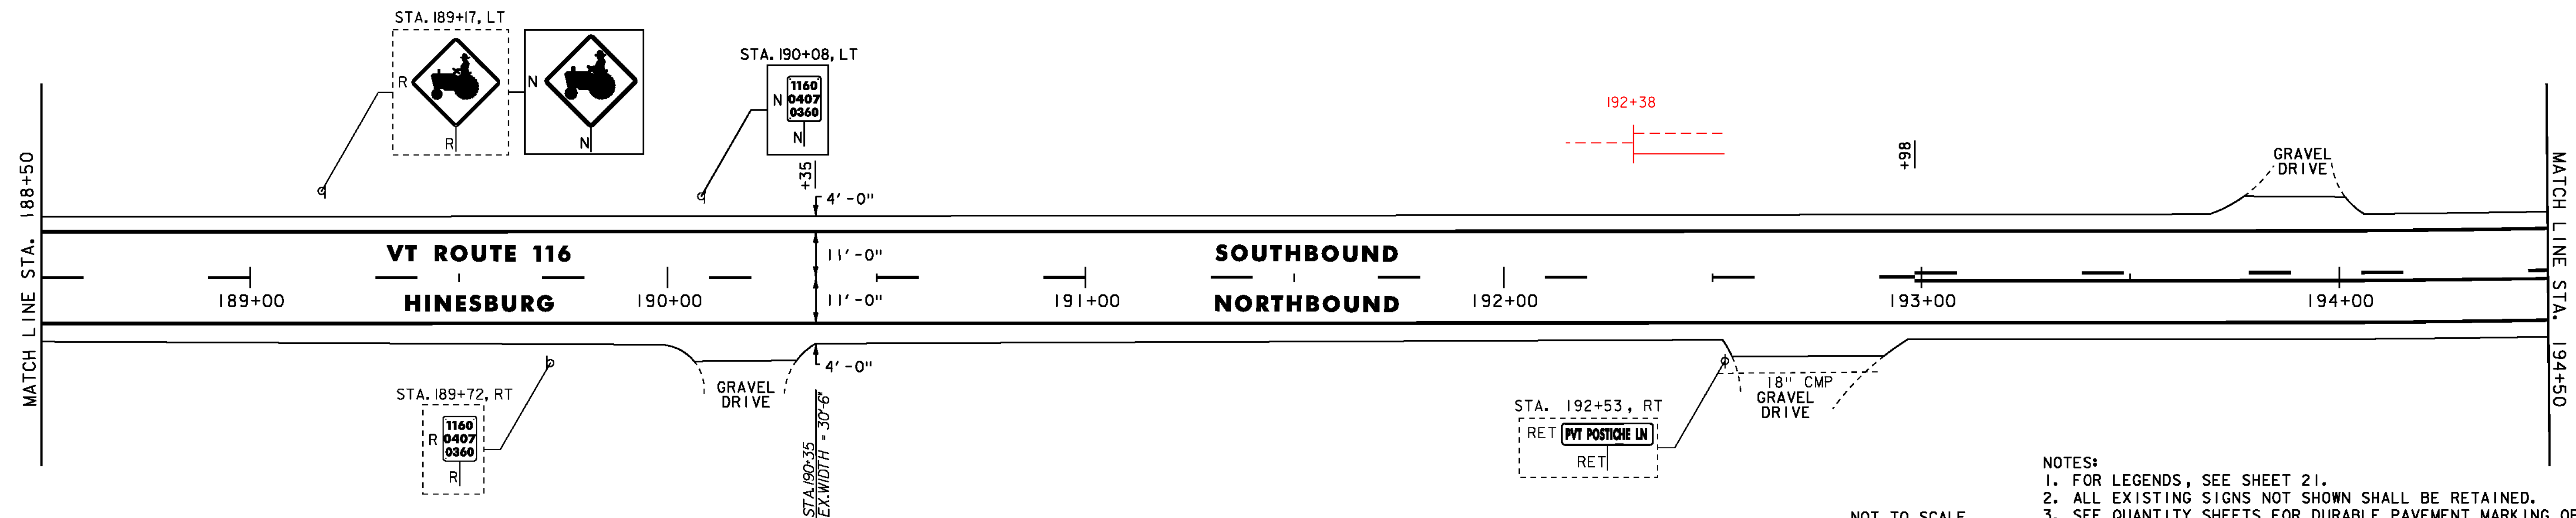

- NOTES:
 1. FOR LEGENDS, SEE SHEET 21.
 2. ALL EXISTING SIGNS NOT SHOWN SHALL BE RETAINED.
 3. SEE QUANTITY SHEETS FOR DURABLE PAVEMENT MARKING OPTIONS.

NOT TO SCALE

PROJECT LAYOUT SHEET #42	PROJECT NAME: STARKSBORO-HINESBURG
	PROJECT NUMBER: STP 2930(I)
FILE NAME: p10b266.dgn	PLOT DATE: 28-NOV-2012
PROJECT LEADER: JLL	DRAWN BY: STANTEC
DESIGNED BY: STANTEC	CHECKED BY: MCF
IPARM FILE: p10b266i42.i	SHEET 62 OF 119

