


DURABLE 4 INCH WHITE LINE
 (ALL LINES WILL INCLUDE EDGE LINE BREAKS AND
 RADII FOR SIDE ROADS)
 STA. 194+50 TO 200+50, SOLID LT & RT

TEMPORARY 4 INCH WHITE LINE, PAINT
 (ALL LINES WILL INCLUDE EDGE LINE BREAKS AND
 RADII FOR SIDE ROADS)
 STA. 194+50 TO 200+50, SOLID LT & RT

REMOVING SIGNS
 AS SHOWN - 2

DURABLE 4 INCH YELLOW LINE
 (ALL LINES WILL INCLUDE C BREAKS FOR SIDE ROADS)
 STA. 194+50 TO 199+58, DASHED LT, SOLID RT
 STA. 199+58 TO 200+50, SOLID LT & RT

TEMPORARY 4 INCH YELLOW LINE, PAINT
 (ALL LINES WILL INCLUDE C BREAKS FOR SIDE ROADS)
 STA. 194+50 TO 199+58, DASHED LT, SOLID RT
 STA. 199+58 TO 200+50, SOLID LT & RT

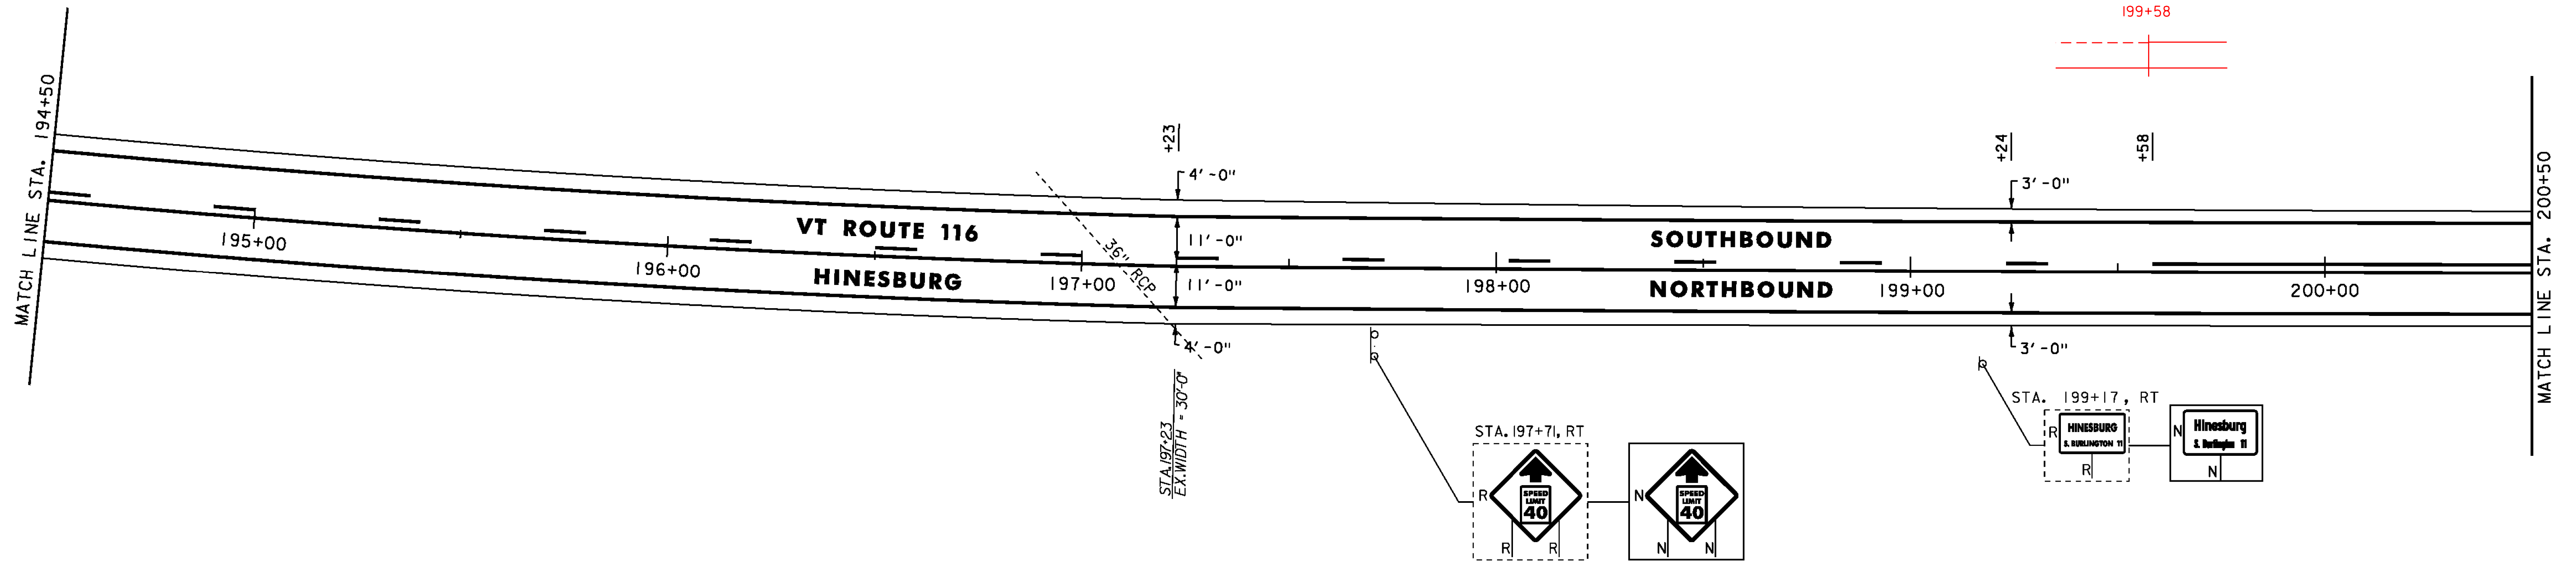

24 INCH STOP BAR
 STA. 205+56, RT (BUCK HILL ROAD WEST TH-20)
LETTER OR SYMBOL
 STA. 205+56, RT "STOP" (BUCK HILL ROAD WEST TH-20)

TEMPORARY 4 INCH WHITE LINE, PAINT
 (ALL LINES WILL INCLUDE EDGE LINE BREAKS AND
 RADII FOR SIDE ROADS)
 STA. 200+50 TO 206+50, SOLID LT & RT
 STA. 205+56, SOLID RT (EDGELINES, BUCK HILL
 ROAD WEST TH-20)


TEMPORARY 4 INCH YELLOW LINE, PAINT
 (ALL LINES WILL INCLUDE C BREAKS FOR SIDE ROADS)
 STA. 200+50 TO 206+50, SOLID LT & RT
 STA. 205+56, DOUBLE SOLID RT (BUCK HILL ROAD WEST TH-20)

TEMPORARY 24 INCH STOP BAR, PAINT
 STA. 205+56, RT (BUCK HILL ROAD WEST TH-20)

TEMPORARY LETTER OR SYMBOL, PAINT
 STA. 205+56, RT "STOP" (BUCK HILL ROAD WEST TH-20)

REMOVING SIGNS
 AS SHOWN - 7

STA. 205+80, RT

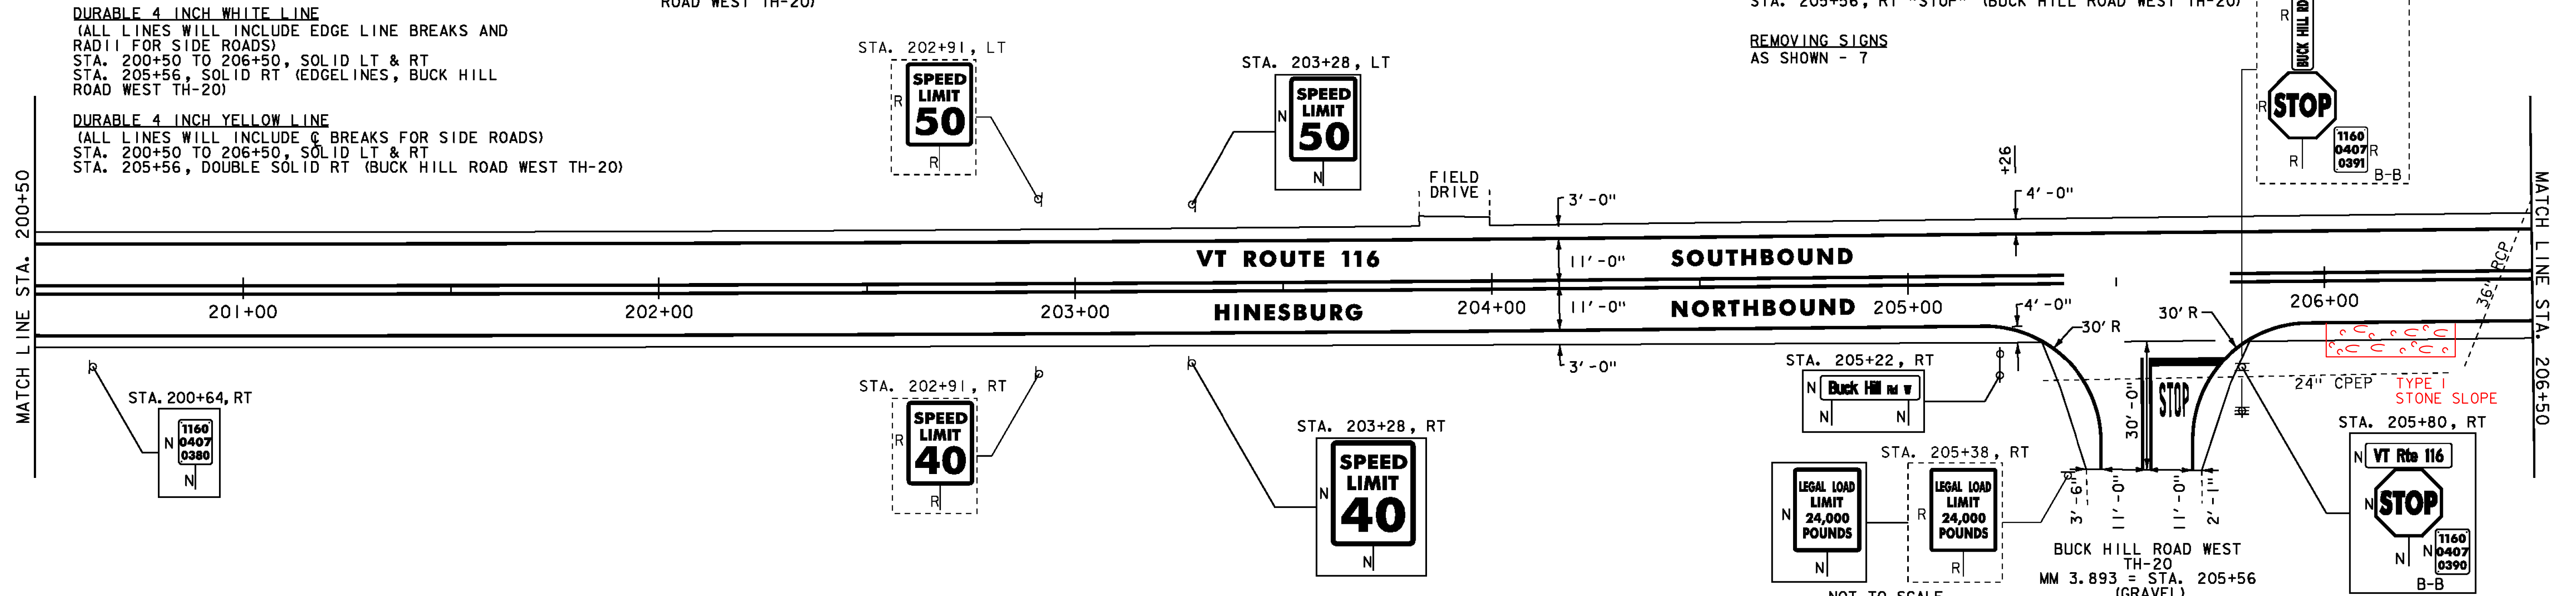

NOT TO SCALE

PROJECT LAYOUT SHEET #43	PROJECT NAME: STARKSBORO-HINESBURG	PLOT DATE: 28-NOV-2012
	PROJECT NUMBER: STP 2930(I)	DRAWN BY: STANTEC
	FILE NAME: p10b266.dgn	CHECKED BY: MCF
	DESIGNED BY: STANTEC	SHEET 63 OF 119
IPARM FILE: p10b266143.i		

- NOTES:
- FOR LEGENDS, SEE SHEET 21.
 - ALL EXISTING SIGNS NOT SHOWN SHALL BE RETAINED.
 - SEE QUANTITY SHEETS FOR DURABLE PAVEMENT MARKING OPTIONS.

