

REHAB. DIS. CBs OR MHs, CLASS I OR II

STA. 231+14, RT
STA. 231+98, LT
STA. 233+14, LT

24 INCH STOP BAR

STA. 231+47, LT (SILVER STREET TH-4)

LETTER OR SYMBOL

STA. 231+32, LT ARROW (SILVER STREET TH-4)
STA. 231+41, LT ARROW (SILVER STREET TH-4)

DURABLE 4 INCH WHITE LINE

(ALL LINES WILL INCLUDE EDGE LINE BREAKS AND RADI FOR SIDE ROADS)
STA. 229+50 TO 233+50, SOLID LT & RT
STA. 231+47, SOLID LT (EDGE LINES, SILVER STREET TH-4)
STA. 231+47, SOLID LT (LANE LINE, SILVER STREET TH-4)
STA. 231+77 TO 233+50, SOLID LT (LANE LINE)

DURABLE 4 INCH YELLOW LINE

(ALL LINES WILL INCLUDE C BREAKS FOR SIDE ROADS)
STA. 229+50 TO 233+50, SOLID LT & RT
STA. 231+47, DOUBLE SOLID LT (SILVER STREET TH-4)

DURABLE LETTER OR SYMBOL

STA. 231+83, LT ARROW
STA. 232+25, LT "ONLY"
STA. 232+62, LT ARROW
STA. 233+05, LT "ONLY"
STA. 233+46, LT ARROW

TEMPORARY 4 INCH WHITE LINE, PAINT

(ALL LINES WILL INCLUDE EDGE LINE BREAKS AND RADI FOR SIDE ROADS)
STA. 229+50 TO 233+50, SOLID LT & RT
STA. 231+47, SOLID LT (EDGE LINES, SILVER STREET TH-4)
STA. 231+47, SOLID LT (LANE LINE, SILVER STREET TH-4)
STA. 231+77 TO 233+50, SOLID LT (LANE LINE)

TEMPORARY 4 INCH YELLOW LINE, PAINT

(ALL LINES WILL INCLUDE C BREAKS FOR SIDE ROADS)
STA. 229+50 TO 233+50, SOLID LT & RT
STA. 231+47, DOUBLE SOLID LT (SILVER STREET TH-4)

TEMPORARY 24 INCH STOP BAR, PAINT

STA. 231+47, LT (SILVER STREET TH-4)

TEMPORARY LETTER OR SYMBOL, PAINT


STA. 231+32, LT ARROW (SILVER STREET TH-4)
STA. 231+41, LT ARROW (SILVER STREET TH-4)
STA. 231+83, LT ARROW
STA. 232+25, LT "ONLY"
STA. 232+62, LT ARROW
STA. 233+05, LT "ONLY"
STA. 233+46, LT ARROW

SPECIAL PROVISION (RELOCATE FLASHING BEACON, GROUND MOUNTED)

STA. 230+46, LT

REMOVING SIGNS

AS SHOWN - 9

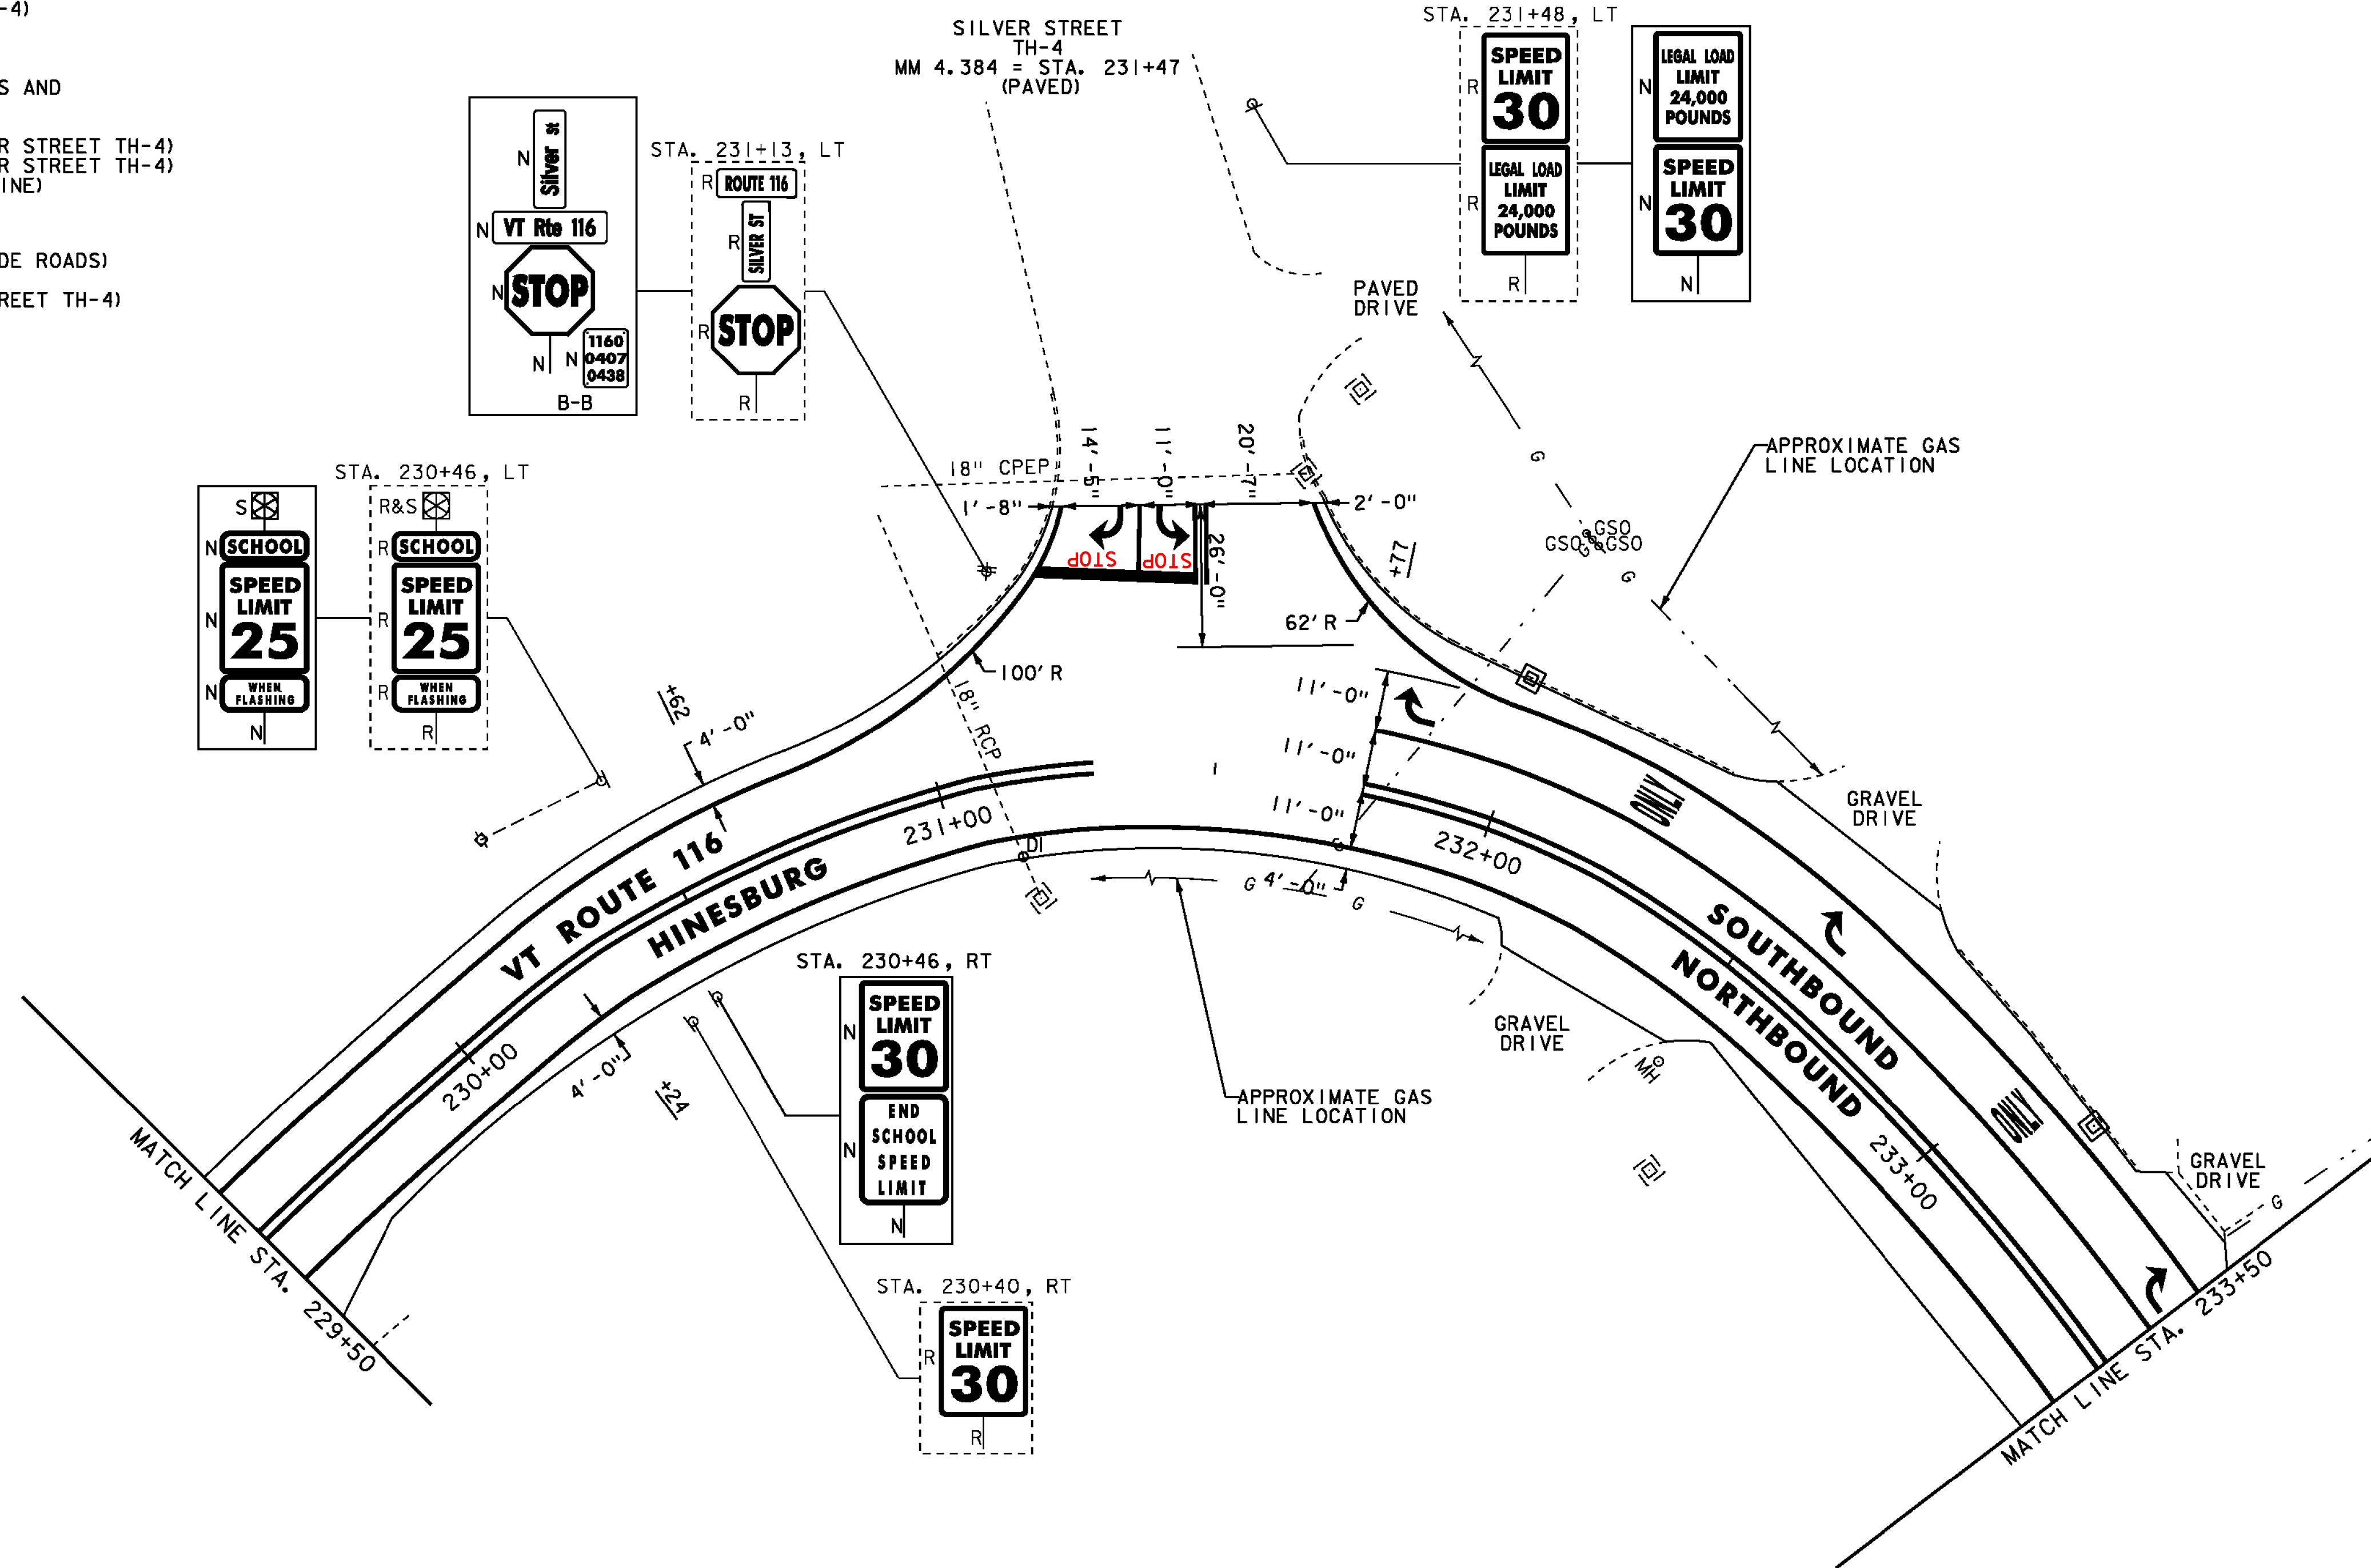

- NOTES:
 1. FOR LEGENDS, SEE SHEET 21.
 2. ALL EXISTING SIGNS NOT SHOWN SHALL BE RETAINED.
 3. SEE QUANTITY SHEETS FOR DURABLE PAVEMENT MARKING OPTIONS.

NOT TO SCALE

PROJECT LAYOUT SHEET #46	PROJECT NAME: STARKSBORO-HINESBURG
	PROJECT NUMBER: STP 2930(I)
FILE NAME: p10b266.dgn	PLOT DATE: 28-NOV-2012
PROJECT LEADER: JLL	DRAWN BY: STANTEC
DESIGNED BY: STANTEC	CHECKED BY: MCF
IPARM FILE: p10b266i46.i	SHEET 66 OF 119

