

REHAB. DIS. CBS OR MHS. CLASS I OR II
 STA. 233+86, LT
 STA. 237+41, LT

ADJUST ELEVATION OF VALVE BOX
 (NO FEDERAL/STATE PARTICIPATION)
 STA. 234+56, LT

DURABLE 4 INCH WHITE LINE
 (ALL LINES WILL INCLUDE EDGE LINE BREAKS AND
 RADII FOR SIDE ROADS)
 STA. 233+50 TO 237+50, SOLID LT & RT
 STA. 233+50 TO 233+56, SOLID LT (LANE LINE)
 STA. 233+56 TO 234+56, DOTTED LT

DURABLE 4 INCH YELLOW LINE
 (ALL LINES WILL INCLUDE C BREAKS FOR SIDE ROADS)
 STA. 233+50 TO 237+50, SOLID LT & RT

DURABLE 8 INCH WHITE LINE
 STA. 234+50 TO 234+62, LT (HYDRANT)
 SEE SHEET 19

DURABLE LETTER OR SYMBOL
 STA. 234+45, LT "SCHOOL"


TEMPORARY 4 INCH WHITE LINE, PAINT
 (ALL LINES WILL INCLUDE EDGE LINE BREAKS AND
 RADII FOR SIDE ROADS)
 STA. 233+50 TO 237+50, SOLID LT & RT
 STA. 233+50 TO 233+56, SOLID LT (LANE LINE)
 STA. 233+56 TO 234+56, DOTTED LT

TEMPORARY 4 INCH YELLOW LINE, PAINT
 (ALL LINES WILL INCLUDE C BREAKS FOR SIDE ROADS)
 STA. 233+50 TO 237+50, SOLID LT & RT

TEMPORARY 8 INCH WHITE LINE, PAINT
 STA. 234+50 TO 234+62, LT (HYDRANT)
 SEE SHEET 19

TEMPORARY LETTER OR SYMBOL, PAINT
 STA. 234+45, LT "SCHOOL"

REMOVING SIGNS
 AS SHOWN - 8

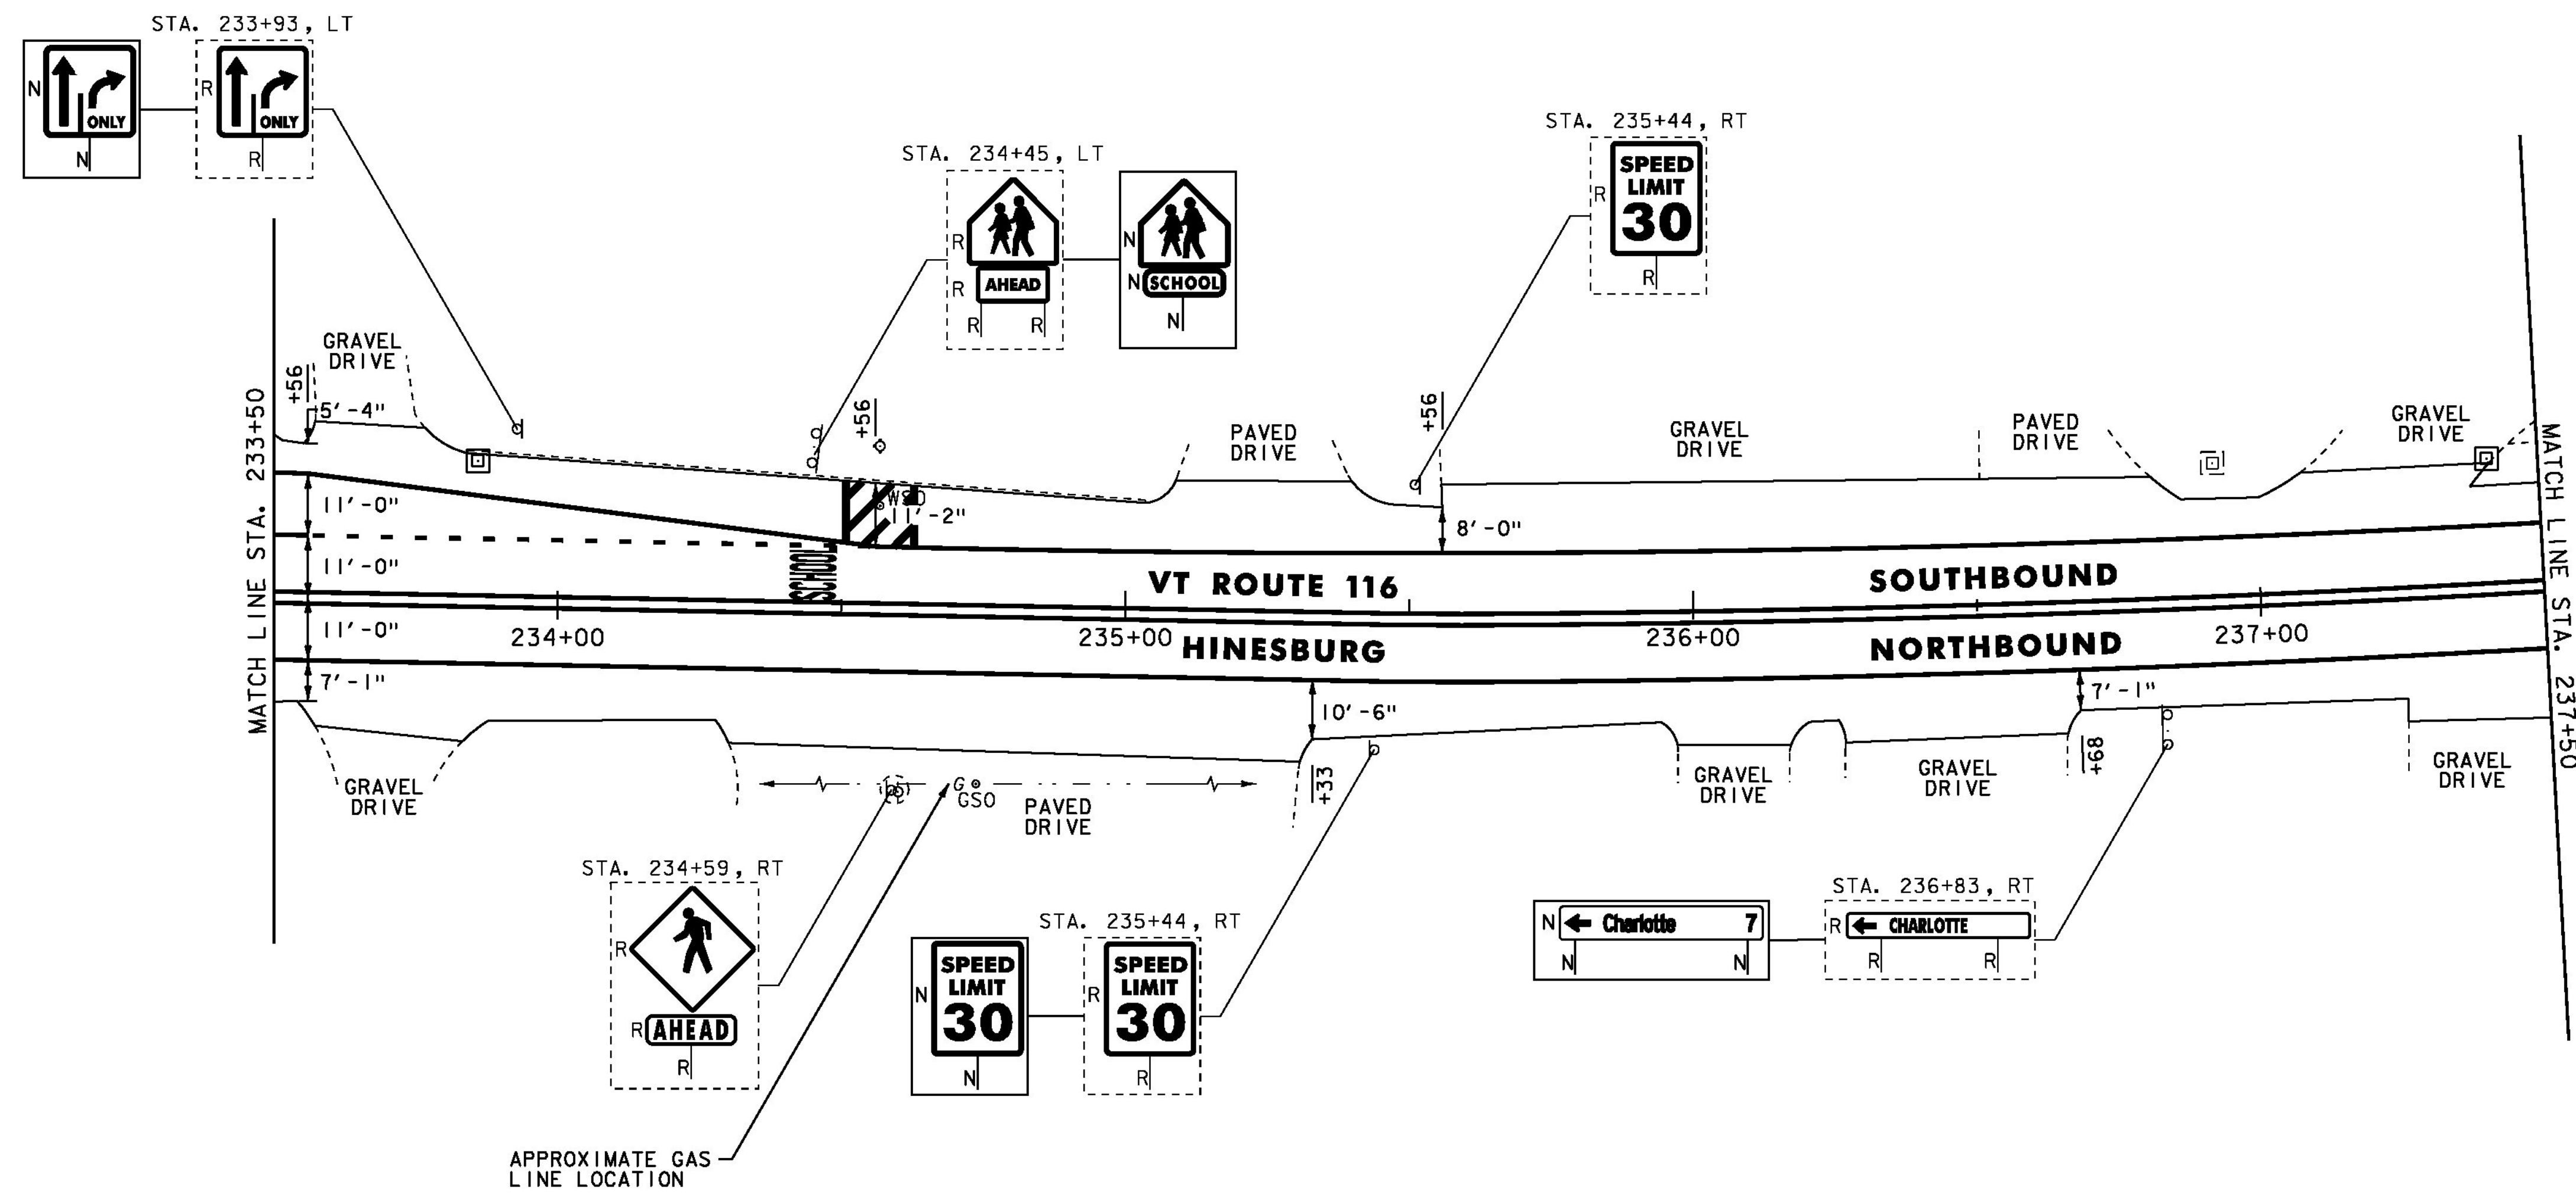

- NOTES:
- FOR LEGENDS, SEE SHEET 21.
 - ALL EXISTING SIGNS NOT SHOWN SHALL BE RETAINED.
 - SEE QUANTITY SHEETS FOR DURABLE PAVEMENT MARKING OPTIONS.

NOT TO SCALE



PROJECT LAYOUT SHEET #47

PROJECT NAME: STARKSBORO-HINESBURG	PLOT DATE: 28-NOV-2012
PROJECT NUMBER: STP 2930(I)	DRAWN BY: STANTEC
FILE NAME: p10b266.dgn	CHECKED BY: MCF
DESIGNED BY: STANTEC	SHEET 67 OF 119
IPARM FILE: p10b266i47.i	