

**STEEL BEAM GUARDRAIL, GALVANIZED  
W/8 FEET POSTS**  
 STA. 264+84 TO 265+46.5, RT  
 STA. 265+21.5 TO 265+46.5, LT  
 STA. 265+71.5 TO 266+09, RT  
 STA. 265+71.5 TO 266+21.5, LT

**HD STEEL BEAM GUARDRAIL, GALVANIZED/NESTED**  
 STA. 265+46.5 TO 265+71.5, LT  
 STA. 265+46.5 TO 265+71.5, RT

**ANCHOR FOR STEEL BEAM RAIL**  
 STA. 264+84, RT  
 STA. 265+21.5, LT  
 STA. 266+09, RT  
 STA. 266+21.5, LT

**REMOVAL AND DISPOSAL OF GUARDRAIL**  
 STA. 264+82.5 TO 266+05, RT  
 STA. 265+14 TO 266+17, LT

**DURABLE 4 INCH WHITE LINE**  
 (ALL LINES WILL INCLUDE EDGE LINE BREAKS AND  
 RADIUS FOR SIDE ROADS)  
 STA. 263+50 TO 269+50, SOLID LT & RT  
 STA. 263+50 TO 264+08, SOLID LT (PARKING)  
 STA. 263+50 TO 263+70, DOTTED LT  
 STA. 264+08 TO 264+39, SOLID LT (DIAGONALS)

**DURABLE 4 INCH YELLOW LINE**  
 (ALL LINES WILL INCLUDE C BREAKS FOR SIDE ROADS)  
 STA. 263+50 TO 265+08, DOUBLE SOLID LT  
 STA. 263+50 TO 265+08, DOUBLE SOLID RT  
 STA. 265+08 TO 269+50, SOLID LT & RT


**DURABLE 8 INCH YELLOW LINE**  
 STA. 263+50 TO 264+81, LT & RT (DIAGONALS)  
 SEE SHEET 19

**TEMPORARY 4 INCH WHITE LINE, PAINT**  
 (ALL LINES WILL INCLUDE EDGE LINE BREAKS AND  
 RADIUS FOR SIDE ROADS)  
 STA. 263+50 TO 269+50, SOLID LT & RT  
 STA. 263+50 TO 264+08, SOLID LT (PARKING)  
 STA. 263+50 TO 263+70, DOTTED LT  
 STA. 264+08 TO 264+39, SOLID LT (DIAGONALS)

**TEMPORARY 4 INCH YELLOW LINE, PAINT**  
 (ALL LINES WILL INCLUDE C BREAKS FOR SIDE ROADS)  
 STA. 263+50 TO 265+08, DOUBLE SOLID LT  
 STA. 263+50 TO 265+08, DOUBLE SOLID RT  
 STA. 265+08 TO 269+50, SOLID LT & RT

**TEMPORARY 8 INCH YELLOW LINE, PAINT**  
 STA. 263+50 TO 264+81, LT & RT (DIAGONALS)  
 SEE SHEET 19

**REMOVING SIGNS  
AS SHOWN - 4**

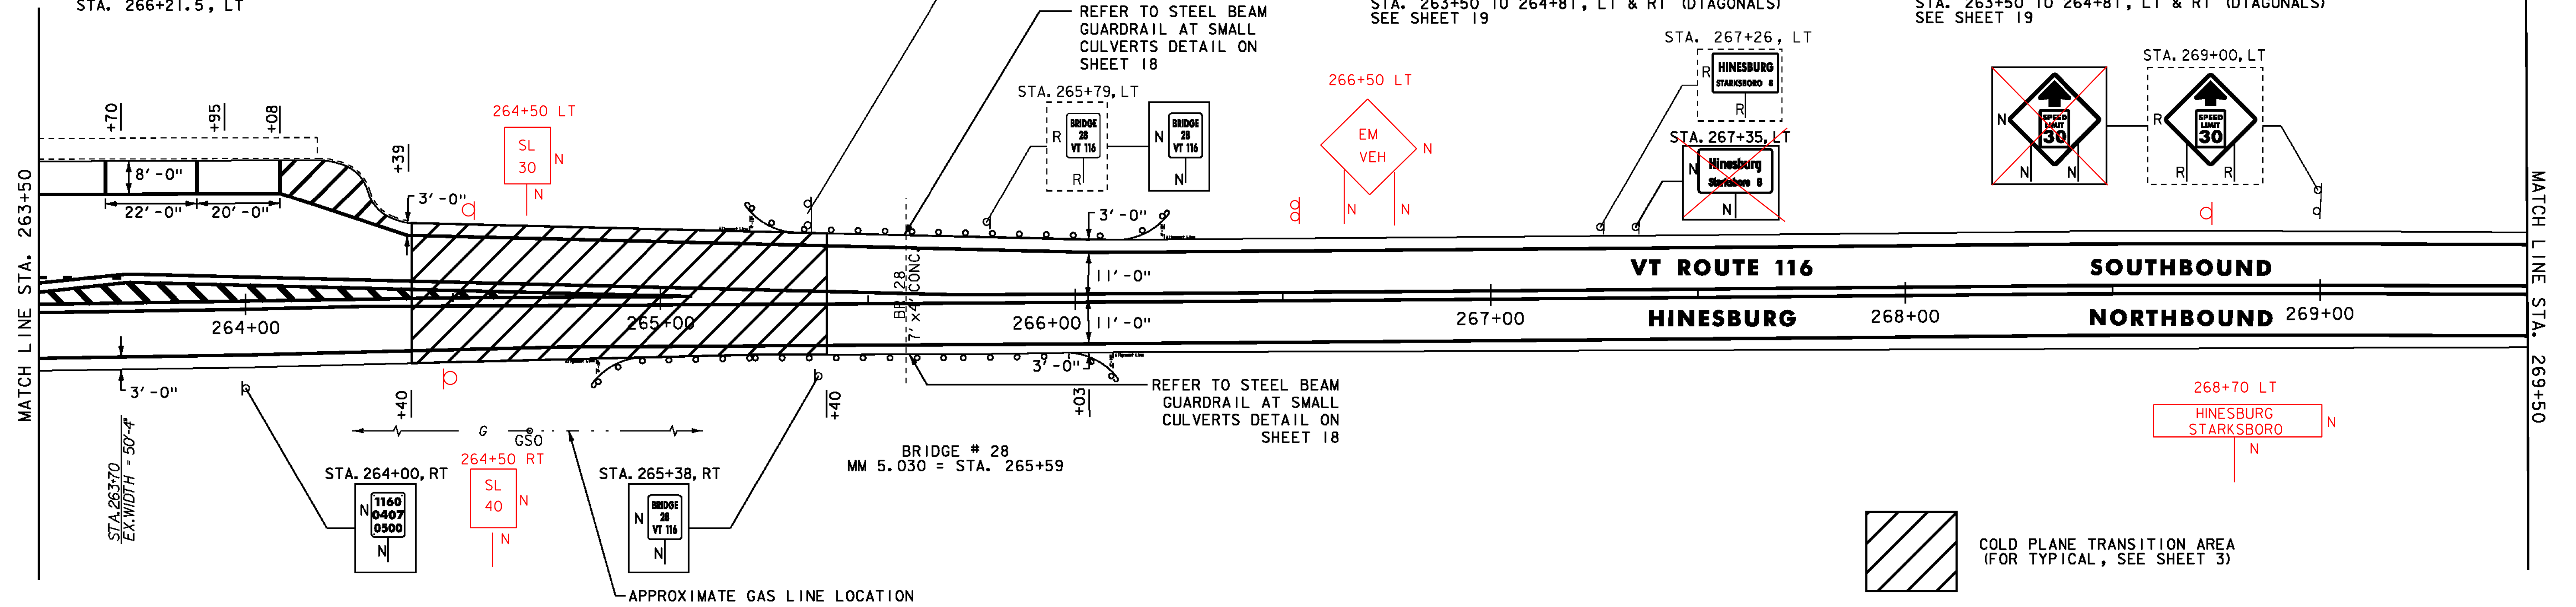


**DURABLE 4 INCH WHITE LINE**  
 (ALL LINES WILL INCLUDE EDGE LINE BREAKS AND  
 RADIUS FOR SIDE ROADS)  
 STA. 269+50 TO 275+50, SOLID LT & RT

**DURABLE 4 INCH YELLOW LINE**  
 (ALL LINES WILL INCLUDE C BREAKS FOR SIDE ROADS)  
 STA. 269+50 TO 275+50, SOLID LT & RT

**TEMPORARY 4 INCH WHITE LINE, PAINT**  
 (ALL LINES WILL INCLUDE EDGE LINE BREAKS AND  
 RADIUS FOR SIDE ROADS)  
 STA. 269+50 TO 275+50, SOLID LT & RT

**TEMPORARY 4 INCH YELLOW LINE, PAINT**  
 (ALL LINES WILL INCLUDE C BREAKS FOR SIDE ROADS)  
 STA. 269+50 TO 275+50, SOLID LT & RT

**REMOVING SIGNS  
AS SHOWN - 2**

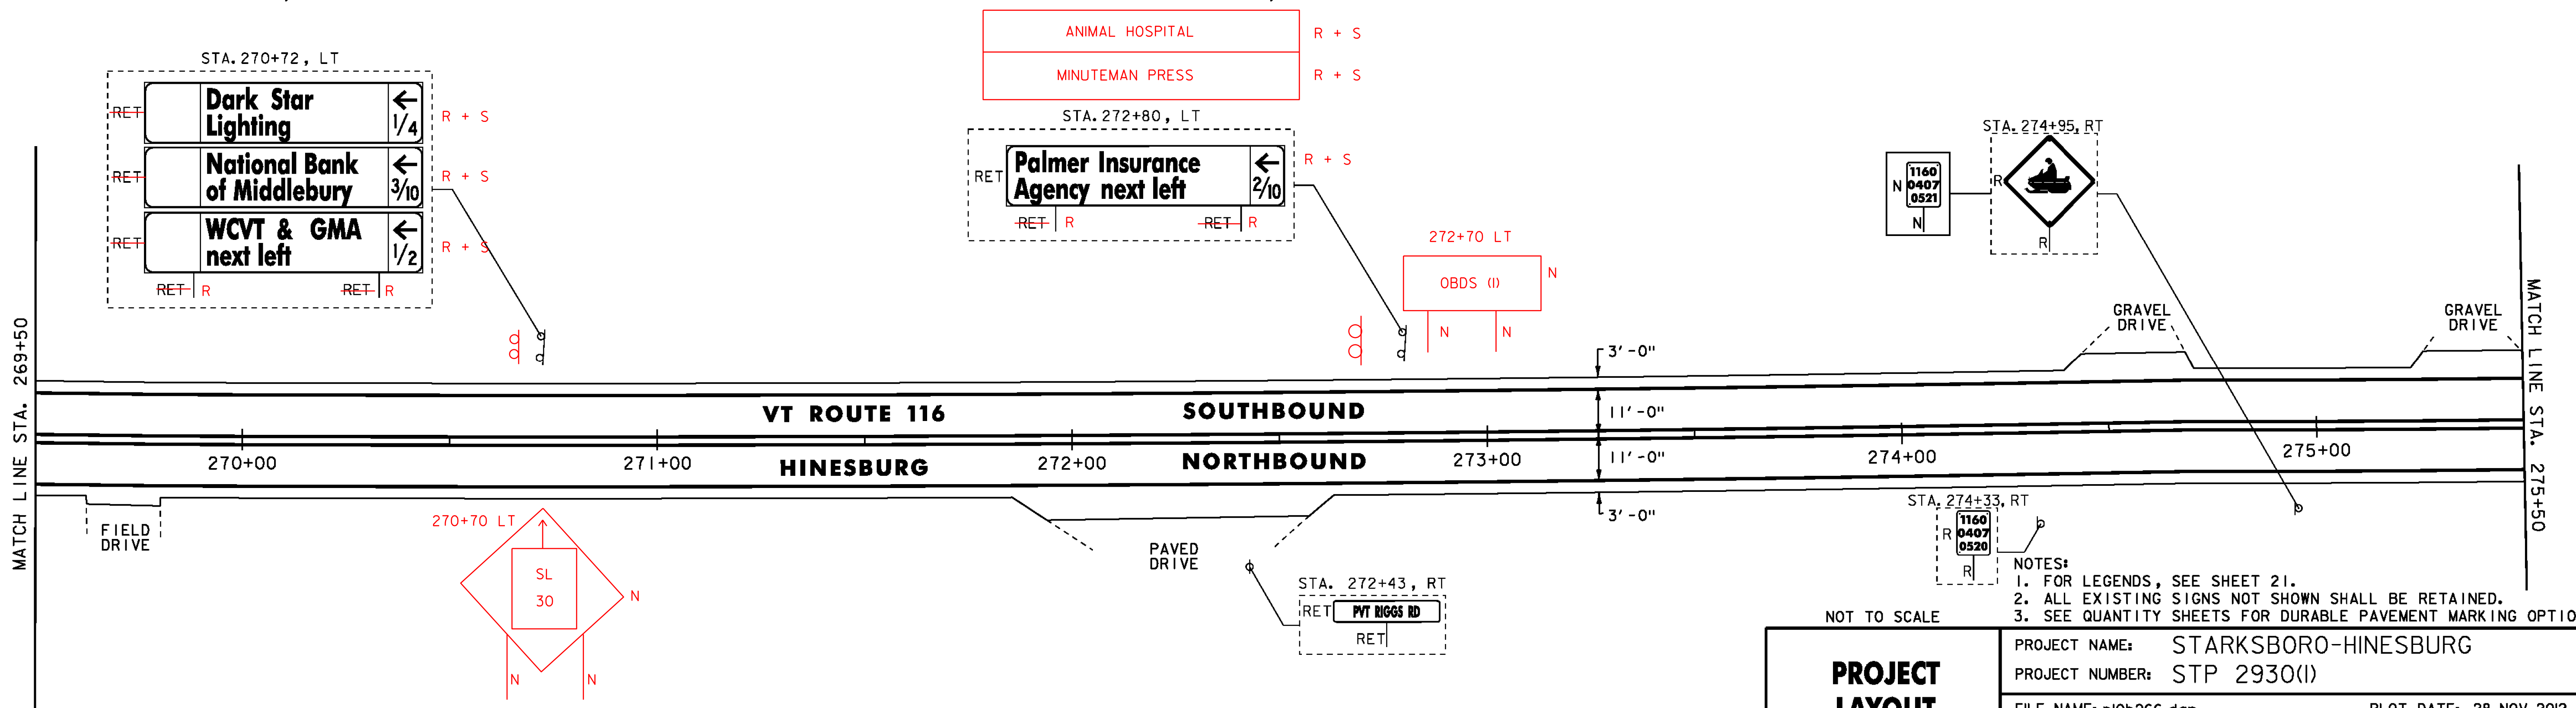

- NOTES:  
 1. FOR LEGENDS, SEE SHEET 21.  
 2. ALL EXISTING SIGNS NOT SHOWN SHALL BE RETAINED.  
 3. SEE QUANTITY SHEETS FOR DURABLE PAVEMENT MARKING OPTIONS.

NOT TO SCALE

**PROJECT  
LAYOUT  
SHEET #53**

PROJECT NAME:	STARKSBORO-HINESBURG
PROJECT NUMBER:	STP 2930(I)
FILE NAME:	p10b266.dgn
PROJECT LEADER:	JLL
DESIGNED BY:	STANTEC
IPARM FILE:	p10b266153.i
PLOT DATE:	28-NOV-2012
DRAWN BY:	STANTEC
CHECKED BY:	MCF
SHEET	73 OF 119

