


**DURABLE 4 INCH WHITE LINE**  
 (ALL LINES WILL INCLUDE EDGE LINE BREAKS AND  
 RADII FOR SIDE ROADS)  
 STA. 275+50 TO 279+50, SOLID LT & RT

**DURABLE 4 INCH YELLOW LINE**  
 (ALL LINES WILL INCLUDE @ BREAKS FOR SIDE ROADS)  
 STA. 275+50 TO 279+50, SOLID LT & RT

**TEMPORARY 4 INCH WHITE LINE, PAINT**  
 (ALL LINES WILL INCLUDE EDGE LINE BREAKS AND  
 RADII FOR SIDE ROADS)  
 STA. 275+50 TO 279+50, SOLID LT & RT

**TEMPORARY 4 INCH YELLOW LINE, PAINT**  
 (ALL LINES WILL INCLUDE @ BREAKS FOR SIDE ROADS)  
 STA. 275+50 TO 279+50, SOLID LT & RT

**REMOVING SIGNS**  
 AS SHOWN - 2

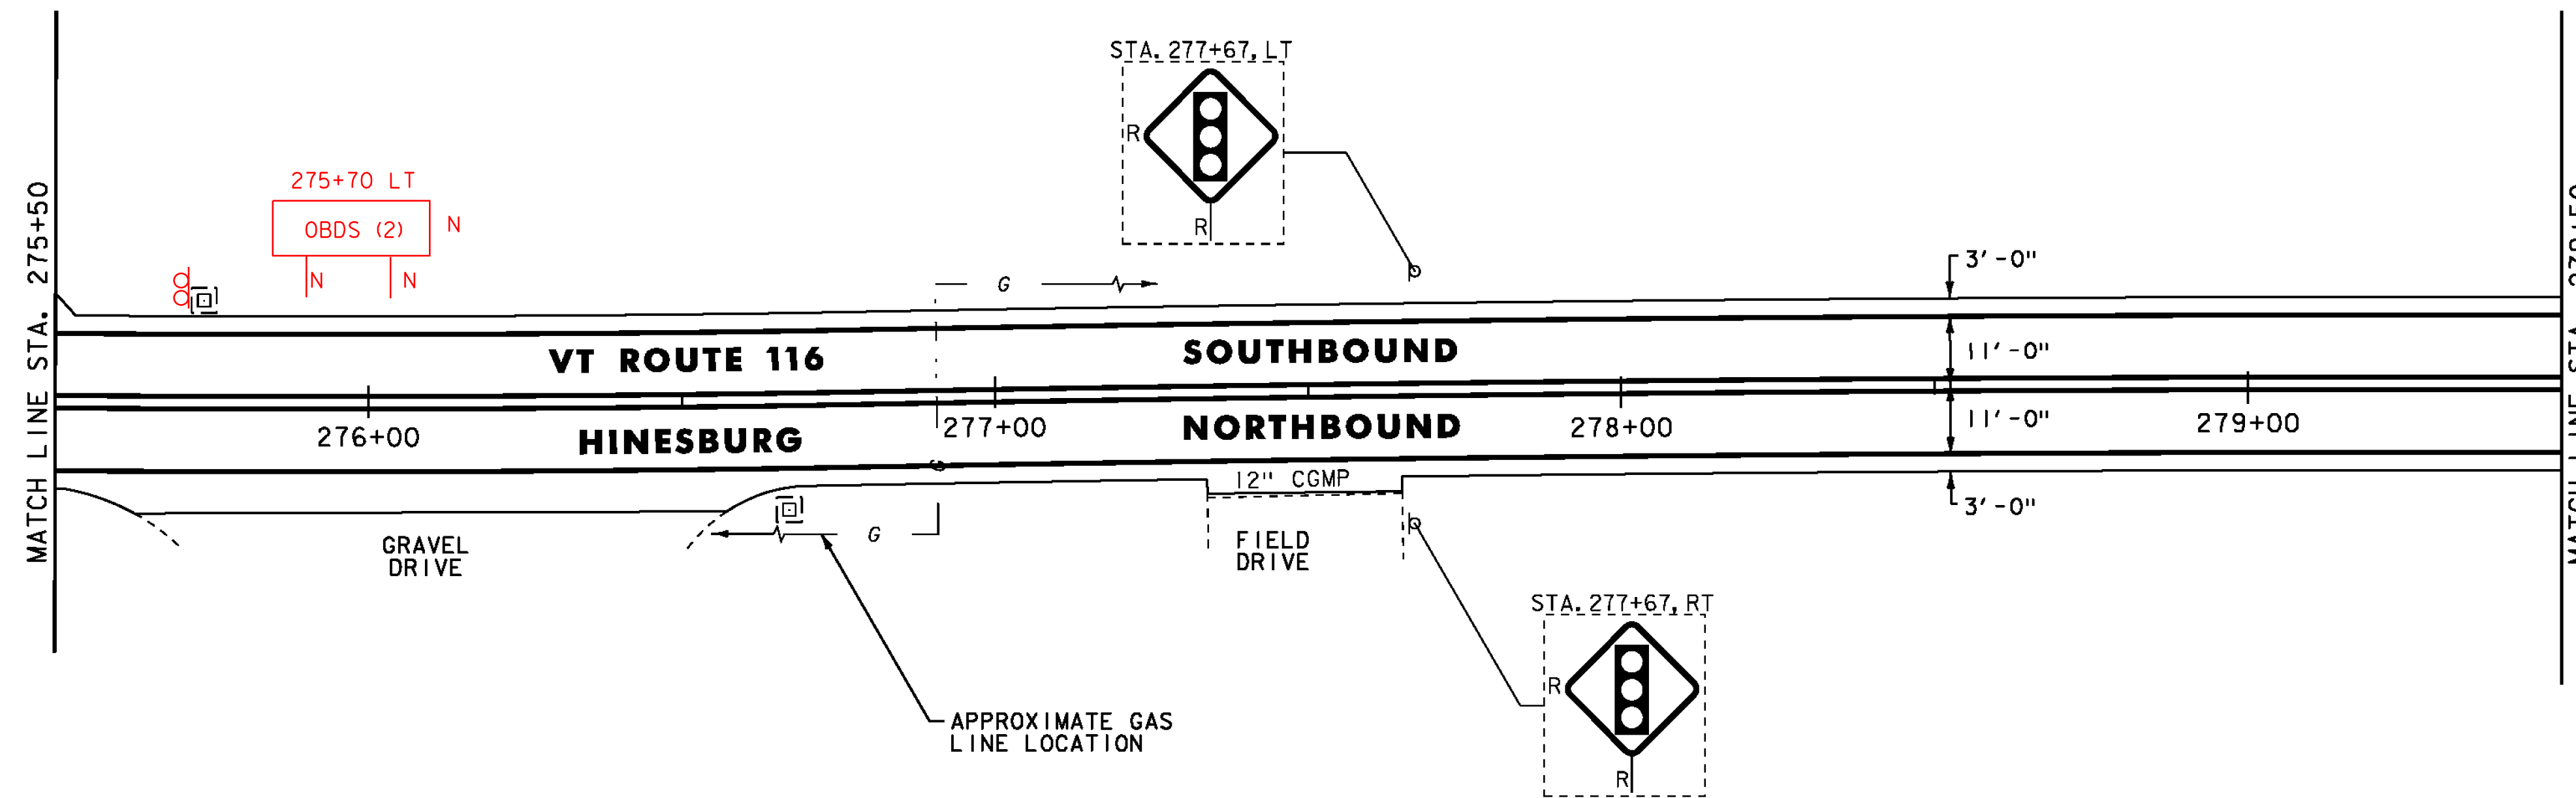


**DURABLE 4 INCH WHITE LINE**  
 (ALL LINES WILL INCLUDE EDGE LINE BREAKS AND  
 RADII FOR SIDE ROADS)  
 STA. 279+50 TO 284+50, SOLID LT & RT

**DURABLE 4 INCH YELLOW LINE**  
 (ALL LINES WILL INCLUDE @ BREAKS FOR SIDE ROADS)  
 STA. 279+50 TO 284+50, SOLID LT & RT

**TEMPORARY 4 INCH WHITE LINE, PAINT**  
 (ALL LINES WILL INCLUDE EDGE LINE BREAKS AND  
 RADII FOR SIDE ROADS)  
 STA. 279+50 TO 284+50, SOLID LT & RT

**TEMPORARY 4 INCH YELLOW LINE, PAINT**  
 (ALL LINES WILL INCLUDE @ BREAKS FOR SIDE ROADS)  
 STA. 279+50 TO 284+50, SOLID LT & RT

**REMOVING SIGNS**  
 AS SHOWN - 3

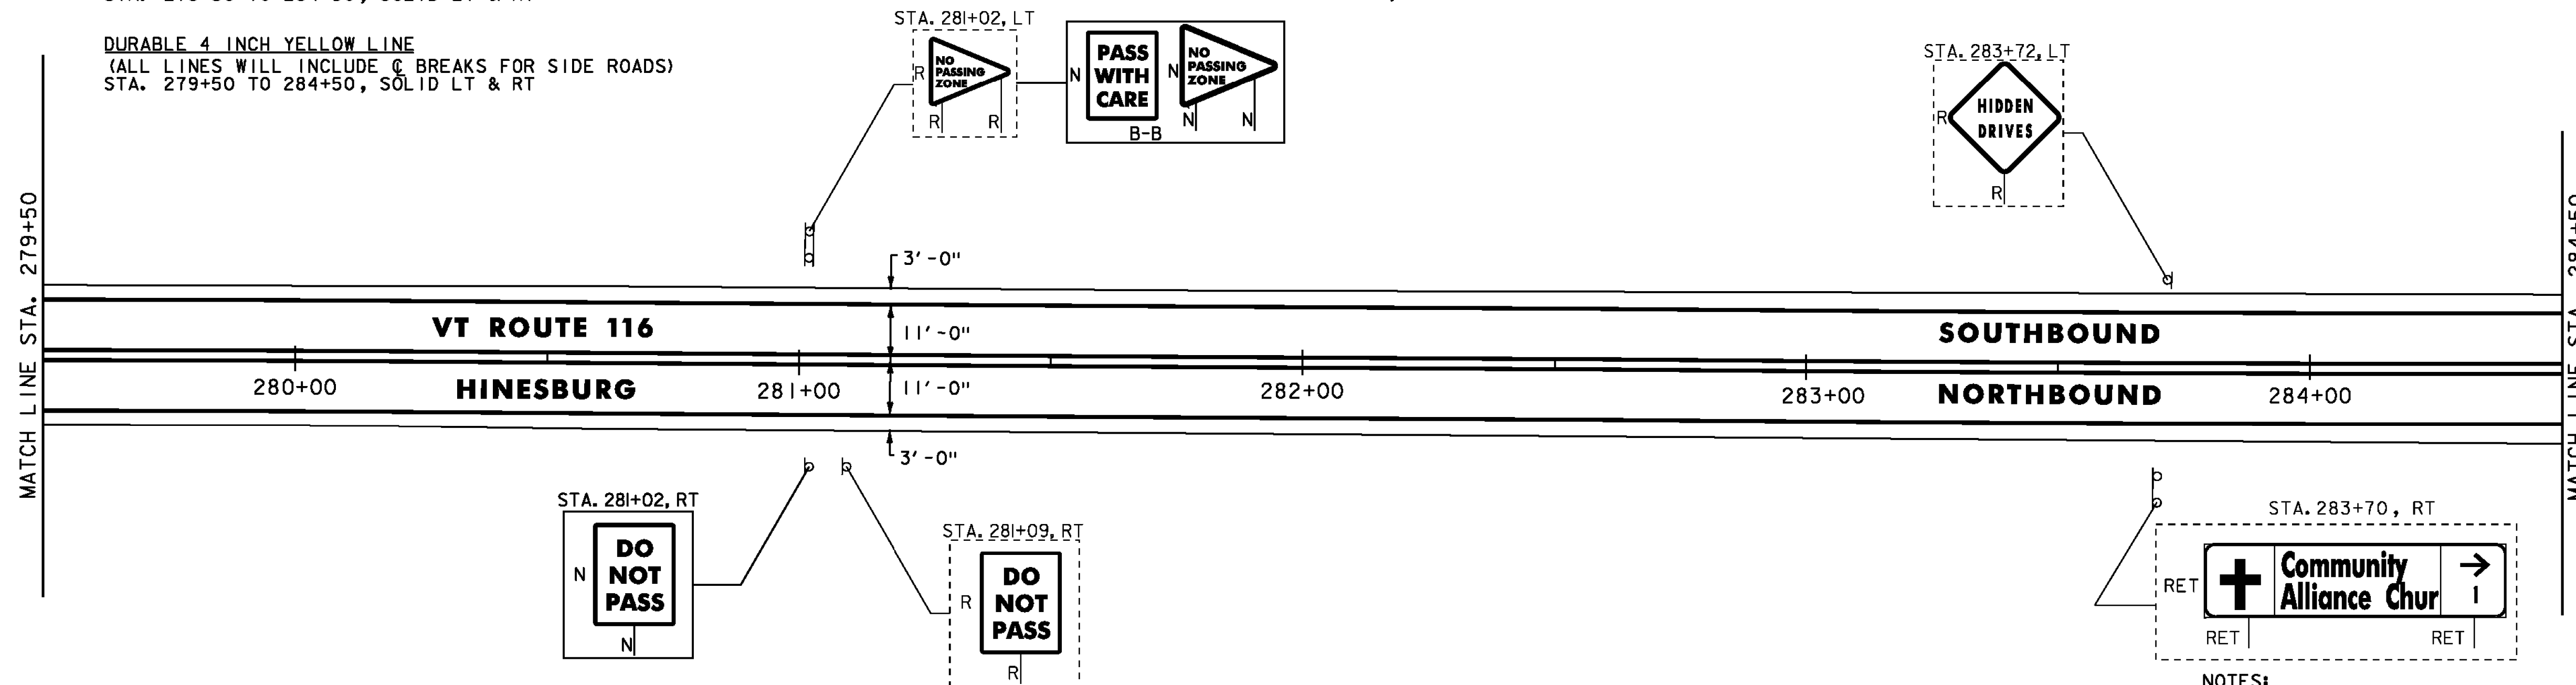

- NOTES:  
 1. FOR LEGENDS, SEE SHEET 21.  
 2. ALL EXISTING SIGNS NOT SHOWN SHALL BE RETAINED.  
 3. SEE QUANTITY SHEETS FOR DURABLE PAVEMENT MARKING OPTIONS.

NOT TO SCALE

**PROJECT  
 LAYOUT  
 SHEET #54**



PROJECT NAME: STARKSBORO-HINESBURG  
 PROJECT NUMBER: STP 2930(I)

FILE NAME: p10b266.dgn  
 PROJECT LEADER: JLL  
 DESIGNED BY: STANTEC  
 IPARM FILE: p10b266i54.i

PLOT DATE: 28-NOV-2012  
 DRAWN BY: STANTEC  
 CHECKED BY: MCF  
 SHEET 74 OF 119