

**STONE FILL, TYPE 1**  
 STA. 288+74 TO 288+80, LT  
 STA. 289+21 TO 289+27, LT

**STEEL BEAM GUARDRAIL, GALVANIZED**  
 STA. 288+30 TO 290+50, LT  
 STA. 288+42.5 TO 290+05, RT

**ANCHOR FOR STEEL BEAM RAIL**  
 STA. 288+30, LT  
 STA. 288+42.5, RT  
 STA. 290+05, RT

**REMOVAL AND DISPOSAL OF GUARDRAIL**  
 STA. 288+34 TO 290+50, LT  
 STA. 288+43 TO 290+08, RT

**24 INCH STOP BAR**  
 STA. 287+47, LT (SHELBURNE FALLS ROAD TH-1)  
 STA. 287+54, RT (CVU ROAD TH-7)

**DURABLE 4 INCH WHITE LINE**  
 (ALL LINES WILL INCLUDE EDGE LINE BREAKS AND RADIUS FOR SIDE ROADS)  
 STA. 284+50 TO 290+50, SOLID LT & RT  
 STA. 287+47, SOLID LT (EDGELINES, SHELBURNE FALLS ROAD TH-1)  
 STA. 287+54, SOLID RT (EDGELINES, CVU ROAD TH-7)

**DURABLE 4 INCH YELLOW LINE**  
 (ALL LINES WILL INCLUDE C BREAKS FOR SIDE ROADS)  
 STA. 284+50 TO 290+50, SOLID LT & RT  
 STA. 287+47, DOUBLE SOLID LT (SHELBURNE FALLS ROAD TH-1)  
 STA. 287+54, DOUBLE SOLID RT (CVU ROAD TH-7)

**DURABLE 24 INCH STOP BAR**  
 STA. 286+90, RT  
 STA. 288+05, LT

**DURABLE CROSSWALK MARKING**  
 STA. 287+90, LT TO RT

**TEMPORARY 4 INCH WHITE LINE, PAINT**  
 (ALL LINES WILL INCLUDE EDGE LINE BREAKS AND RADIUS FOR SIDE ROADS)  
 STA. 284+50 TO 290+50, SOLID LT & RT  
 STA. 287+47, SOLID LT (EDGELINES, SHELBURNE FALLS ROAD TH-1)  
 STA. 287+54, SOLID RT (EDGELINES, CVU ROAD TH-7)

**TEMPORARY 4 INCH YELLOW LINE, PAINT**  
 (ALL LINES WILL INCLUDE C BREAKS FOR SIDE ROADS)  
 STA. 284+50 TO 290+50, SOLID LT & RT  
 STA. 287+47, DOUBLE SOLID LT (SHELBURNE FALLS ROAD TH-1)  
 STA. 287+54, DOUBLE SOLID RT (CVU ROAD TH-7)


**TEMPORARY 24 INCH STOP BAR, PAINT**  
 STA. 286+90, RT  
 STA. 287+47, LT (SHELBURNE FALLS ROAD TH-1)  
 STA. 287+54, RT (CVU ROAD TH-7)  
 STA. 288+05, LT

**TEMPORARY CROSSWALK MARKING, PAINT**  
 STA. 287+90, LT TO RT

**GEOTEXTILE UNDER STONE FILL**  
 STA. 288+74 TO 288+80, LT  
 STA. 289+21 TO 289+27, LT

**GRUBBING MATERIAL**  
 STA. 288+74 TO 288+80, LT  
 STA. 289+21 TO 289+27, LT

**REMOVING SIGNS**  
 AS SHOWN - 18

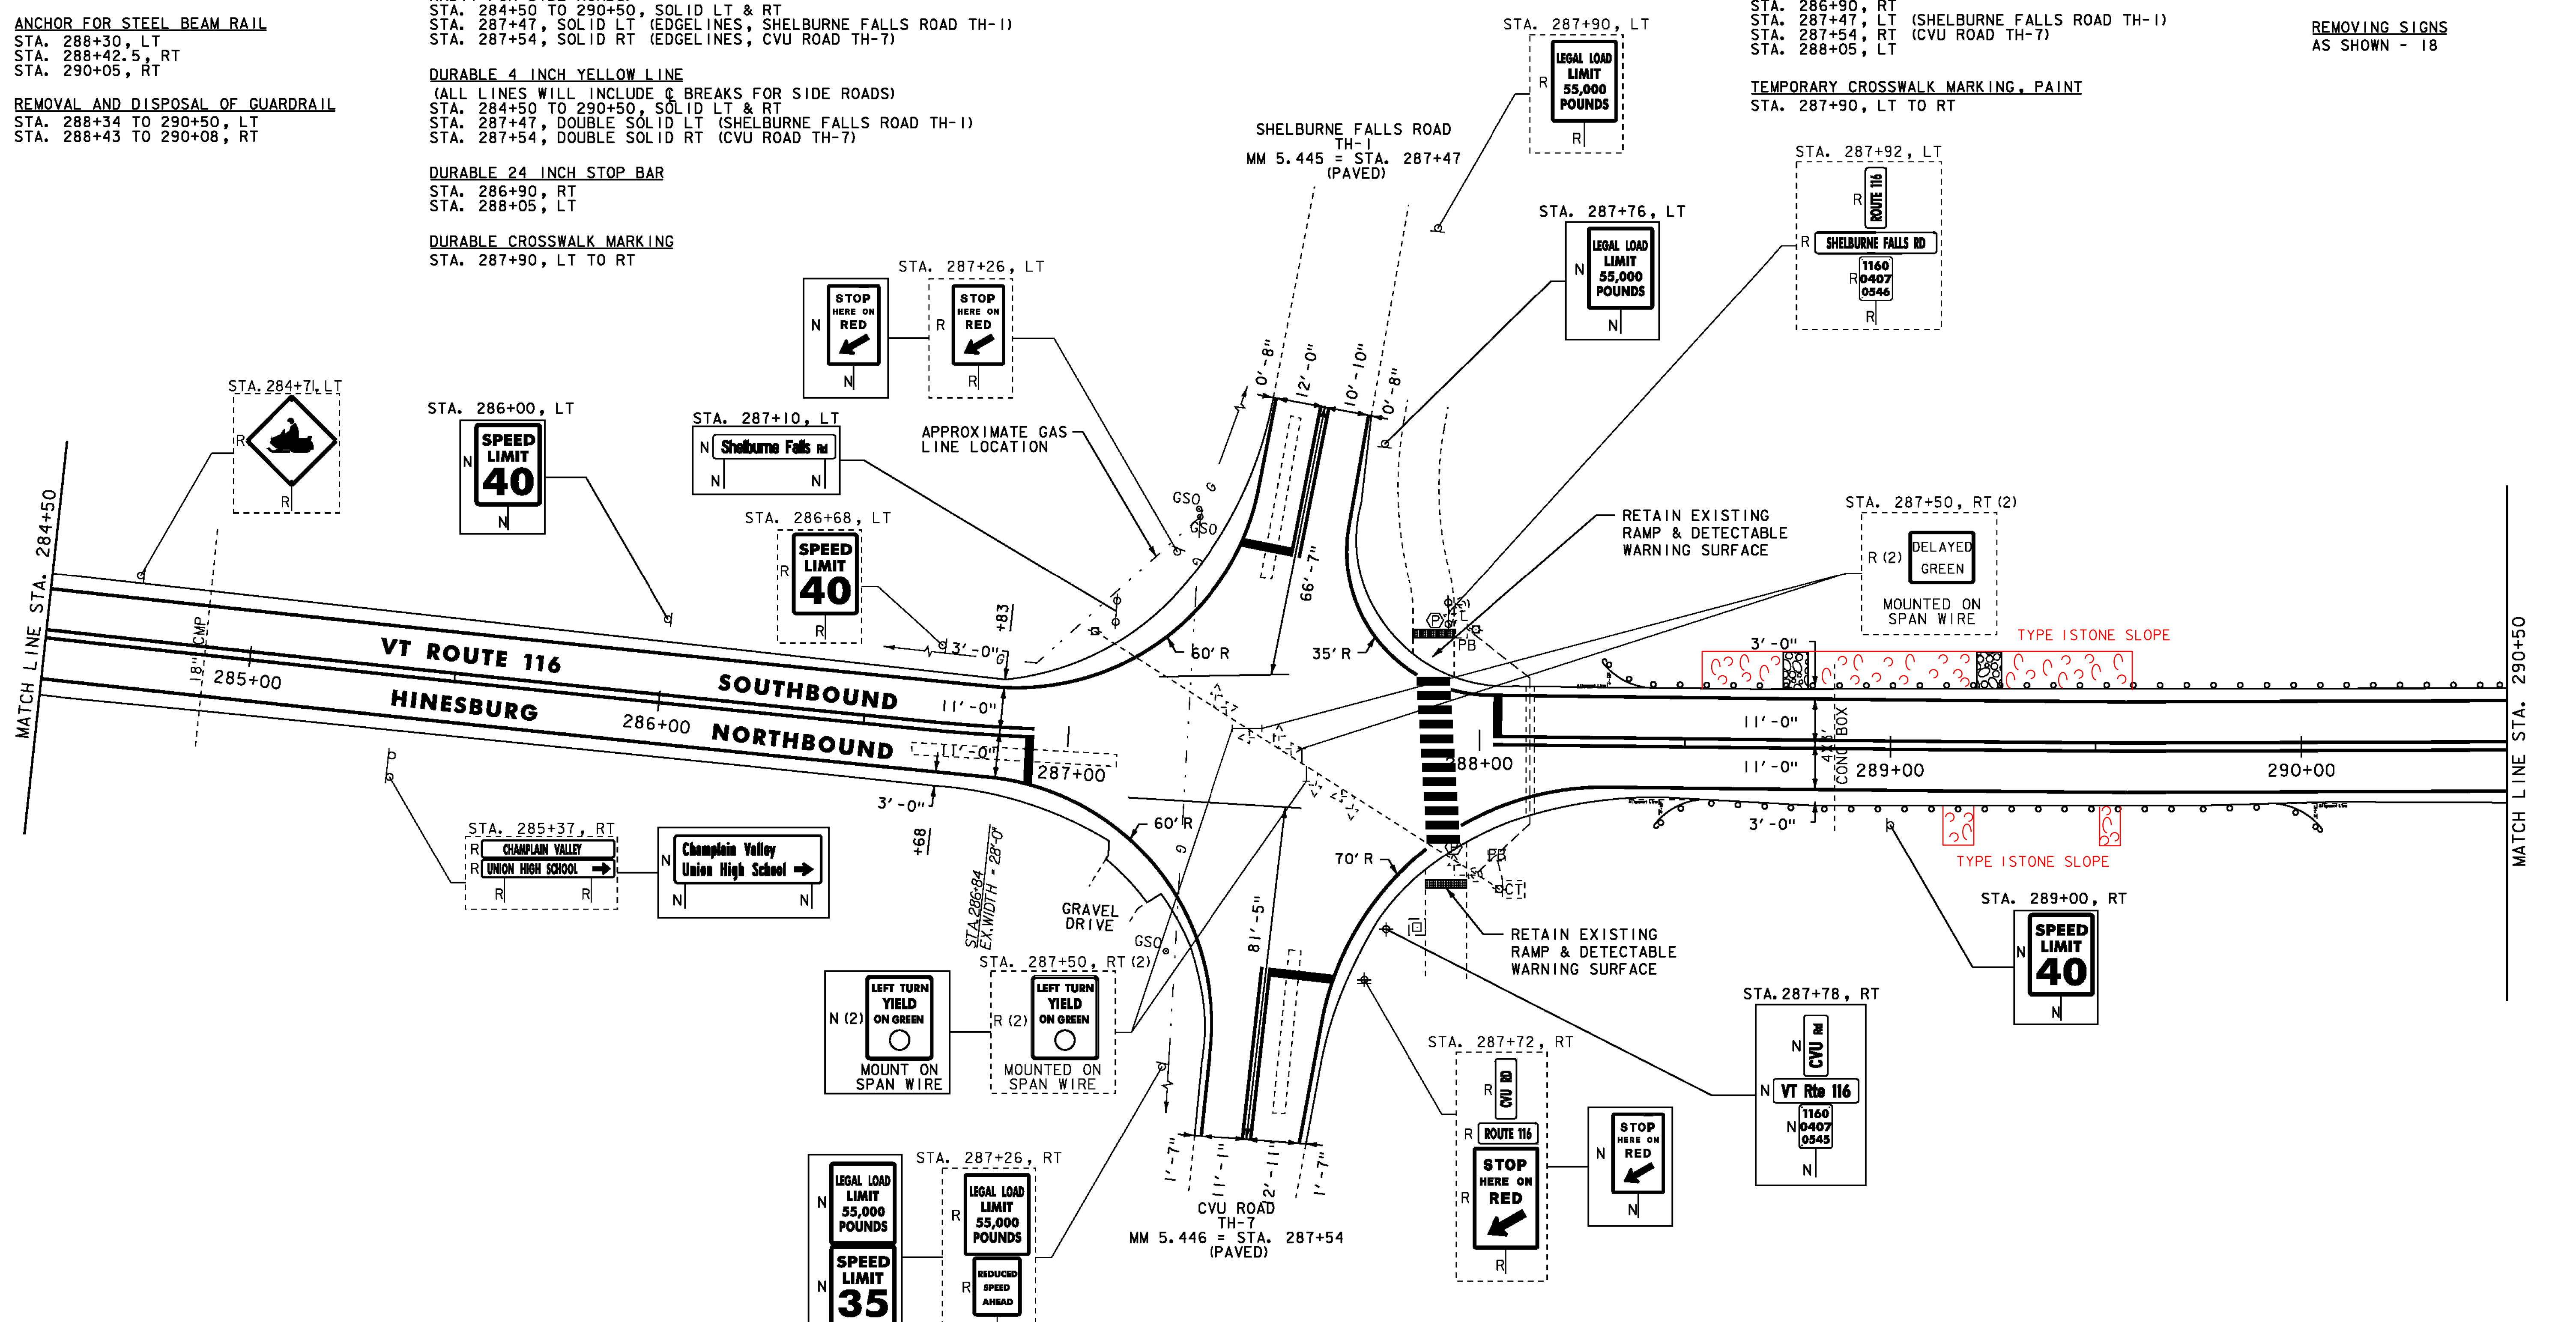

NOTES:  
 1. FOR LEGENDS, SEE SHEET 21.  
 2. ALL EXISTING SIGNS NOT SHOWN SHALL BE RETAINED.  
 3. SEE QUANTITY SHEETS FOR DURABLE PAVEMENT MARKING OPTIONS.

NOT TO SCALE

<b>PROJECT LAYOUT SHEET #55</b>	PROJECT NAME: STARKSBORO-HINESBURG
	PROJECT NUMBER: STP 2930(I)
	FILE NAME: p10b266.dgn
	PLOT DATE: 28-NOV-2012
PROJECT LEADER: JLL	DRAWN BY: STANTEC
DESIGNED BY: STANTEC	CHECKED BY: MCF
IPARM FILE: p10b266155.i	SHEET 75 OF 119

