

24 INCH STOP BAR
 STA. 315+58, RT (PLACE ROAD WEST TH-15)

LETTER OR SYMBOL
 STA. 315+58, RT "STOP" (PLACE ROAD WEST TH-15)

DURABLE 4 INCH WHITE LINE
 (ALL LINES WILL INCLUDE EDGE LINE BREAKS AND RADI FOR SIDE ROADS)
 STA. 314+50 TO 320+50, SOLID LT & RT
 STA. 315+58, SOLID RT (EDGELINES, PLACE ROAD WEST TH-15)

DURABLE 4 INCH YELLOW LINE
 (ALL LINES WILL INCLUDE & BREAKS FOR SIDE ROADS)
 STA. 314+50 TO 320+50, SOLID LT & RT
 STA. 315+58, DOUBLE SOLID RT (PLACE ROAD WEST TH-15)


TEMPORARY 4 INCH WHITE LINE, PAINT
 (ALL LINES WILL INCLUDE EDGE LINE BREAKS AND RADI FOR SIDE ROADS)
 STA. 314+50 TO 320+50, SOLID LT & RT
 STA. 315+58, SOLID RT (EDGELINES, PLACE ROAD WEST TH-15)

TEMPORARY 4 INCH YELLOW LINE, PAINT
 (ALL LINES WILL INCLUDE & BREAKS FOR SIDE ROADS)
 STA. 314+50 TO 320+50, SOLID LT & RT
 STA. 315+58, DOUBLE SOLID RT (PLACE ROAD WEST TH-15)

REMOVING SIGNS
 AS SHOWN - 6

TEMPORARY 24 INCH STOP BAR, PAINT
 STA. 315+58, RT (PLACE ROAD WEST TH-15)

TEMPORARY LETTER OR SYMBOL, PAINT
 STA. 315+58, RT "STOP" (PLACE ROAD WEST TH-15)

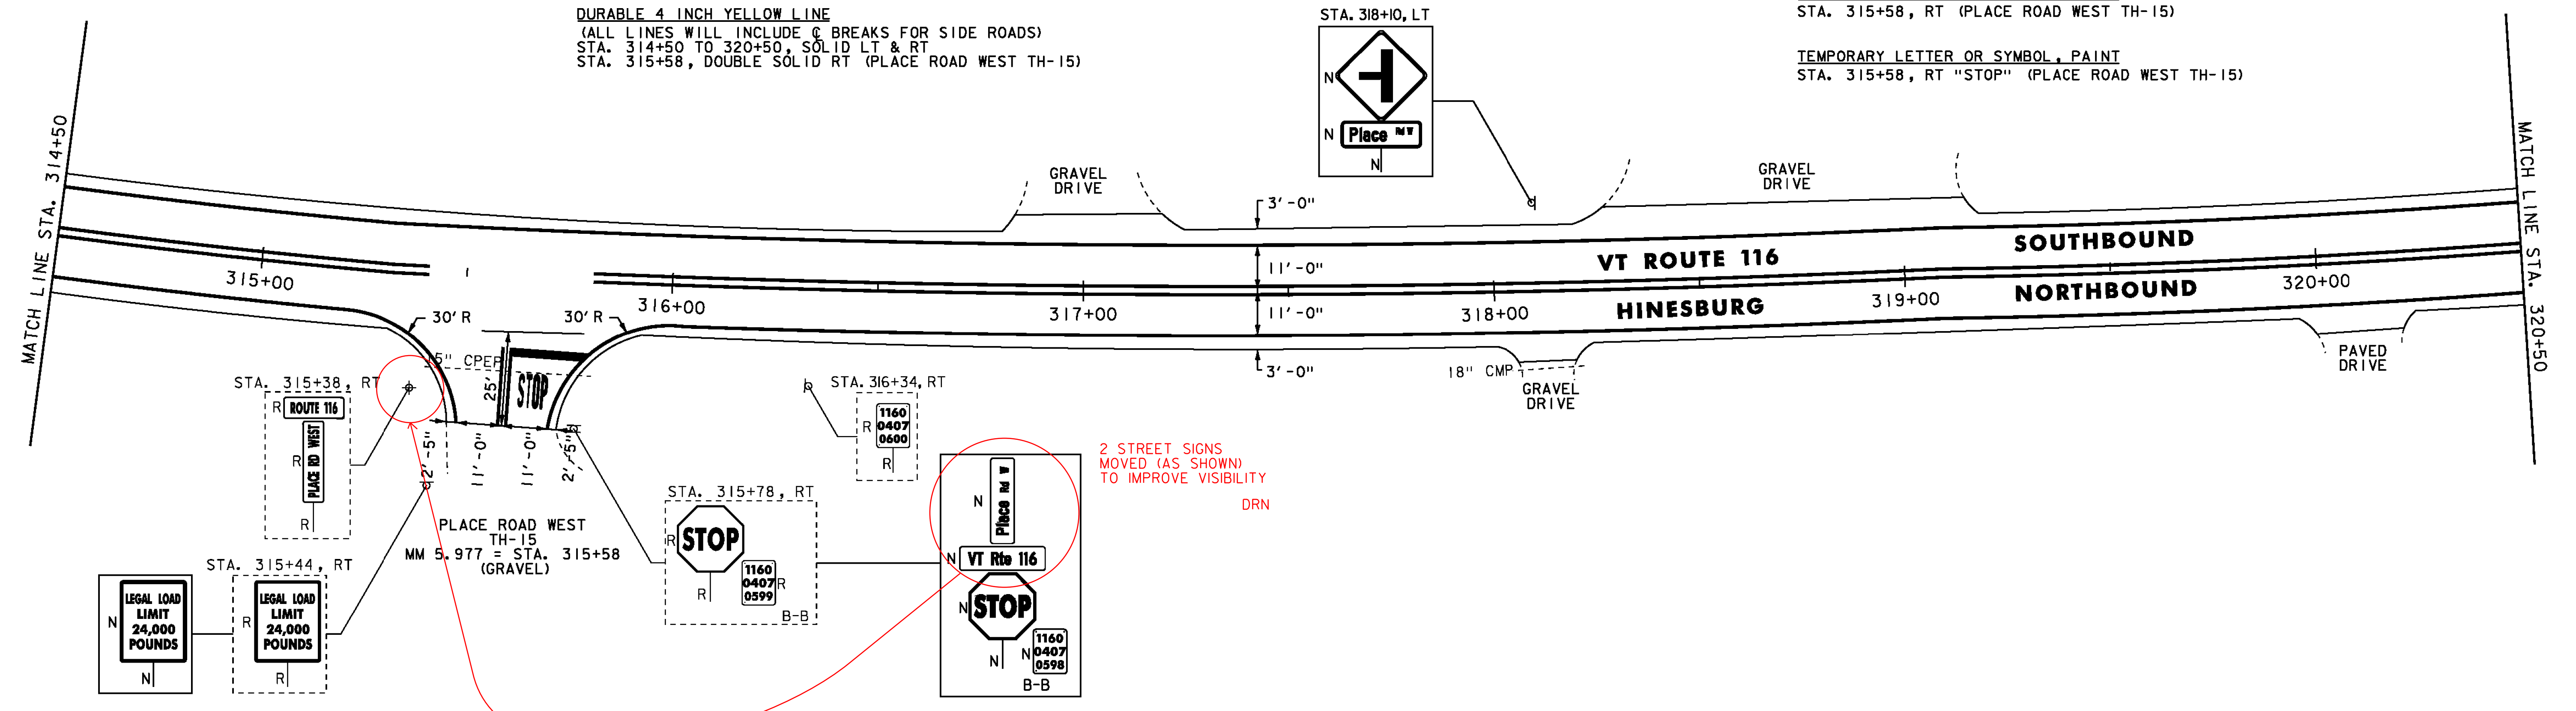

2 STREET SIGNS
 MOVED (AS SHOWN)
 TO IMPROVE VISIBILITY
 DRN


DURABLE 4 INCH WHITE LINE
 (ALL LINES WILL INCLUDE EDGE LINE BREAKS AND RADI FOR SIDE ROADS)
 STA. 320+50 TO 326+50, SOLID LT & RT

DURABLE 4 INCH YELLOW LINE
 (ALL LINES WILL INCLUDE & BREAKS FOR SIDE ROADS)
 STA. 320+50 TO 326+50, SOLID LT & RT

TEMPORARY 4 INCH WHITE LINE, PAINT
 (ALL LINES WILL INCLUDE EDGE LINE BREAKS AND RADI FOR SIDE ROADS)
 STA. 320+50 TO 326+50, SOLID LT & RT

TEMPORARY 4 INCH YELLOW LINE, PAINT
 (ALL LINES WILL INCLUDE & BREAKS FOR SIDE ROADS)
 STA. 320+50 TO 326+50, SOLID LT & RT

REMOVING SIGNS
 AS SHOWN - 1

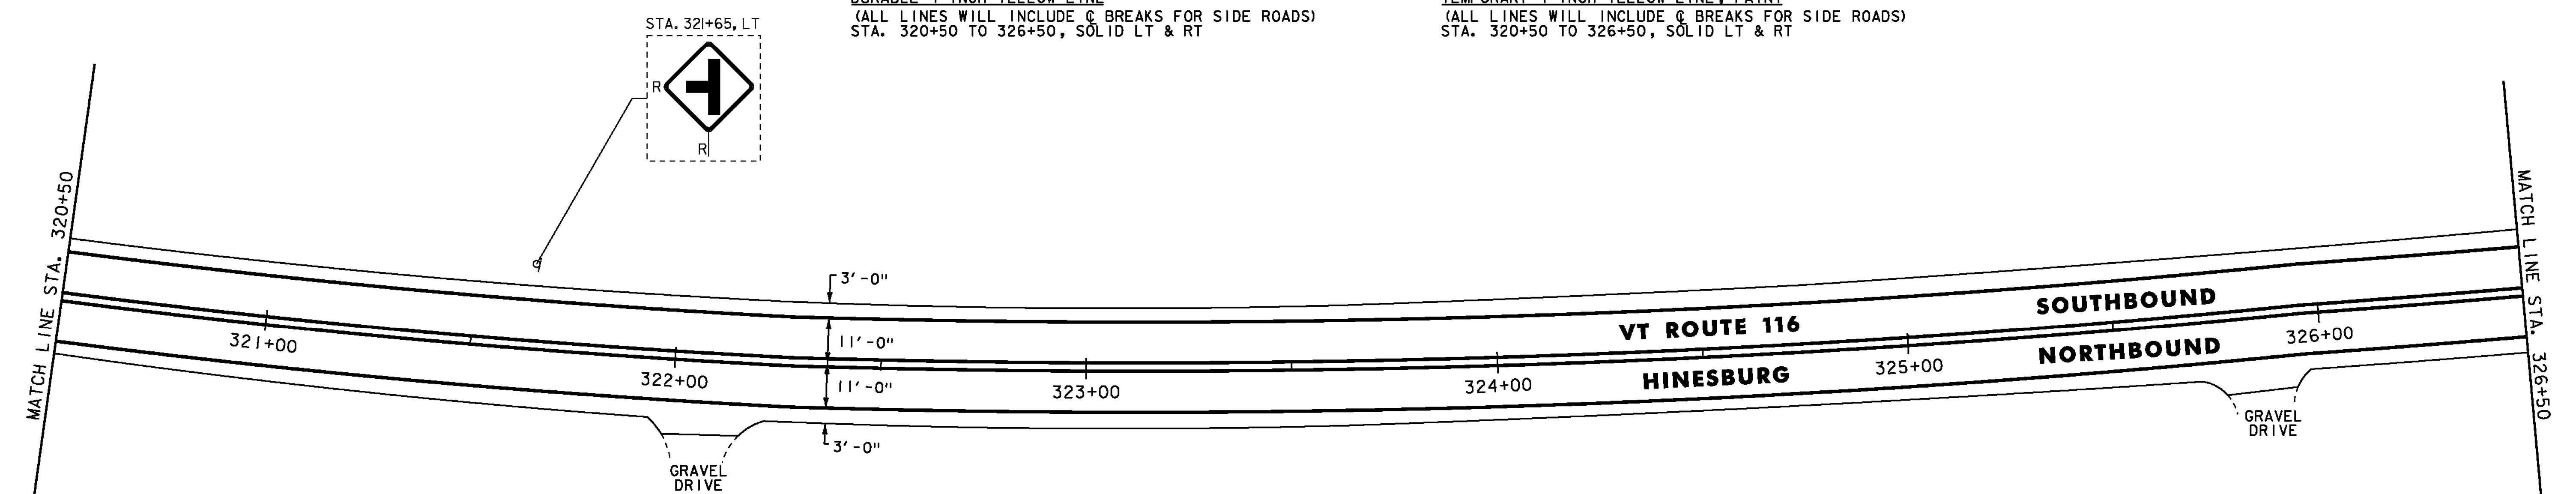

NOTES:
 1. FOR LEGENDS, SEE SHEET 21.
 2. ALL EXISTING SIGNS NOT SHOWN SHALL BE RETAINED.
 3. SEE QUANTITY SHEETS FOR DURABLE PAVEMENT MARKING OPTIONS.

NOT TO SCALE

PROJECT LAYOUT SHEET #58



PROJECT NAME: STARKSBORO-HINESBURG	PLOT DATE: 28-NOV-2012
PROJECT NUMBER: STP 2930(I)	DRAWN BY: STANTEC
FILE NAME: p10b266.dgn	CHECKED BY: MCF
PROJECT LEADER: JLL	SHEET 78 OF 119
DESIGNED BY: STANTEC	
IPARM FILE: p10b266158.i	