

STONE FILL, TYPE I  
 STA. 327+37 TO 327+43, LT  
 STA. 327+69 TO 327+75, LT  
 STA. 327+77 TO 327+83, LT  
 STA. 327+92 TO 328+10, LT  
 STA. 329+16 TO 329+22, RT

BITUMINOUS CONCRETE GUTTERS  
 AND TRAFFIC ISLANDS  
 STA. 328+90, LT  
 FOR DETAIL, SEE SHEET 18.

STA. 326+64, LT

STEEL BEAM GUARDRAIL, GALVANIZED  
 W/8 FEET POSTS  
 STA. 326+88.5 TO 330+51, LT  
 STA. 327+05 TO 330+80, RT

ANCHOR FOR STEEL BEAM RAIL  
 STA. 326+88.5, LT  
 STA. 327+05, RT  
 STA. 330+51, LT  
 STA. 330+80, RT

REMOVAL AND DISPOSAL OF GUARDRAIL  
 STA. 326+86 TO 330+52, LT  
 STA. 327+08 TO 330+84, RT

DURABLE 4 INCH WHITE LINE  
 (ALL LINES WILL INCLUDE EDGE LINE BREAKS AND  
 RADII FOR SIDE ROADS)  
 STA. 326+50 TO 332+50, SOLID LT & RT

DURABLE 4 INCH YELLOW LINE  
 (ALL LINES WILL INCLUDE C BREAKS FOR SIDE ROADS)  
 STA. 326+50 TO 332+50, SOLID LT & RT


TEMPORARY 4 INCH WHITE LINE, PAINT  
 (ALL LINES WILL INCLUDE EDGE LINE BREAKS AND  
 RADII FOR SIDE ROADS)  
 STA. 326+50 TO 332+50, SOLID LT & RT

TEMPORARY 4 INCH YELLOW LINE, PAINT  
 (ALL LINES WILL INCLUDE C BREAKS FOR SIDE ROADS)  
 STA. 326+50 TO 332+50, SOLID LT & RT

GEOTEXTILE UNDER STONE FILL  
 STA. 327+37 TO 327+43, LT  
 STA. 327+69 TO 327+75, LT  
 STA. 327+77 TO 327+83, LT  
 STA. 327+92 TO 328+10, LT  
 STA. 329+16 TO 329+22, RT

GRUBBING MATERIAL  
 STA. 327+37 TO 327+43, LT  
 STA. 327+69 TO 327+75, LT  
 STA. 327+77 TO 327+83, LT  
 STA. 327+92 TO 328+10, LT  
 STA. 329+16 TO 329+22, RT

REMOVING SIGNS  
 AS SHOWN - 1

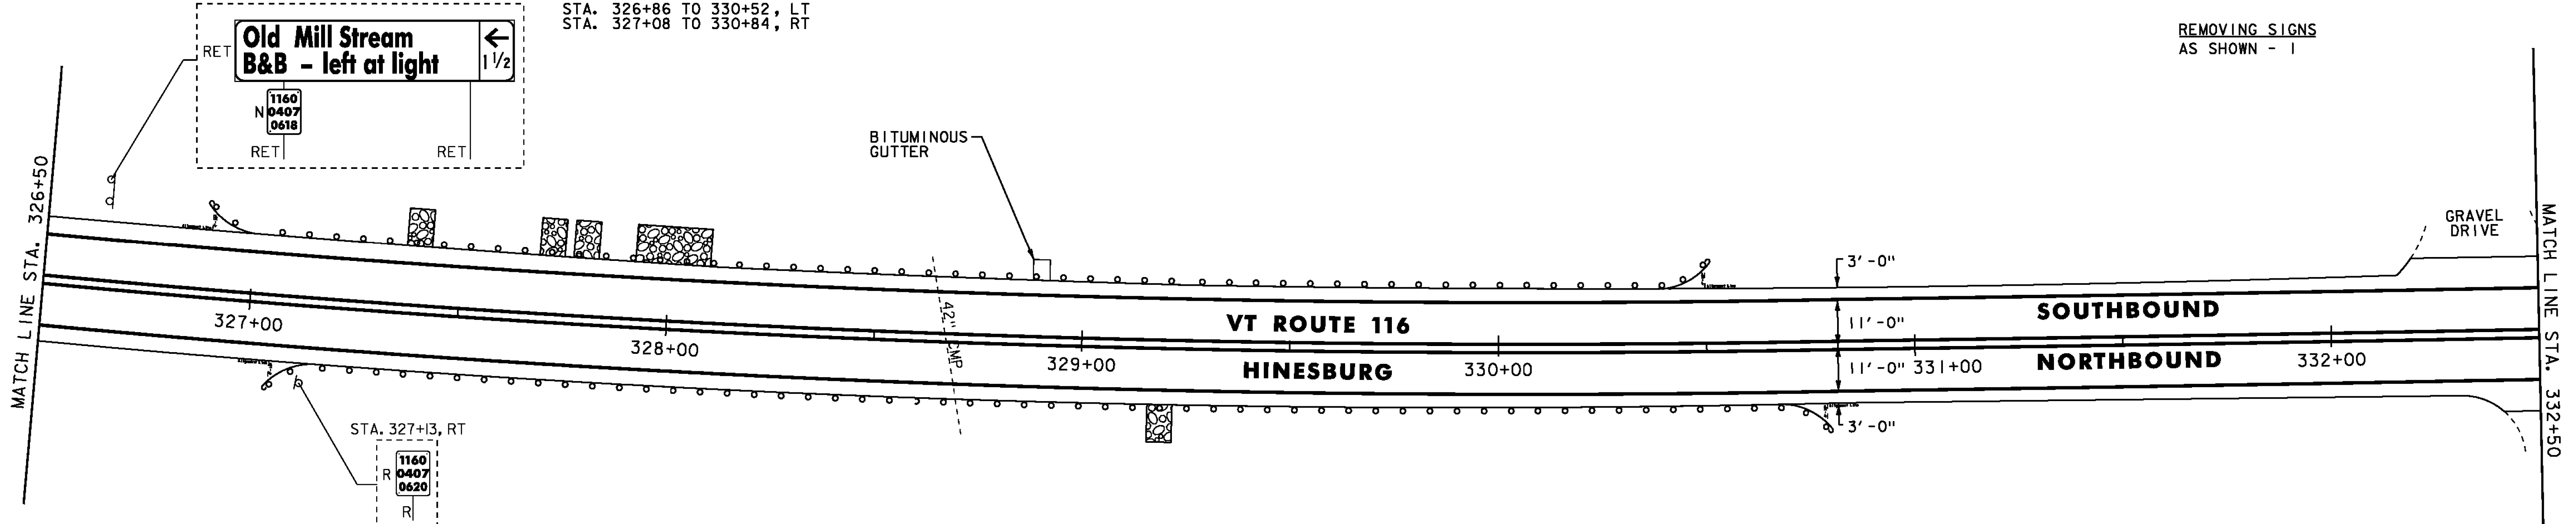

STEEL BEAM GUARDRAIL, GALVANIZED W/8 FEET POSTS  
 STA. 337+92.5 TO 338+50, LT  
 STA. 337+95 TO 338+50, RT

ANCHOR FOR STEEL BEAM RAIL  
 STA. 337+92.5, LT  
 STA. 337+95, RT

REMOVAL AND DISPOSAL OF GUARDRAIL  
 STA. 337+92.5 TO 338+50, LT  
 STA. 337+94 TO 338+50, RT


DURABLE 4 INCH WHITE LINE  
 (ALL LINES WILL INCLUDE EDGE LINE BREAKS AND  
 RADII FOR SIDE ROADS)  
 STA. 332+50 TO 338+50, SOLID LT & RT

DURABLE 4 INCH YELLOW LINE  
 (ALL LINES WILL INCLUDE C BREAKS FOR SIDE ROADS)  
 STA. 332+50 TO 338+50, SOLID LT & RT

TEMPORARY 4 INCH WHITE LINE, PAINT  
 (ALL LINES WILL INCLUDE EDGE LINE BREAKS AND  
 RADII FOR SIDE ROADS)  
 STA. 332+50 TO 338+50, SOLID LT & RT

TEMPORARY 4 INCH YELLOW LINE, PAINT  
 (ALL LINES WILL INCLUDE C BREAKS FOR SIDE ROADS)  
 STA. 332+50 TO 338+50, SOLID LT & RT

REMOVING SIGNS  
 AS SHOWN - 1

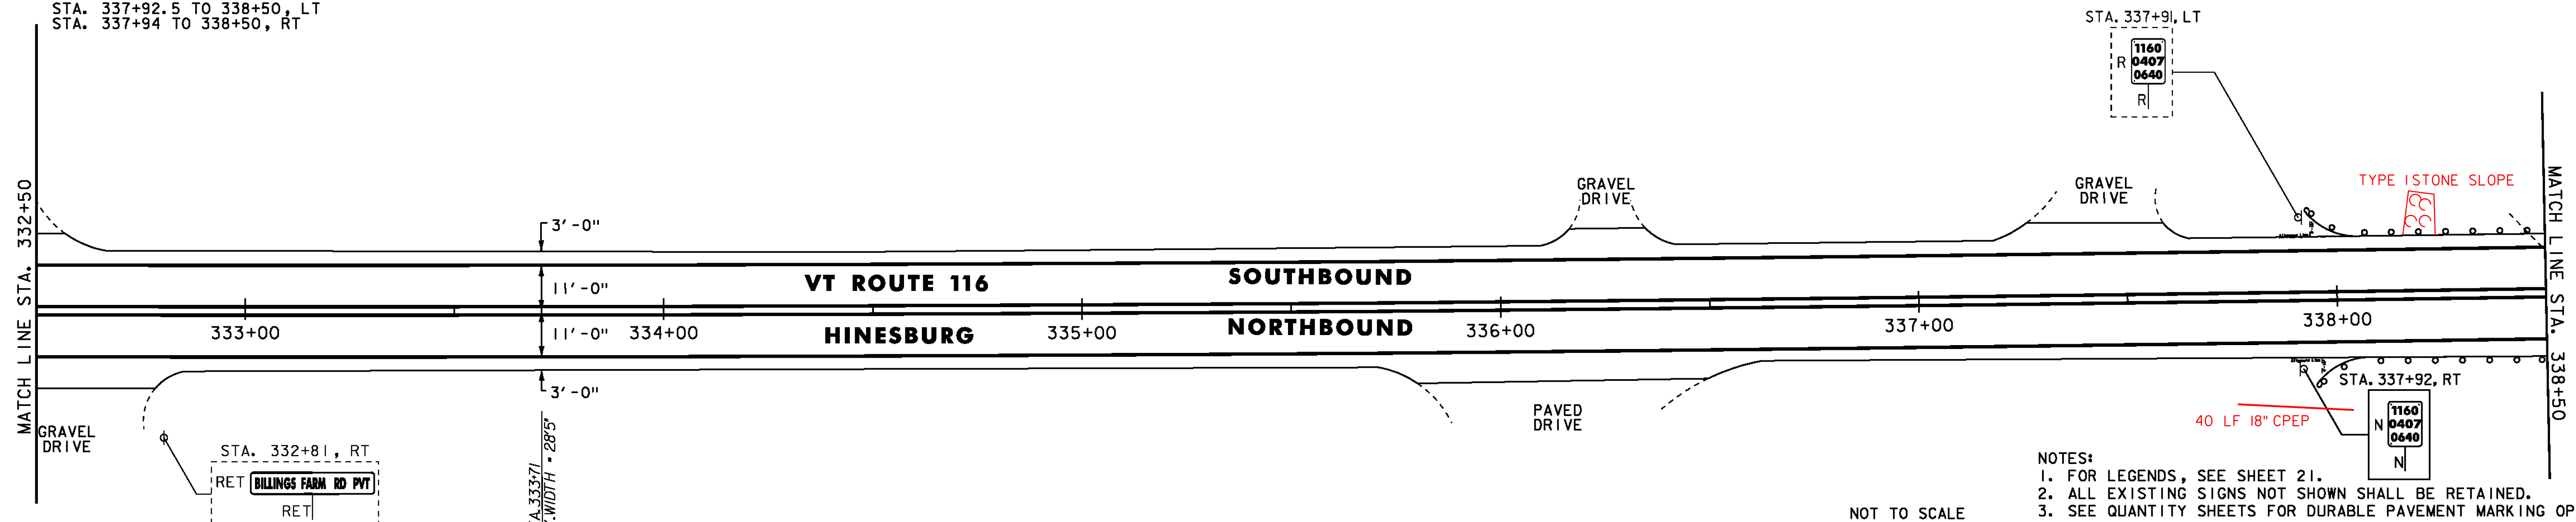

- NOTES:  
 1. FOR LEGENDS, SEE SHEET 21.  
 2. ALL EXISTING SIGNS NOT SHOWN SHALL BE RETAINED.  
 3. SEE QUANTITY SHEETS FOR DURABLE PAVEMENT MARKING OPTIONS.

NOT TO SCALE

**PROJECT  
 LAYOUT  
 SHEET #59**



PROJECT NAME: STARKSBORO-HINESBURG  
 PROJECT NUMBER: STP 2930(I)

FILE NAME: p10b266.dgn  
 PROJECT LEADER: JLL  
 DESIGNED BY: STANTEC  
 IPARM FILE: p10b266159.i

PLOT DATE: 28-NOV-2012  
 DRAWN BY: STANTEC  
 CHECKED BY: MCF  
 SHEET 79 OF 119