

STEEL BEAM GUARDRAIL, GALVANIZED
 STA. 343+47 TO 344+50, LT

STEEL BEAM GUARDRAIL, GALVANIZED W/8 FEET POSTS
 STA. 338+50 TO 339+05, LT
 STA. 338+50 TO 339+45, RT

ANCHOR FOR STEEL BEAM RAIL
 STA. 339+05, LT
 STA. 339+45, RT
 STA. 343+47, LT


REMOVAL AND DISPOSAL OF GUARDRAIL
 STA. 338+50 TO 339+08, LT
 STA. 338+50 TO 339+46, RT
 STA. 343+46.5 TO 344+50, LT

DURABLE 4 INCH WHITE LINE
 (ALL LINES WILL INCLUDE EDGE LINE BREAKS AND
 RADII FOR SIDE ROADS)
 STA. 338+50 TO 344+50, SOLID LT & RT

DURABLE 4 INCH YELLOW LINE
 (ALL LINES WILL INCLUDE C BREAKS FOR SIDE ROADS)
 STA. 338+50 TO 344+50, SOLID LT & RT

TEMPORARY 4 INCH WHITE LINE, PAINT
 (ALL LINES WILL INCLUDE EDGE LINE BREAKS AND
 RADII FOR SIDE ROADS)
 STA. 338+50 TO 344+50, SOLID LT & RT

TEMPORARY 4 INCH YELLOW LINE, PAINT
 (ALL LINES WILL INCLUDE C BREAKS FOR SIDE ROADS)
 STA. 338+50 TO 344+50, SOLID LT & RT

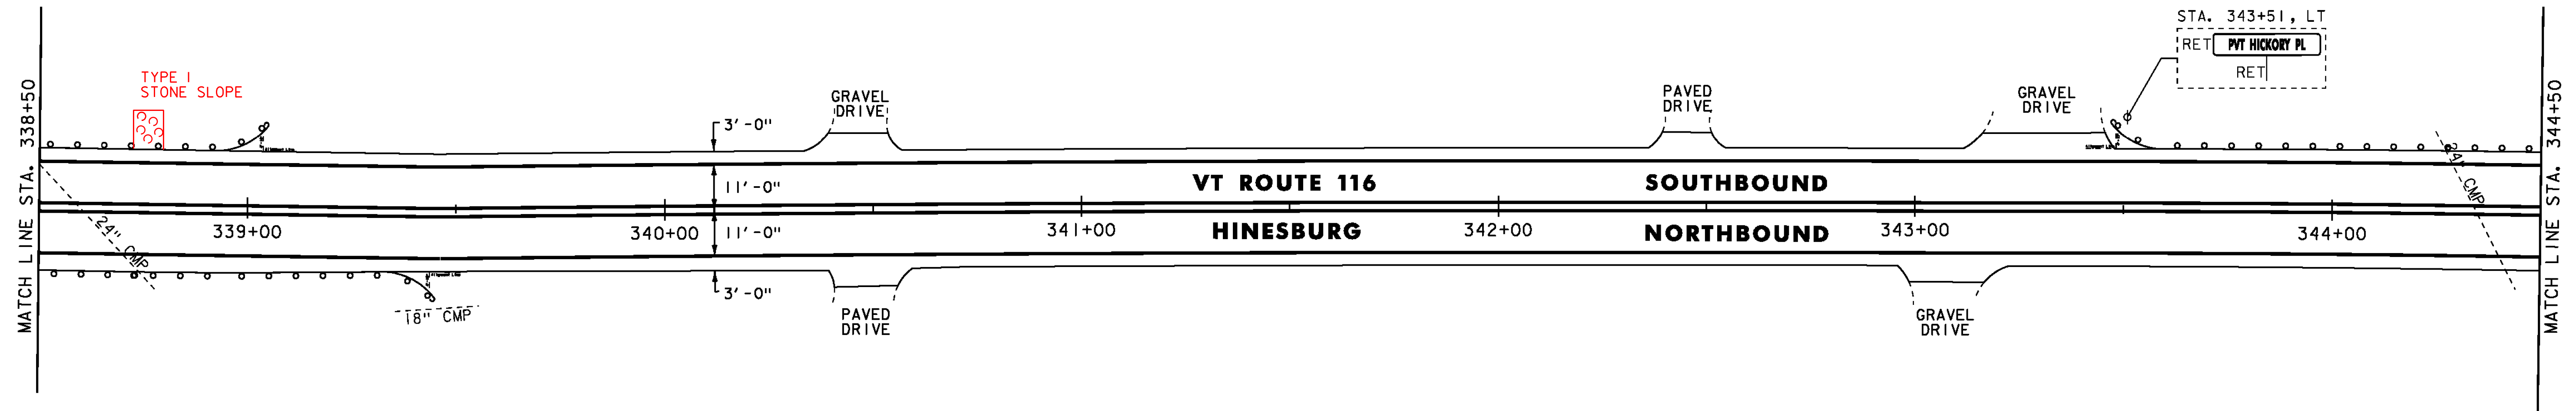

STEEL BEAM GUARDRAIL, GALVANIZED
 STA. 344+50 TO 346+47, LT
ANCHOR FOR STEEL BEAM RAIL
 STA. 346+47, LT


REMOVAL AND DISPOSAL OF GUARDRAIL
 STA. 344+50 TO 346+46, LT

DURABLE 4 INCH WHITE LINE
 (ALL LINES WILL INCLUDE EDGE LINE BREAKS AND
 RADII FOR SIDE ROADS)
 STA. 344+50 TO 350+50, SOLID LT & RT

DURABLE 4 INCH YELLOW LINE
 (ALL LINES WILL INCLUDE C BREAKS FOR SIDE ROADS)
 STA. 344+50 TO 350+50, SOLID LT & RT

TEMPORARY 4 INCH WHITE LINE, PAINT
 (ALL LINES WILL INCLUDE EDGE LINE BREAKS AND
 RADII FOR SIDE ROADS)
 STA. 344+50 TO 350+50, SOLID LT & RT

TEMPORARY 4 INCH YELLOW LINE, PAINT
 (ALL LINES WILL INCLUDE C BREAKS FOR SIDE ROADS)
 STA. 344+50 TO 350+50, SOLID LT & RT

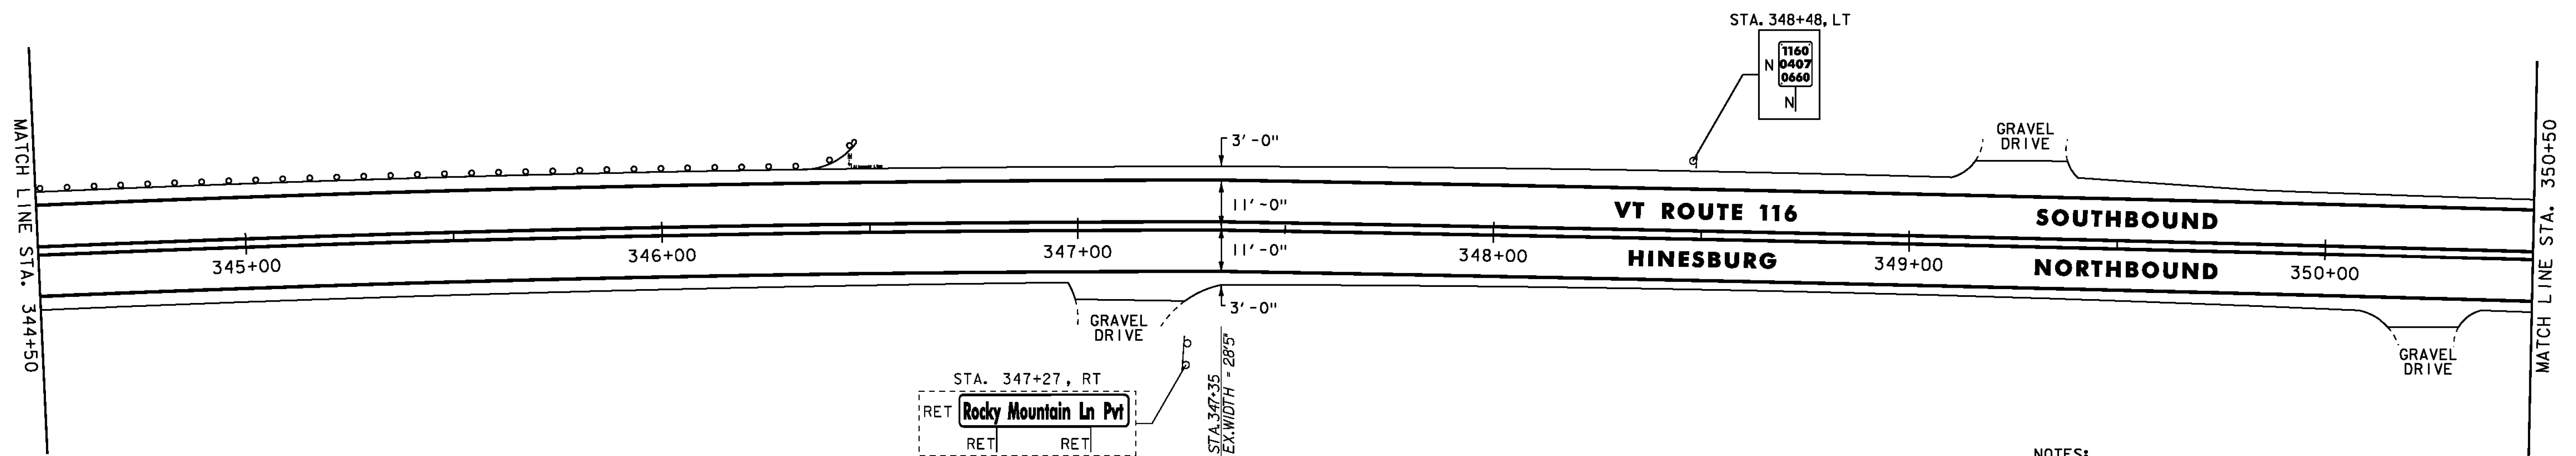

- NOTES:
 1. FOR LEGENDS, SEE SHEET 21.
 2. ALL EXISTING SIGNS NOT SHOWN SHALL BE RETAINED.
 3. SEE QUANTITY SHEETS FOR DURABLE PAVEMENT MARKING OPTIONS.

NOT TO SCALE

PROJECT LAYOUT SHEET #60



PROJECT NAME: STARKSBORO-HINESBURG
 PROJECT NUMBER: STP 2930(I)

FILE NAME: p10b266.dgn
 PROJECT LEADER: JLL
 DESIGNED BY: STANTEC
 IPARM FILE: p10b266160.i

PLOT DATE: 28-NOV-2012
 DRAWN BY: STANTEC
 CHECKED BY: MCF
 SHEET 80 OF 119