


DURABLE 4 INCH WHITE LINE
 (ALL LINES WILL INCLUDE EDGE LINE BREAKS AND
 RADII FOR SIDE ROADS)
 STA. 374+50 TO 379+50, SOLID LT & RT

DURABLE 4 INCH YELLOW LINE
 (ALL LINES WILL INCLUDE @ BREAKS FOR SIDE ROADS)
 STA. 374+50 TO 379+50, SOLID LT & RT

TEMPORARY 4 INCH WHITE LINE, PAINT
 (ALL LINES WILL INCLUDE EDGE LINE BREAKS AND
 RADII FOR SIDE ROADS)
 STA. 374+50 TO 379+50, SOLID LT & RT

TEMPORARY 4 INCH YELLOW LINE, PAINT
 (ALL LINES WILL INCLUDE @ BREAKS FOR SIDE ROADS)
 STA. 374+50 TO 379+50, SOLID LT & RT

REMOVING SIGNS
 AS SHOWN - 1

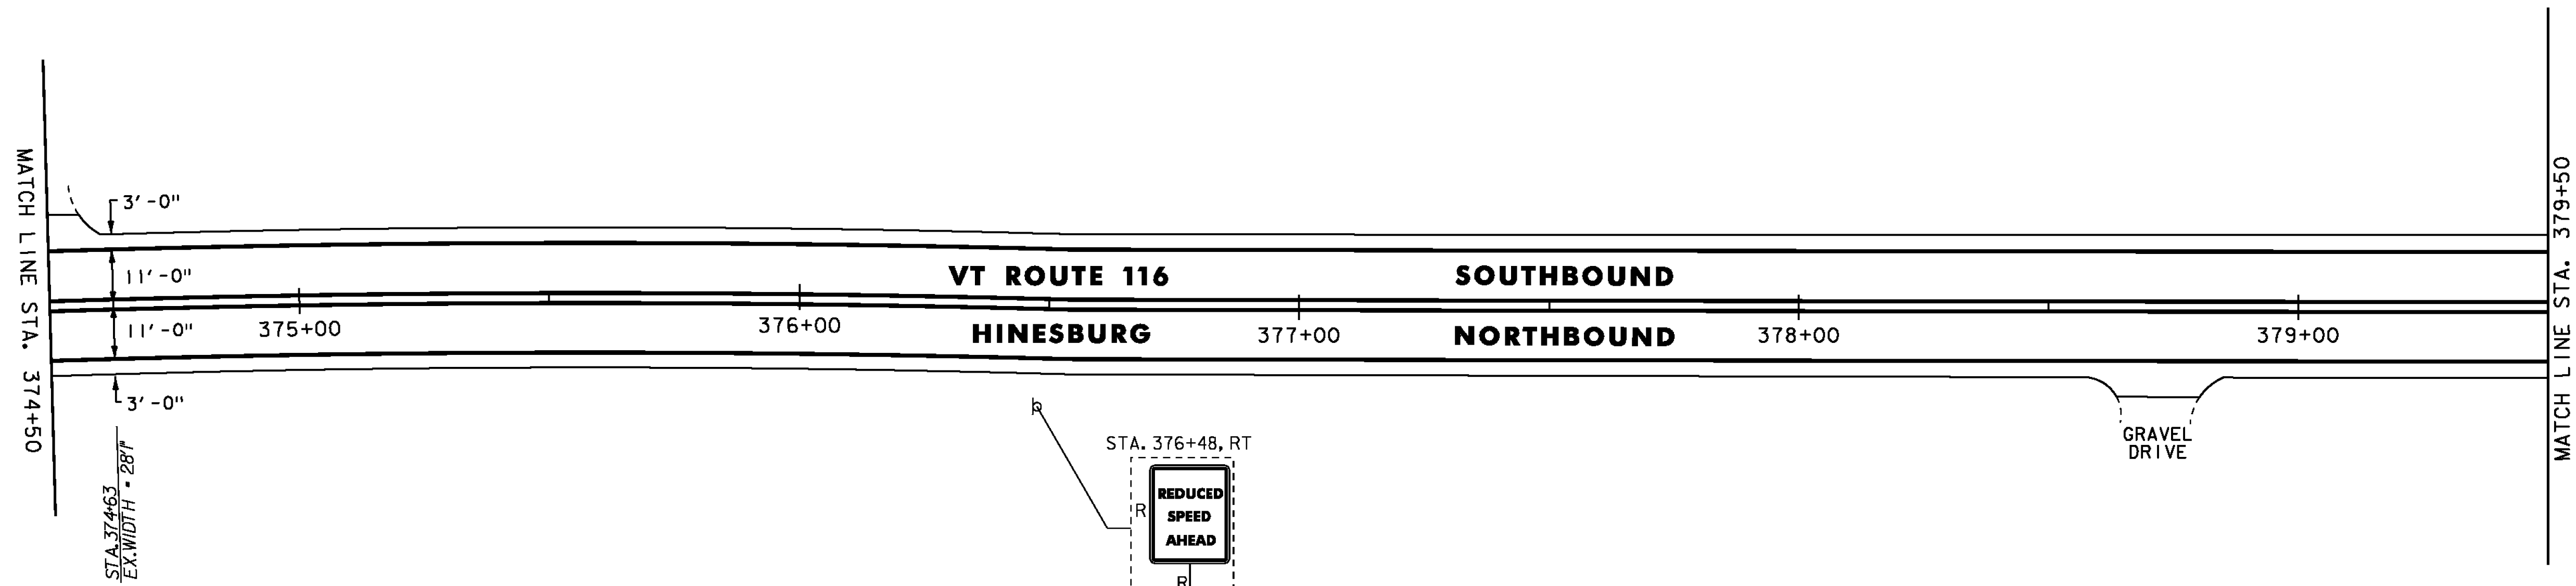

DURABLE 4 INCH WHITE LINE
 (ALL LINES WILL INCLUDE EDGE LINE BREAKS AND
 RADII FOR SIDE ROADS)
 STA. 379+50 TO 381+69.12, SOLID LT & RT


DURABLE 4 INCH YELLOW LINE
 (ALL LINES WILL INCLUDE @ BREAKS FOR SIDE ROADS)
 STA. 379+50 TO 381+69.12, SOLID LT & RT

TEMPORARY 4 INCH WHITE LINE, PAINT
 (ALL LINES WILL INCLUDE EDGE LINE BREAKS AND
 RADII FOR SIDE ROADS)
 STA. 379+50 TO 381+69.12, SOLID LT & RT


TEMPORARY 4 INCH YELLOW LINE, PAINT
 (ALL LINES WILL INCLUDE @ BREAKS FOR SIDE ROADS)
 STA. 379+50 TO 381+69.12, SOLID LT & RT

REMOVING SIGNS
 AS SHOWN - 4

VT ROUTE 116 END PROJECT LOCATION TIES

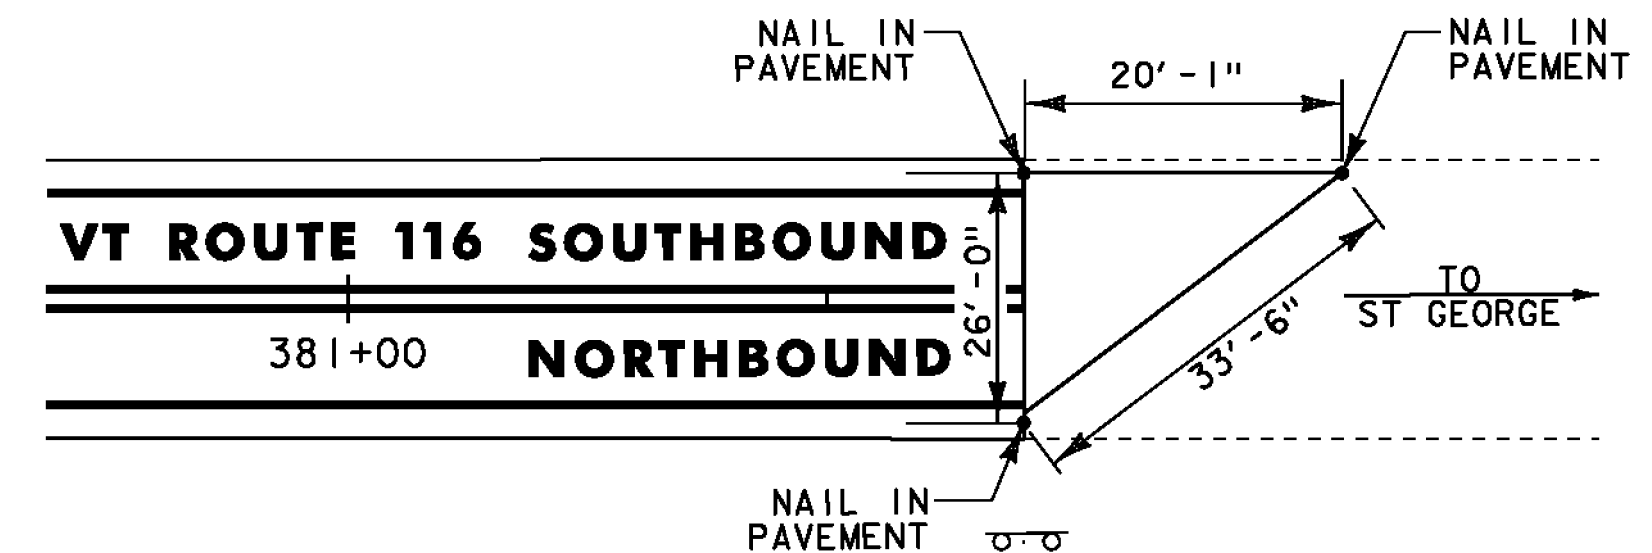

**END STP 2930(1) VT ROUTE 116
 HINESBURG STA. 381+69.12 = MM 7.229**

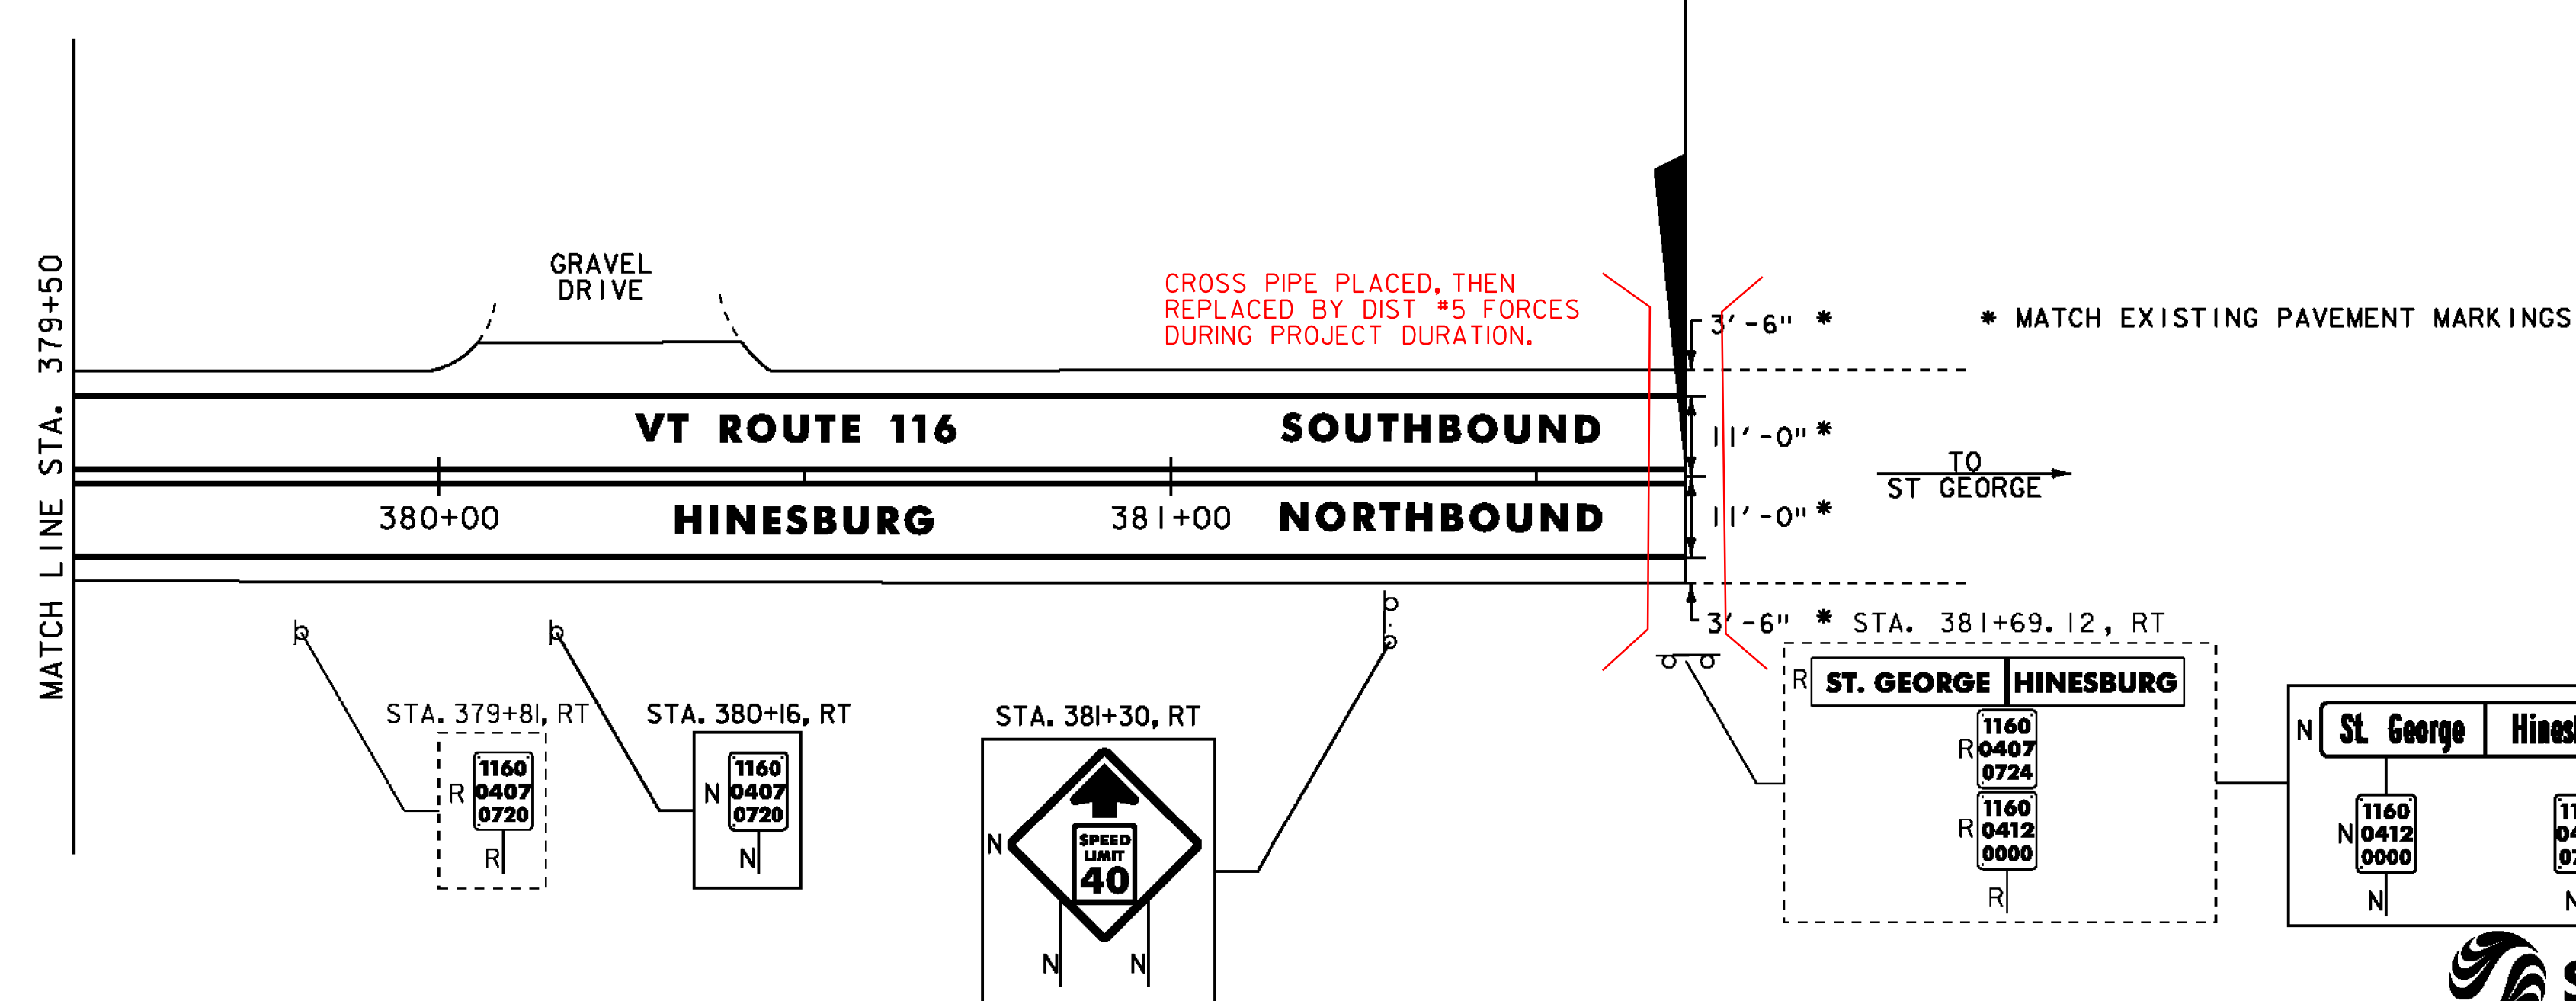

- NOTES:
 1. FOR LEGENDS, SEE SHEET 21.
 2. ALL EXISTING SIGNS NOT SHOWN SHALL BE RETAINED.
 3. SEE QUANTITY SHEETS FOR DURABLE PAVEMENT MARKING OPTIONS.

NOT TO SCALE

**PROJECT
 LAYOUT
 SHEET #63**

PROJECT NAME: STARKSBORO-HINESBURG
 PROJECT NUMBER: STP 2930(1)

FILE NAME: p10b266.dgn
 PROJECT LEADER: JLL
 DESIGNED BY: STANTEC
 IPARM FILE: p10b266163.i

PLOT DATE: 28-NOV-2012
 DRAWN BY: STANTEC
 CHECKED BY: MCF
 SHEET 83 OF 119

