




LOCATION: HINESBURG STA. 231+13, LT
 COLOR: WHITE BORDER AND TEXT (RETROREFLECTIVE)
 GREEN BACKGROUND (RETROREFLECTIVE)
 MATERIAL: PER THE TABLE ON SHEET I16

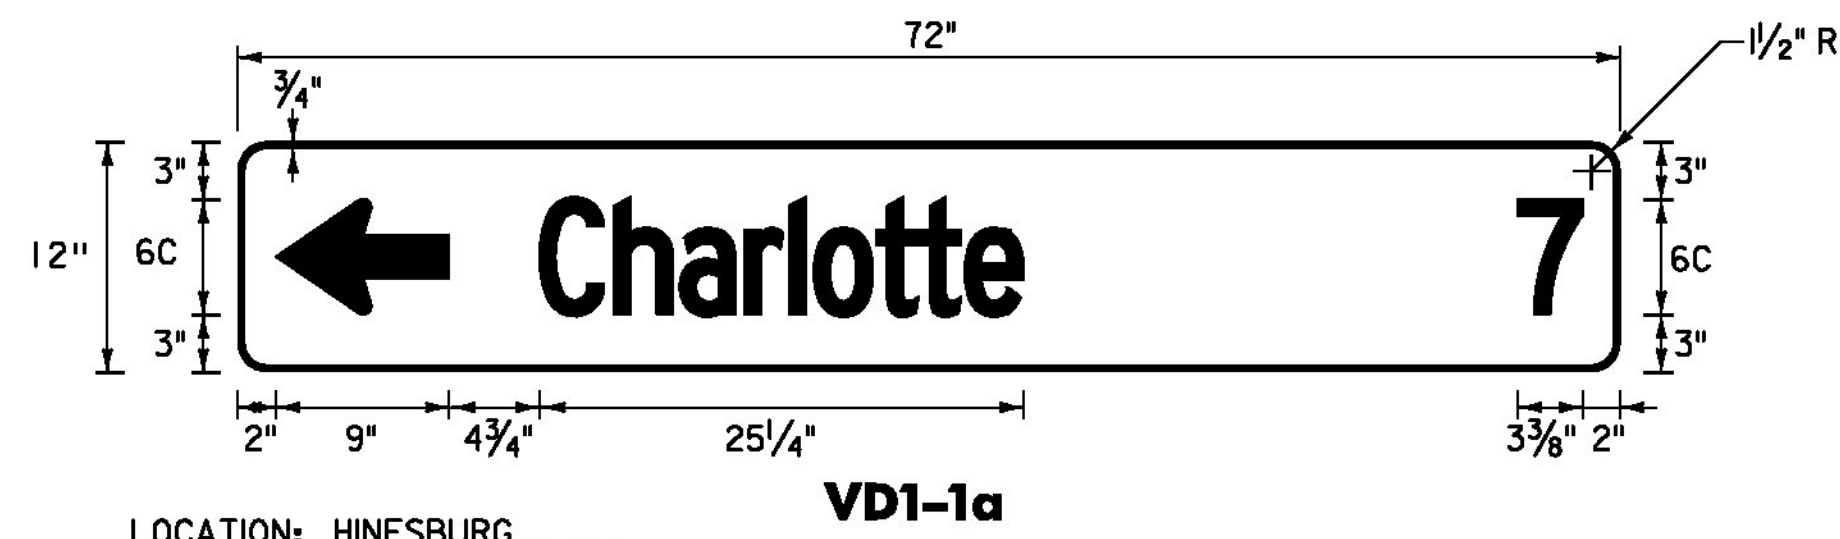


LOCATION: HINESBURG STA. 236+83, RT.
 COLOR: WHITE BORDER AND TEXT (RETROREFLECTIVE)
 GREEN BACKGROUND (RETROREFLECTIVE)
 MATERIAL: 0.125" FLAT SHEET ALUMINUM

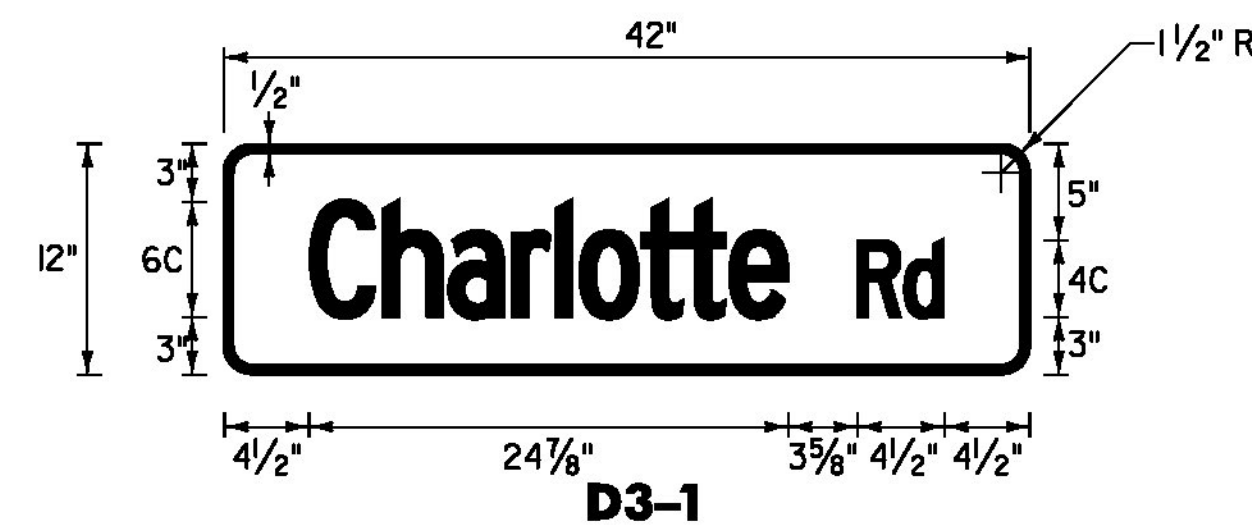


LOCATION: HINESBURG STA. 239+62, LT
 COLOR: WHITE BORDER AND TEXT (RETROREFLECTIVE)
 GREEN BACKGROUND (RETROREFLECTIVE)
 MATERIAL: PER THE TABLE ON SHEET I16

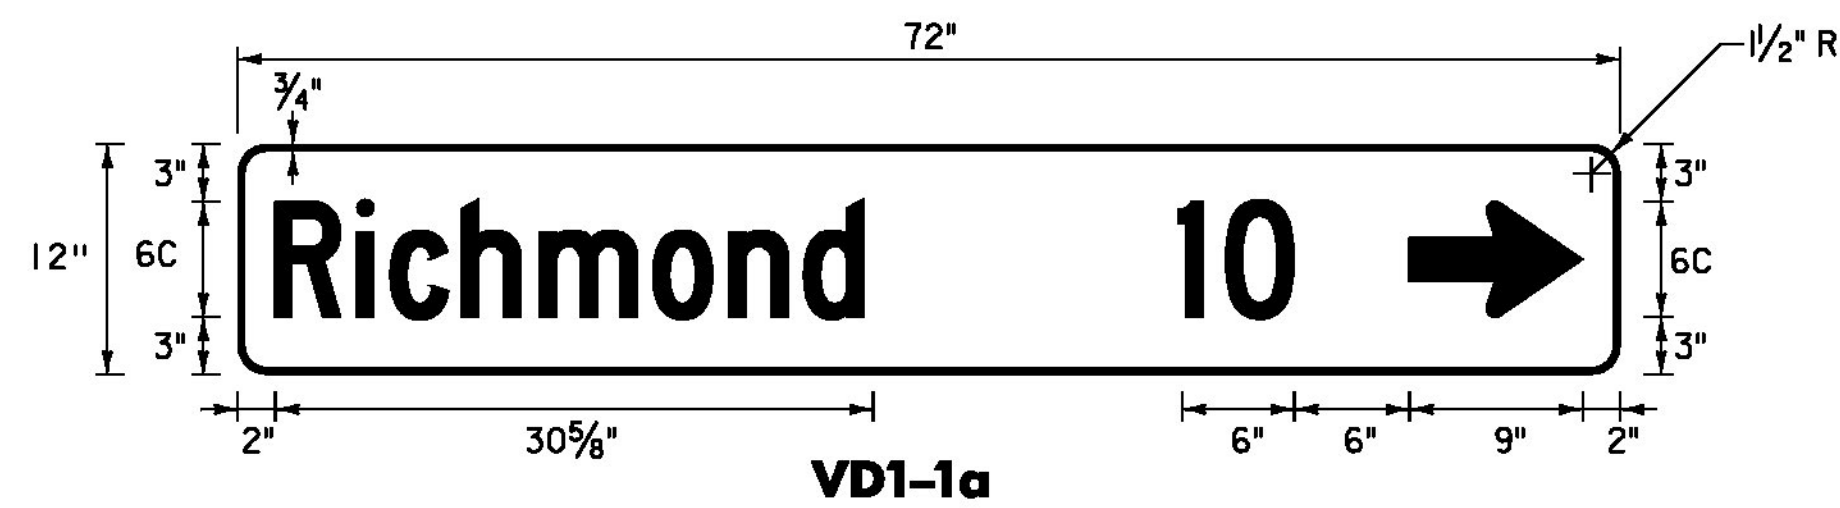


LOCATION: HINESBURG STA. 248+84, RT.
 COLOR: WHITE BORDER AND TEXT (RETROREFLECTIVE)
 GREEN BACKGROUND (RETROREFLECTIVE)
 MATERIAL: 0.125" FLAT SHEET ALUMINUM

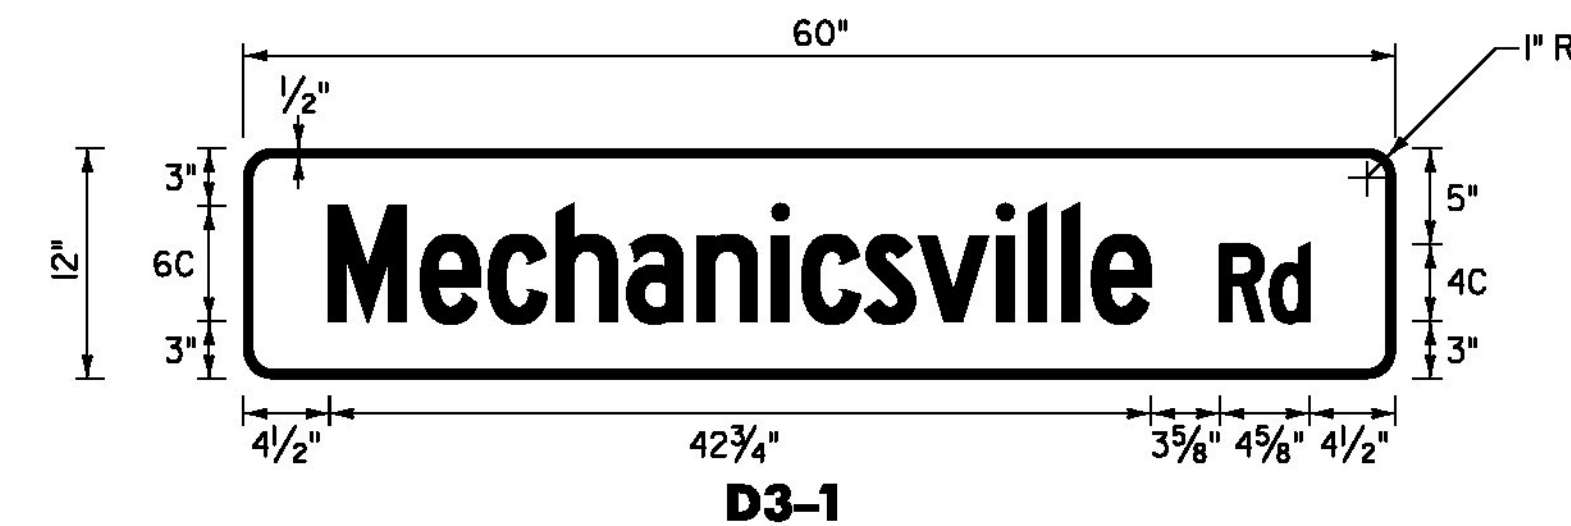


LOCATION: HINESBURG STA. 250+27, RT
 COLOR: WHITE BORDER AND TEXT (RETROREFLECTIVE)
 GREEN BACKGROUND (RETROREFLECTIVE)
 MATERIAL: PER THE TABLE ON SHEET I16

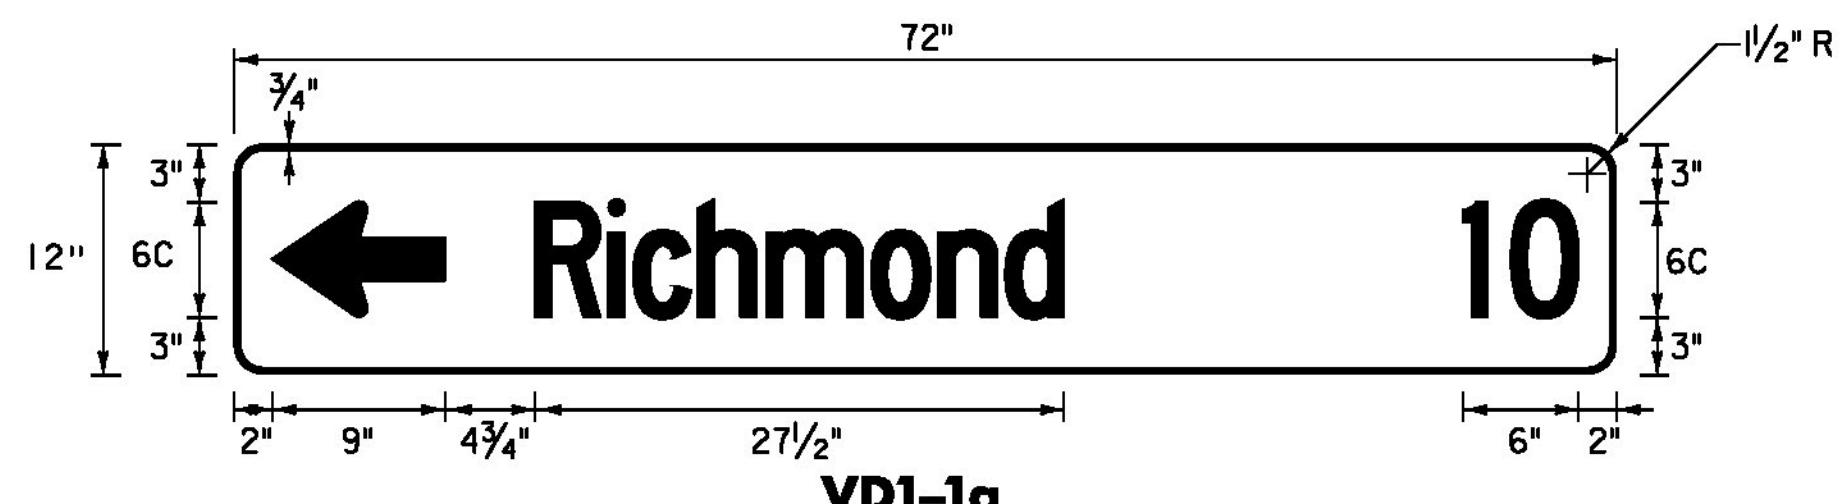


LOCATION: HINESBURG STA. 252+78, LT.
 COLOR: WHITE BORDER AND TEXT (RETROREFLECTIVE)
 GREEN BACKGROUND (RETROREFLECTIVE)
 MATERIAL: 0.125" FLAT SHEET ALUMINUM

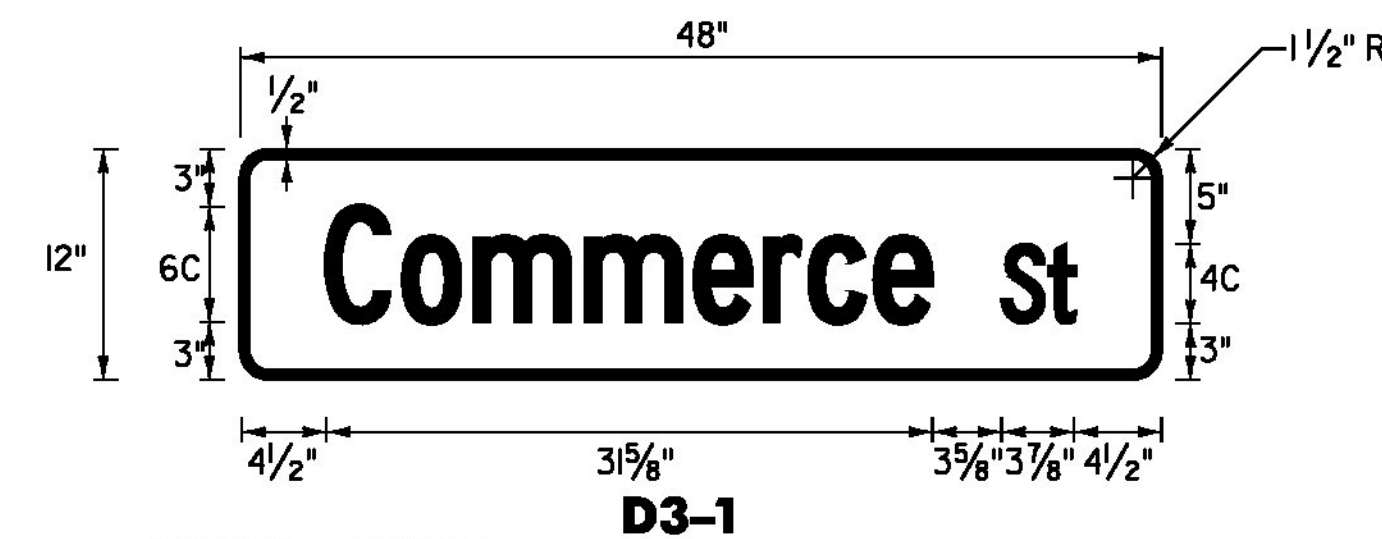


LOCATION: HINESBURG STA. 261+13, RT
 COLOR: WHITE BORDER AND TEXT (RETROREFLECTIVE)
 GREEN BACKGROUND (RETROREFLECTIVE)
 MATERIAL: PER THE TABLE ON SHEET I16

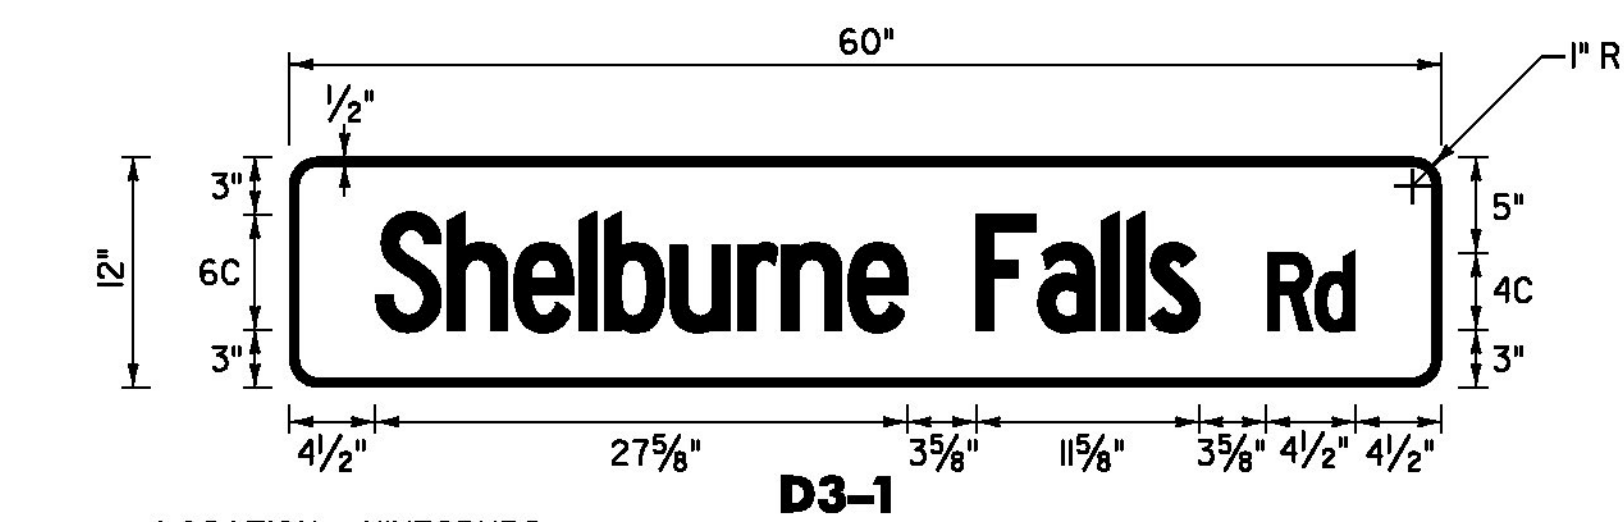


LOCATION: HINESBURG STA. 287+10, LT
 COLOR: WHITE BORDER AND TEXT (RETROREFLECTIVE)
 GREEN BACKGROUND (RETROREFLECTIVE)
 MATERIAL: PER THE TABLE ON SHEET I16

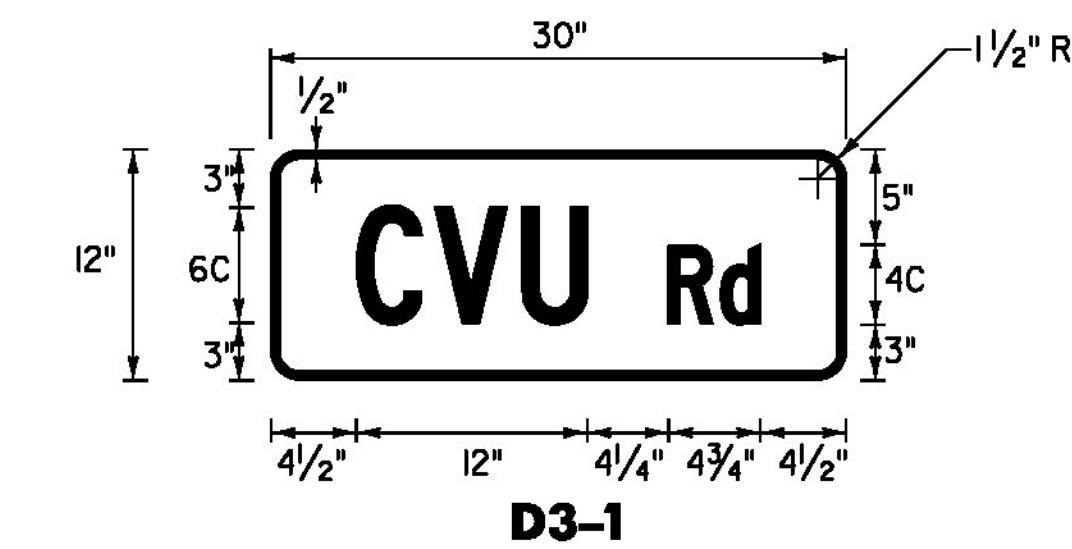


LOCATION: HINESBURG STA. 287+78, RT
 COLOR: WHITE BORDER AND TEXT (RETROREFLECTIVE)
 GREEN BACKGROUND (RETROREFLECTIVE)
 MATERIAL: PER THE TABLE ON SHEET I16

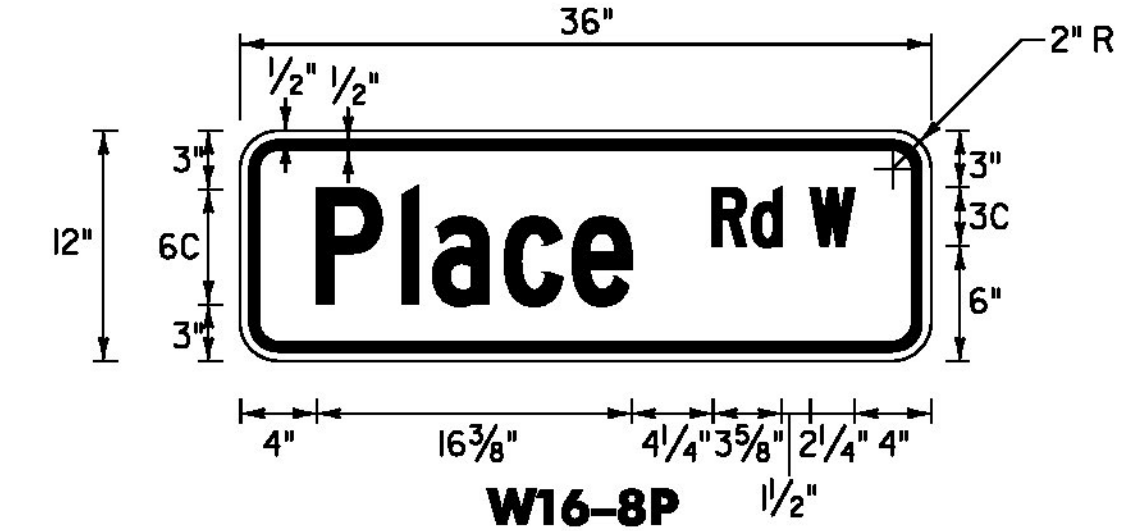

LOCATION: HINESBURG STA. 313+00, RT
 STA. 318+10, LT
 COLOR: BLACK BORDER AND TEXT (RETROREFLECTIVE)
 YELLOW BACKGROUND (RETROREFLECTIVE)
 MATERIAL: PER THE TABLE ON SHEET I16

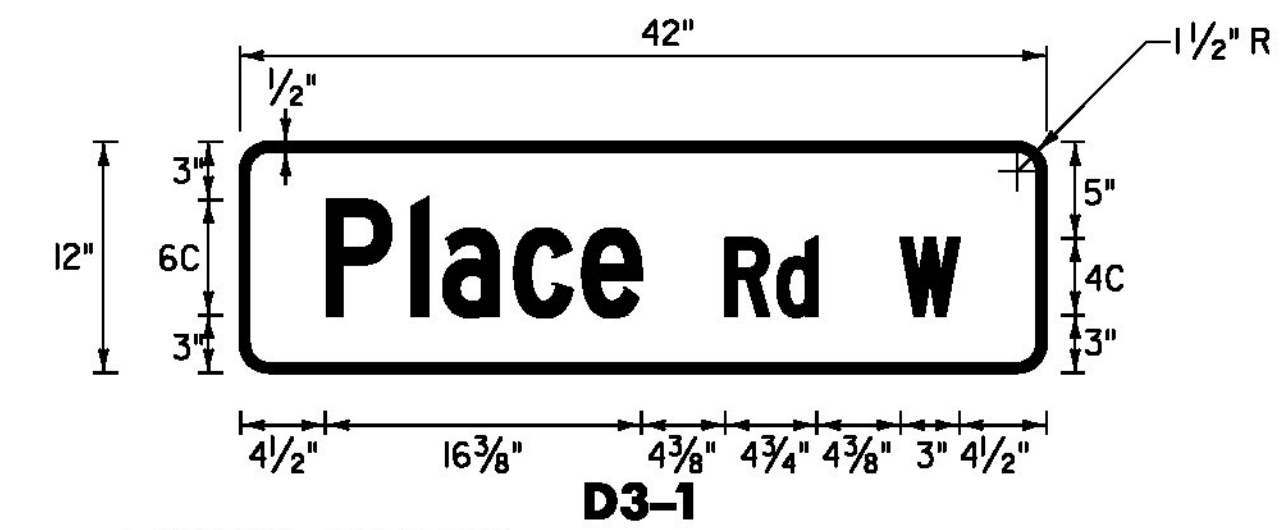

LOCATION: HINESBURG STA. 315+78, RT
 COLOR: WHITE BORDER AND TEXT (RETROREFLECTIVE)
 GREEN BACKGROUND (RETROREFLECTIVE)
 MATERIAL: PER THE TABLE ON SHEET I16

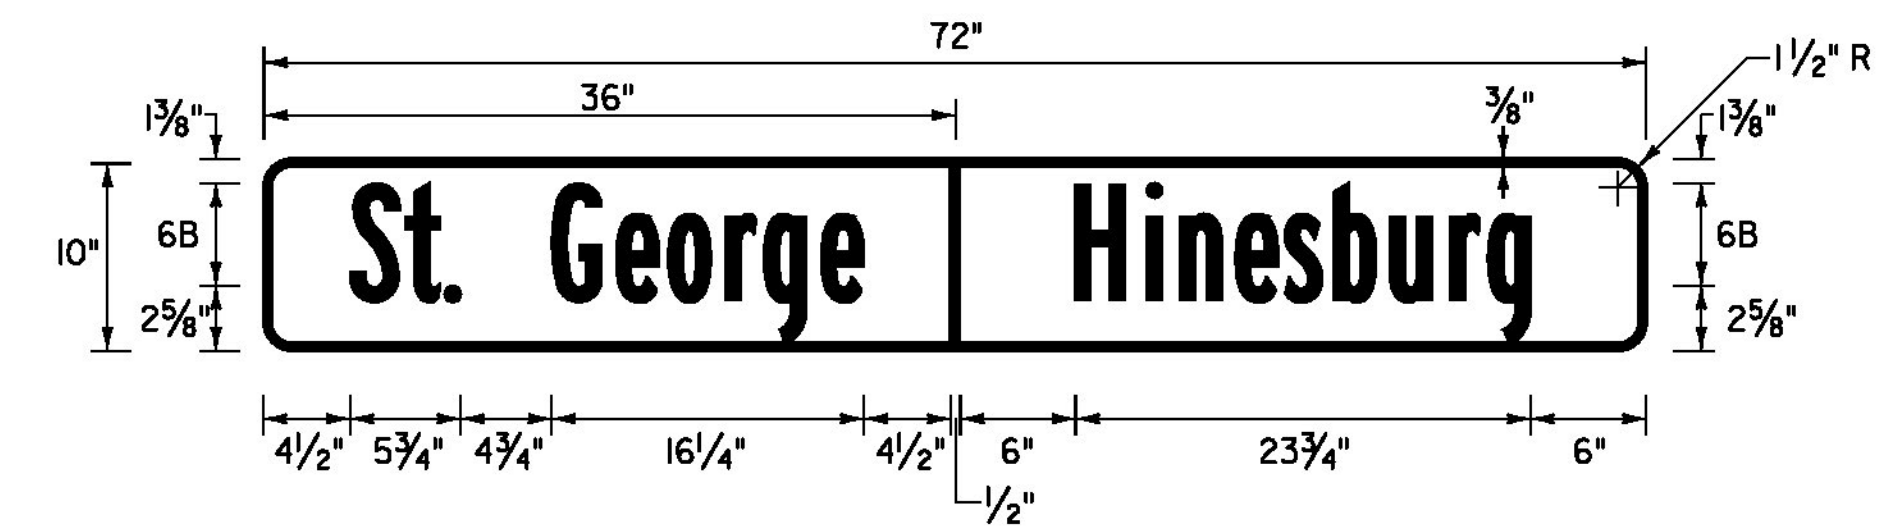

LOCATION: HINESBURG STA. 381+69, RT
 COLOR: WHITE DIVIDER AND TEXT (RETROREFLECTIVE)
 GREEN BACKGROUND (RETROREFLECTIVE)
 MATERIAL: PER THE TABLE ON SHEET I16

NOT TO SCALE

**TRAFFIC SIGN
 DETAIL
 SHEET #3**



NOTES:
 1. ALL SHEETING SHALL BE ASTM D 4956 TYPE III MINIMUM PER 750.08.
 2. ALL STREET NAME SIGNS ARE TWO SIDED UNLESS OTHERWISE NOTED.

PROJECT NAME: STARKSBORO-HINESBURG	PLOT DATE: 28-NOV-2012
PROJECT NUMBER: STP 2930(I)	DRAWN BY: STANTEC
FILE NAME: p10b266.dgn	DESIGNED BY: STANTEC
PROJECT LEADER: JLL	CHECKED BY: MCF
IPARM FILE: p10b266tsds03.1	SHEET I14 OF I19