
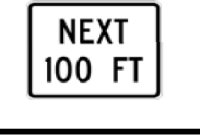



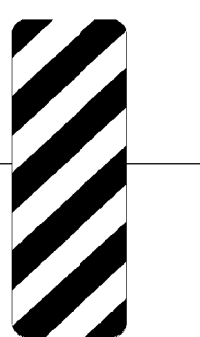
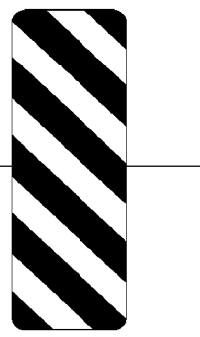



DIRECTION	MILEPOINT	LOCATION CODE (SHEET 2)	SIGN CODE	WIDTH (IN)	HEIGHT (IN)	SHEETING REMARKS	SIGN LEGEND	NEW SIGNS		EXISTING SIGNS				EXIST POST		NUMBER OF NEW POSTS	SQUARE STEEL (IN)			TUBULAR STEEL Ø (IN)				SIGN FRAME REQUIRED	REMARKS	SIGN DETAIL LOCATION				
								"A"	"B"	RETAIN	SALVAGE FROM	SALVAGE TO	REMOVE	RETAIN	REMOVE		1.75	2.00	2.50	FOUNDATION	3.0	3.50	4.00			5.00	SHSM	PROJECT SHEET #	STANDARD SHEET #	
																	(LB / FT)				(LB / FT)									
WOODFORD EB							FY-FLUORESCENT YELLOW FYG-FLUORESCENT YELLOW GREEN																"SHSM"-STANDARD HIGHWAY SIGNS AND MARKINGS							
		A	W11-2	30	30	FYG		6.25										X								X				
		A	W16-4P	30	24	FYG		5.00																			X			
EB	2.590	A	R2-1	24	30								1																PLACED SIGN ON 8-30, COUNTED ON 8-29	
		A	R2-1	24	30			5.00										X								X				
EB	2.735	A	VW-285	30	30		FALLING ROCK SYMBOL						1																	
EB	2.792	C	VR-017	24	30								1	X	X														NOTCH RD (TH-4)	
		C	VR-017	24	30			5.00																					RETAIN POST	
EB	2.792	D	R1-1	30	30																									NOTCH RD (TH-4)
		D	R1-1	30	30			6.25										X								X			STREET SIGN R/S	
EB	2.801	A	OM3-R	12	36																									
		A	OM3-R	12	36			3.00																					RETAIN ANCHOR	
EB	2.853	B	OM3-L	12	36																									R/S TWO PLAQUES
		B	OM3-L	12	36			3.00																			X		RETAIN POST	
EB	2.866	A	VW-285	30	30			6.25																						INSTALL 50 FEET WEST OF LARGE ARROW.
EB	2.883	B	W1-6	48	24		RIGHT LARGE ARROW																							
SIGN SUMMARY SHEET							SHEET TOTALS	39.75	0.00	1	3	3	9	0	0	7	105	0	0.0	0.0	0.0	0.0	0.0	PROJECT NAME: WOODFORD-MARLBORO						
VERMONT AGENCY OF TRANSPORTATION							TOWN DIRECTIONAL TOTALS	310.4	0.0	28.0	0.0	0.0	61	0.0	0.0	52	780.0	0		0.0				PROJECT NUMBER: STPG SIGN(35)						
																							FILE NAME: 10B336							
																							PLOT DATE: 4/10/2012							
																							PROJECT MANAGER: A. GAMBLE							
																						DESIGNED BY: J. KELLY								
																						WOODFORD EB SHEET 4								
																						CHECKED BY: A. GAMBLE								
																							SHEET 13 OF 80							