






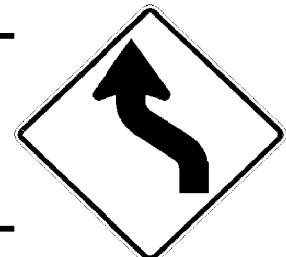


DIRECTION	MILEPOINT	LOCATION CODE (SHEET 2)	SIGN CODE	WIDTH (IN)	HEIGHT (IN)	SHEETING REMARKS	SIGN LEGEND	NEW SIGNS		EXISTING SIGNS				EXIST POST		NUMBER OF NEW POSTS	SQUARE STEEL (IN)			TUBULAR STEEL Ø (IN)				SIGN FRAME REQUIRED	REMARKS	SIGN DETAIL LOCATION			
								"A"	"B"	RETAIN	SALVAGE FROM	SALVAGE TO	REMOVE	RETAIN	REMOVE		1.75	2.00	2.50	FOUNDATION	3.0	3.50	4.00			5.00	SHSM	PROJECT SHEET #	STANDARD SHEET #
																	(LB / FT)				(LB / FT)								
WOODFORD EB							FY-FLUORESCENT YELLOW FYG-FLUORESCENT YELLOW GREEN															"SHSM"-STANDARD HIGHWAY SIGNS AND MARKINGS							
		A	R2-1	24	30		 	5.00										X						X	R/S MM				
EB	5.512	A	VW-060	30	30		HIDDEN DRIVES						1																
EB	5.526	A	VW-060	30	30			6.25											X							8			
EB	5.802	A	M3-2	24	12			2.00											X							E-136B			
		A	M1-5	24	24			4.00																	E-136B				
EB	5.808	A	M3-2	24	12		EAST						1																
		A	M1-5	24	24		VERMONT ROUTE 9						1																
EB	5.911	A	VW-205	36	36								1																
		A	VW-205	36	36	FY		9.00											X						8				
EB	5.994	A	S3-1	30	30		SCHOOL BUS STOP AHEAD						1																
		A	S3-1	36	36	FYG	 	9.00										X						X					
EB	6.371	A	W1-4L	30	30		LEFT REVERSE CURVE						1																
EB	6.447	A	W1-4L	30	30			6.25											X										
EB	6.540	A	VW-054R	30	30		HIDDEN DRIVE RIGHT						1																
EB	6.785	A	VW-054R	30	30								1																
SIGN SUMMARY SHEET							SHEET TOTALS	41.50	0.00	0	2 0	2 0	10 8	0	0	8	120	0	0.0	0.0	0.0	0.0	0.0	PROJECT NAME: WOODFORD-MARLBORO					
								SF	SF	EA	EA	EA	EA	EA	EA	EA	FT	EA	LB	LB	LB	LB	PROJECT NUMBER: STPG SIGN(35)						
							TOWN DIRECTIONAL TOTALS	310.4	0.0	28.0	0.0	0.0	61	0.0	0.0	52	780.0	0			0.0			FILE NAME: 10B336 PLOT DATE: 4/10/2012					
																							PROJECT MANAGER: A. GAMBLE DRAWN BY: J. KELLY						
																						DESIGNED BY: J. KELLY CHECKED BY: A. GAMBLE							
																						WOODFORD EB SHEET 7 SHEET 16 OF 80							