



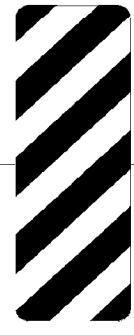

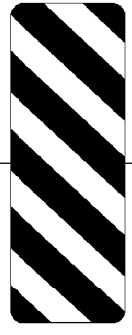


DIRECTION	MILEPOINT	LOCATION CODE (SHEET 2)	SIGN CODE	WIDTH (IN)	HEIGHT (IN)	SHEETING REMARKS	SIGN LEGEND	NEW SIGNS		EXISTING SIGNS				EXIST POST		NUMBER OF NEW POSTS	SQUARE STEEL (IN)			TUBULAR STEEL Ø (IN)				SIGN FRAME REQUIRED	REMARKS	SIGN DETAIL LOCATION									
								"A"	"B"	RETAIN	SALVAGE FROM	SALVAGE TO	REMOVE	RETAIN	REMOVE		1.75	2.00	2.50	FOUNDATION	3.0	3.50	4.00			5.00	SHSM	PROJECT SHEET #	STANDARD SHEET #						
																	(LB / FT)				(LB / FT)														
WOODFORD WB							FY-FLUORESCENT YELLOW FYG-FLUORESCENT YELLOW GREEN																"SHSM"-STANDARD HIGHWAY SIGNS AND MARKINGS												
WB	3.100	F	VW-285	30	30		FALLING ROCK			1					X																				
WB	2.843	F	OM-3R	12	36								1	X	X																				
		F	OM3-R	12	36			3.00																											
WB	2.793	E	OM-3L	12	36								1		X																				
		E	OM3-L	12	36			3.00																											
WB	2.680	F	W11-2	30	30																														
		F	W16-9	24	10																														
		F	W11-2	30	30	FYG		6.25																											
		F	W16-9P	24	10 ¹²	FYG		1.67 ^{2.00}																											
WB	2.570	F	W11-2	30	30																														
		F	W16-7	24	12		DIAGONAL ARROW																												
		F	W11-2	30	30	FYG		6.25																											
		A	W16-4P	30	24	FYG		5.00																											
WB	2.534	F	D4-1R	30	24			5.00																											
WB	2.519	F	D4-1	30	24		PARKING RIGHT ARROW																												
SIGN SUMMARY SHEET							SHEET TOTALS	30.50 ^{30.17}	0.00	1	0	0	7	0	0	5	75	0	0.0	0.0	0.0	0.0	0.0		PROJECT NAME: WOODFORD-MARLBORO										
								SF	SF	EA	EA	EA	EA	EA	EA	EA	FT	EA	LB	LB	LB	LB	LB		PROJECT NUMBER: STPG SIGN(35)										
																									FILE NAME: 10B336										
VERMONT AGENCY OF TRANSPORTATION							TOWN DIRECTIONAL TOTALS	260.8	0.0	9.0	4.0	4.0	60	0.0	0.0	48	720.0	0			0.0				PLOT DATE: 4/10/2012										
																								DRAWN BY: J. KELLY											
																								DESIGNED BY: J. KELLY											
																								CHECKED BY: A. GAMBLE											
																								WOODFORD WB SHEET 5											
																								SHEET 25 OF 80											