
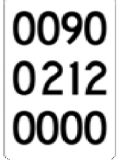
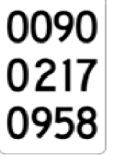







DIRECTION	MILEPOINT	LOCATION CODE (SHEET 2)	SIGN CODE	WIDTH (IN)	HEIGHT (IN)	SHEETING REMARKS	SIGN LEGEND	NEW SIGNS		EXISTING SIGNS				EXIST POST		NUMBER OF NEW POSTS	SQUARE STEEL (IN)			TUBULAR STEEL Ø (IN)				SIGN FRAME REQUIRED	REMARKS	SIGN DETAIL LOCATION			
								"A"	"B"	RETAIN	SALVAGE FROM	SALVAGE TO	REMOVE	RETAIN	REMOVE		1.75	2.00	2.50	FOUNDATION	3.0	3.50	4.00			5.00	SHSM	PROJECT SHEET #	STANDARD SHEET #
																	(LB / FT)				(LB / FT)								
<b>SEARSBURG EB</b>							FY-FLUORESCENT YELLOW FYG-FLUORESCENT YELLOW GREEN															"SHSM"-STANDARD HIGHWAY SIGNS AND MARKINGS							
EB	0.000	C	VD-024	60	7.5							1		X															
		C	VD-024	72	10			5.00									X									4			
		C	VD-700	6	10			0.42																INSTALL ON LEFT POST BELOW SEARSBURG	R MM		E-138		
		C	VD-700	6	10			0.42																INSTALL ON RIGHT POST BELOW WOODFORD	R MM		E-138		
EB	0.485	C	VR-017	24	30							1		X										OLD ROUTE 9 (TH-6)					
		C	VR-017	24	30			5.00									X									7			
EB	0.495	D	R1-1	30	30							1		X										OLD ROUTE 9 (TH-6) R/S			REMOVED SIGN FROM NEW POST AND PUT ON SAME POST AS STOP SIGN AT SEARSBURG ROAD SUPT REQUEST.		
		D	R1-1	30	30			6.25									X								X				
EB	0.761	C	VR-017	24	24							1	X	X										OLD ROUTE 9 (TH-6)					
		C	VR-017	24	30			5.00									X									7			
EB	0.770	D	R1-1	30	30							1	X	X										OLD ROUTE 9 (TH-6)					
		D	R1-1	30	30			6.25									X								X				
EB	0.795	A	M3-2	24	12							1																	
		A	M1-5	24	24							1		X															
		A	M3-2	24	12			2.00									X										E-136B		
<b>SIGN SUMMARY SHEET</b>							<b>SHEET TOTALS</b>	30.34	0.00	0	3	3	12	0	0	7	105	0	0.0	0.0	0.0	0.0	0.0	PROJECT NAME: <b>WOODFORD-MARLBORO</b>					
VERMONT AGENCY OF TRANSPORTATION							<b>TOWN DIRECTIONAL TOTALS</b>	130.8	0.0	29.0	18.0	18.0	41	0.0	0.0	28	420.0	0		0.0				PROJECT NUMBER: <b>STPG SIGN(35)</b>					
																							FILE NAME: <b>10B336</b>						
																							PLOT DATE: <b>4/10/2012</b>						
																							DRAWN BY: <b>J. KELLY</b>						
																							DESIGNED BY: <b>J. KELLY</b>						
																							CHECKED BY: <b>A. GAMBLE</b>						
																							SEARSBURG EB SHEET 1						
																							SHEET <b>30</b> OF <b>80</b>						