
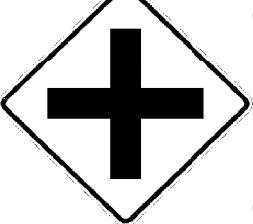






DIRECTION	MILEPOINT	LOCATION CODE (SHEET 2)	SIGN CODE	WIDTH (IN)	HEIGHT (IN)	SHEETING REMARKS	SIGN LEGEND	NEW SIGNS		EXISTING SIGNS				EXIST POST		NUMBER OF NEW POSTS	SQUARE STEEL (IN)			TUBULAR STEEL Ø (IN)				SIGN FRAME REQUIRED	REMARKS	SIGN DETAIL LOCATION			
								"A"	"B"	RETAIN	SALVAGE FROM	SALVAGE TO	REMOVE	RETAIN	REMOVE		1.75	2.00	2.50	FOUNDATION	3.0	3.50	4.00			5.00	SHSM	PROJECT SHEET #	STANDARD SHEET #
																	(LB / FT)				(LB / FT)								
SEARSBURG EB							FY-FLUORESCENT YELLOW FYG-FLUORESCENT YELLOW GREEN															"SHSM"-STANDARD HIGHWAY SIGNS AND MARKINGS							
EB	3.198	A	VW-092	36	36			9.00										X						INSTALL 150 EAST OF EXISTING CROSSROAD SIGN ASSEMBLY.		8			
EB	3.270	A	W2-1	36	36			9.00											X					INSTALL 50 FEET EAST OF BREAK IN GUARDRAIL	X				
EB	3.357	C	VR-017	24	30							1												SLEEPY HOLLOW RD. (TH-3)					
		C	VR-017	24	30			5.00											X					USED NEW POST REMOVED FROM EB 0.485 AND PAID THERE		7			
		C		30	30		DEAD END (TOWN-OWNED) NOW "NO OUTLET"																	REINSTALL TOWN'S DEAD END SIGN 50 FEET FURTHER UP TOWN HIGHWAY ON A SEPARATE POST.			TOWN HAS PUT IN "NO OUTLET" SIGN		
EB	3.361	D	R1-1	30	30							1												SLEEPY HOLLOW RD. (TH-3)					
		D	R1-1	30	30			6.25																	REINSTALL ABOVE NEW STOP SIGN USING 90 DEG. BRACKET.	X		RETAINED POST	
		D	D3-1				STREET NAME SIGN (TOWN-OWNED)																					RETAIN POST	
EB	3.402	A	M3-2	24	12							1													RETAIN FLANGED CHANNEL POST				
		A	M1-5	24	24							1																	
		A	M3-2	24	12			2.00																					E-136B
		A	M1-5	24	24			4.00																					E-136B
		A	VM-120	18	24		MOLLY STARK BYWAY				1														RETAIN BYWAY SIGN.				
EB	3.510	A	R2-1	24	30							1													RETAIN FLANGED CHANNEL POST.			OLD POST DAMAGED	
		A	R2-1	24	30			5.00																			X		
SIGN SUMMARY SHEET							SHEET TOTALS	40.25	0.00	1	0	0	5	0	0	7	105	0	0.0	0.0	0.0	0.0	0.0	PROJECT NAME: WOODFORD-MARLBORO					
								SF	SF	EA	EA	EA	EA	EA	EA	EA	EA	EA	EA	EA	EA	EA	PROJECT NUMBER: STPG SIGN(35)						
																							FILE NAME: 10B336						
VERMONT AGENCY OF TRANSPORTATION							TOWN DIRECTIONAL TOTALS	130.8	0.0	29.0	18.0	18.0	41	0.0	0.0	28	420.0	0		0.0				PLOT DATE: 4/10/2012					
																							DRAWN BY: J. KELLY						
																							CHECKED BY: A. GAMBLE						
																							SEARSBURG EB SHEET 6						
																							SHEET 35 OF 80						